


CANYON VIEW
DRIVE - 60'

CURVE "A"
 $\Delta = 1011.02'$
 $R = 470.00'$
 $L = 83.54'$

S/L 45
Vacant


S/L 47
Vacant

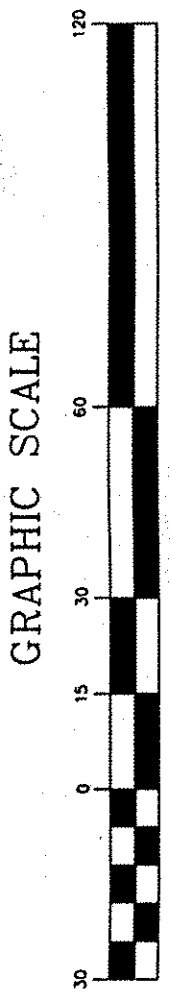

(IN FEET)
1 inch = 30 ft.

LEGEND

- Monument Box
- Iron Pin Found
- Catch Basin
- Manhole
- Light Pole
- Electrical Box
- Telephone Pedestal

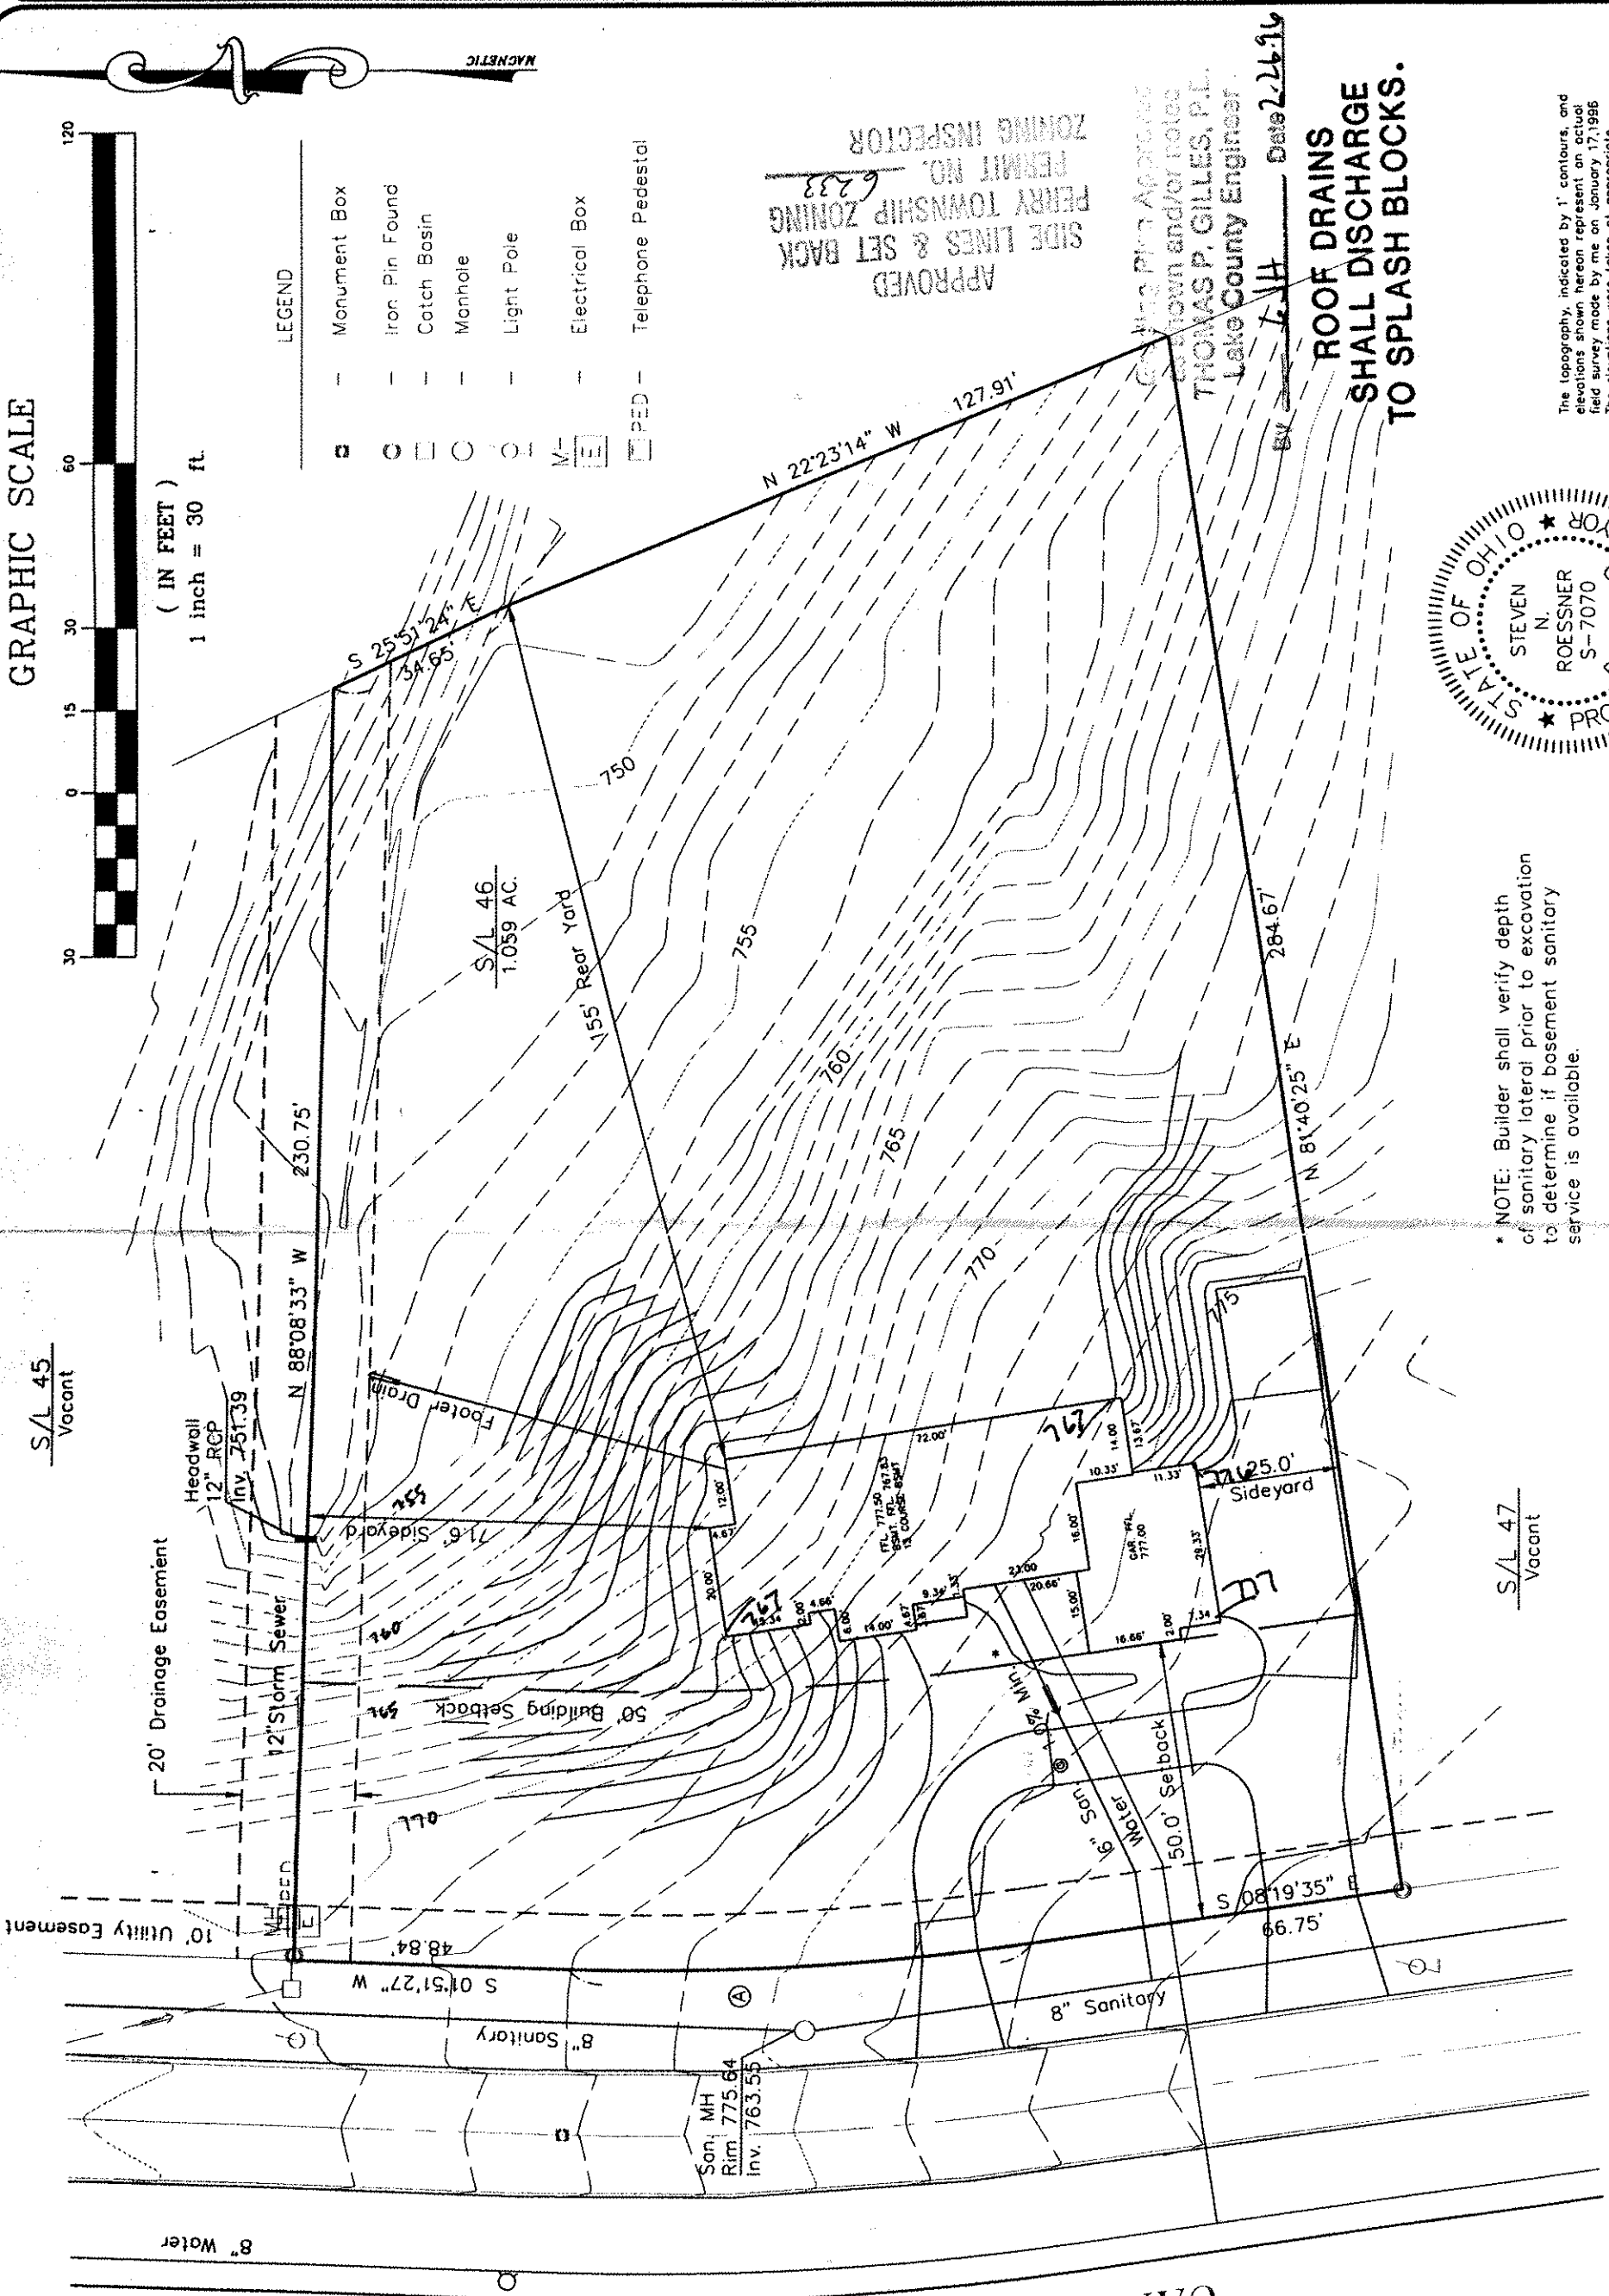


APPROVED
SIDE LINES & SET BACK
PERMIT NO. 6233
ZONING INSPECTOR

THOMAS P. GILLES, P.L.
Lake County Engineer

Date 2/24/96

ROOF DRAINS
SHALL DISCHARGE
TO SPLASH BLOCKS.

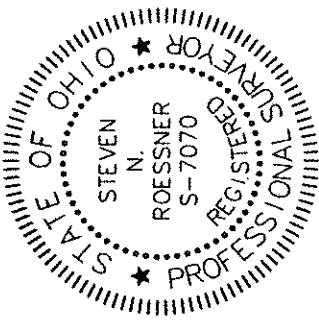

* NOTE: Builder shall verify depth of sanitary lateral prior to excavation to determine if basement sanitary service is available.

2/13/96
Steven N. Roessner

ForeSight Engineering Group
Engineers & Surveyors

SCALE: Horiz. 1"=30'
DATE: FEB. 5, 1996
FILE NAME: I:\CAS19601\91F2

SITE PLAN
S/L 46 CANYON RIDGE SUB. PHASE 2
PERRY TOWNSHIP - LAKE COUNTY - OHIO

SHEET NO. 1