

LEGEND

112.13' PLAN 112.00' 200' 34' 1' 1'

10' 20' 30' 40'

SCALE 1"=20'

CANYON RIDGE SUBDIVISION
PAGE 1
VOL. 18 P. 2
LAKE COUNTY RECORD OF PLATS
LOT Nos. 10 & 20

SUBLOT 13
ED FORSEY

115.13.200 12.14.894
R.P. No. 014 00 20 00 010
0.443 ACRES

④ COPY DATA FOR SUBLOT 13
A=129.55'
C=129.52'
T=64.80'
R=1720.00
Δ=04°18'50"
CB=5.15°35'13"

NOTES

1. DOWNSPROUTS TO LEACH BLOCKS.
2. SANITARY CONNECTION TO 16" D+M, ONE CONNECTION BEFORE BACKSIGHT.

This Site Plan is [REVIEWED] from review by the
LAKE COUNTY
STORMWATER MANAGEMENT DEPT.
Date 1-15-09
By [Signature]

ROOF DRAINS
SHALL DISCHARGE
TO SPLASH BLOCKS.

Stormwater Management Plan
Approved as shown and/or noted
JAMES R. GILLS, P.E.
County Drainage Engineer
By L.S. Date 9/9/04


REVISED 9-8-2004

REVISED 1/2/09

SCHADE SURVEYING COMPANY 4043 ERIE STREET WILLADUGHEP OHIO 44074 440 451-6454		
SCALE: 1"=20'	APPROVED BY	DRAWN BY FCM
DATE: 6-2-2007		FS 15 2007 LICENSE 31K
SITE PLAN FOR GARY GOELLNER AT SUBLOT 13 CANYON RIDGE DRIVE PERRY TOWNSHIP LAKE COUNTY, OHIO		
5615		DRAWING NUMBER 04-596

I, THE UNDERSIGNED, HEREBY CERTIFY THAT THIS TOPOGRAPHY MONUMENTED
SY 1 FOOT CONTOURS AND ELEVATIONS SHOWN HEREON BY ME ON THE 26TH
DAY OF MAY, 2004, AND THAT THE ELEVATIONS WERE TAKEN AT APPROPRIATE
INTERVALS AND THAT AS OF THAT DATE THEY EXISTED AS INDICATED HEREON.
I HEREBY CERTIFY THAT AN ACTUAL BOUNDARY SURVEY WAS PREPARED BY
ME ON THE 26TH DAY OF MAY, 2004, AND THAT THE SURVEY IS IN
ACCORDANCE WITH O.R.C. CHAPTER 4733-37 MINIMUM STANDARDS IN
THE STATE OF OHIO. PERMANENT MONUMENTS WERE FOUND OR SET AT ALL
LOCATIONS SHOWN HEREON. ALL DIMENSIONS GIVEN ARE EXPRESSED
IN FEET OR DECIMAL PARTS THEREOF. BEARINGS ARE TO AN
ASSUMED MERIDIAN AND ARE SHOWN TO INDICATE ANGLES ONLY.
I HEREBY CERTIFY THAT THIS PLAN WAS PREPARED BY ME
AND IS CORRECT TO THE BEST OF MY KNOWLEDGE, INFORMATION
AND BELIEF.

Willard F. Schade, Jr. 6008 800-07
WILLARD F. SCHADE, JR. PROFESSIONAL SURVEYOR NO. 6008 DATE

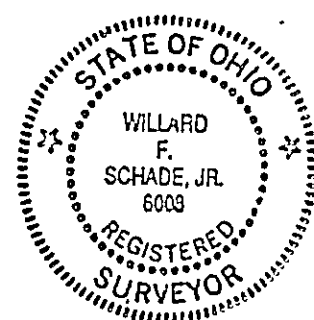

2 WORKING DAYS
BEFORE YOU DIG
CALL TOLL FREE 800-362-2764
OHIO UTILITIES PROTECTION SERVICE