


HYDRAULIC PROFILE  
SCALE: 1" = 4' VERT.  
1" = 40' HORIZ.

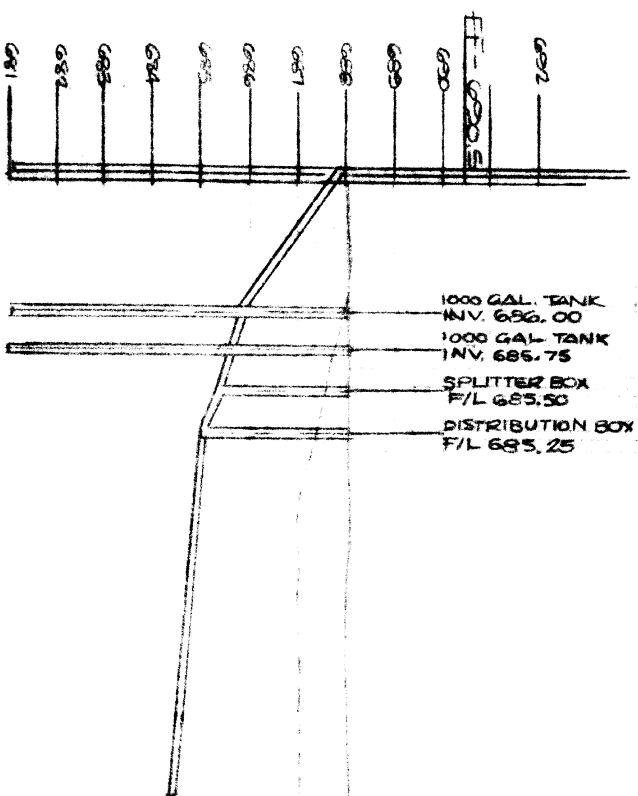

PUMP REQUIRED IF  
PUMPING IN BSMT.

SITE PLAN  
FOR  
FRANK ANGELORIO

★ STORM SEWER & PAVEMENT  
SHOWN IN ACCORDANCE WITH  
CASA BELLA SUBDIVISION  
IMPROVEMENT PLANS.

- A. To be brought to finished grade
1. Septic tank manhole covers
  2. Splitter box cover
  3. Distribution box cover
  4. Vent Pipes
- B. No footer drains or downspouts  
to be discharged into septic tanks
- C. All waste water to be discharged into  
septic tanks


Reviewed and Accepted  
LAKE COUNTY GENERAL HEALTH DISTRICT  
Date 7-8-87  
J.E. LUCIA, R.S., M.P.H.  
Health Commissioner  
By David B. Jones

BEING A PART OF LOT NO. 34 IN THE  
TOWNSHIP OF PERRY (S/L NO. 11 IN  
CASA BELLA SUBDIVISION) COUNTY  
OF LAKE, STATE OF OHIO.



THIS PLAT WAS PREPARED BY ME  
AND IS TRUE AND ACCURATE TO THE  
BEST OF MY KNOWLEDGE & BELIEF.

Thomas M. Coffman  
THOMAS M. COFFMAN, P.S.  
NO. 6851

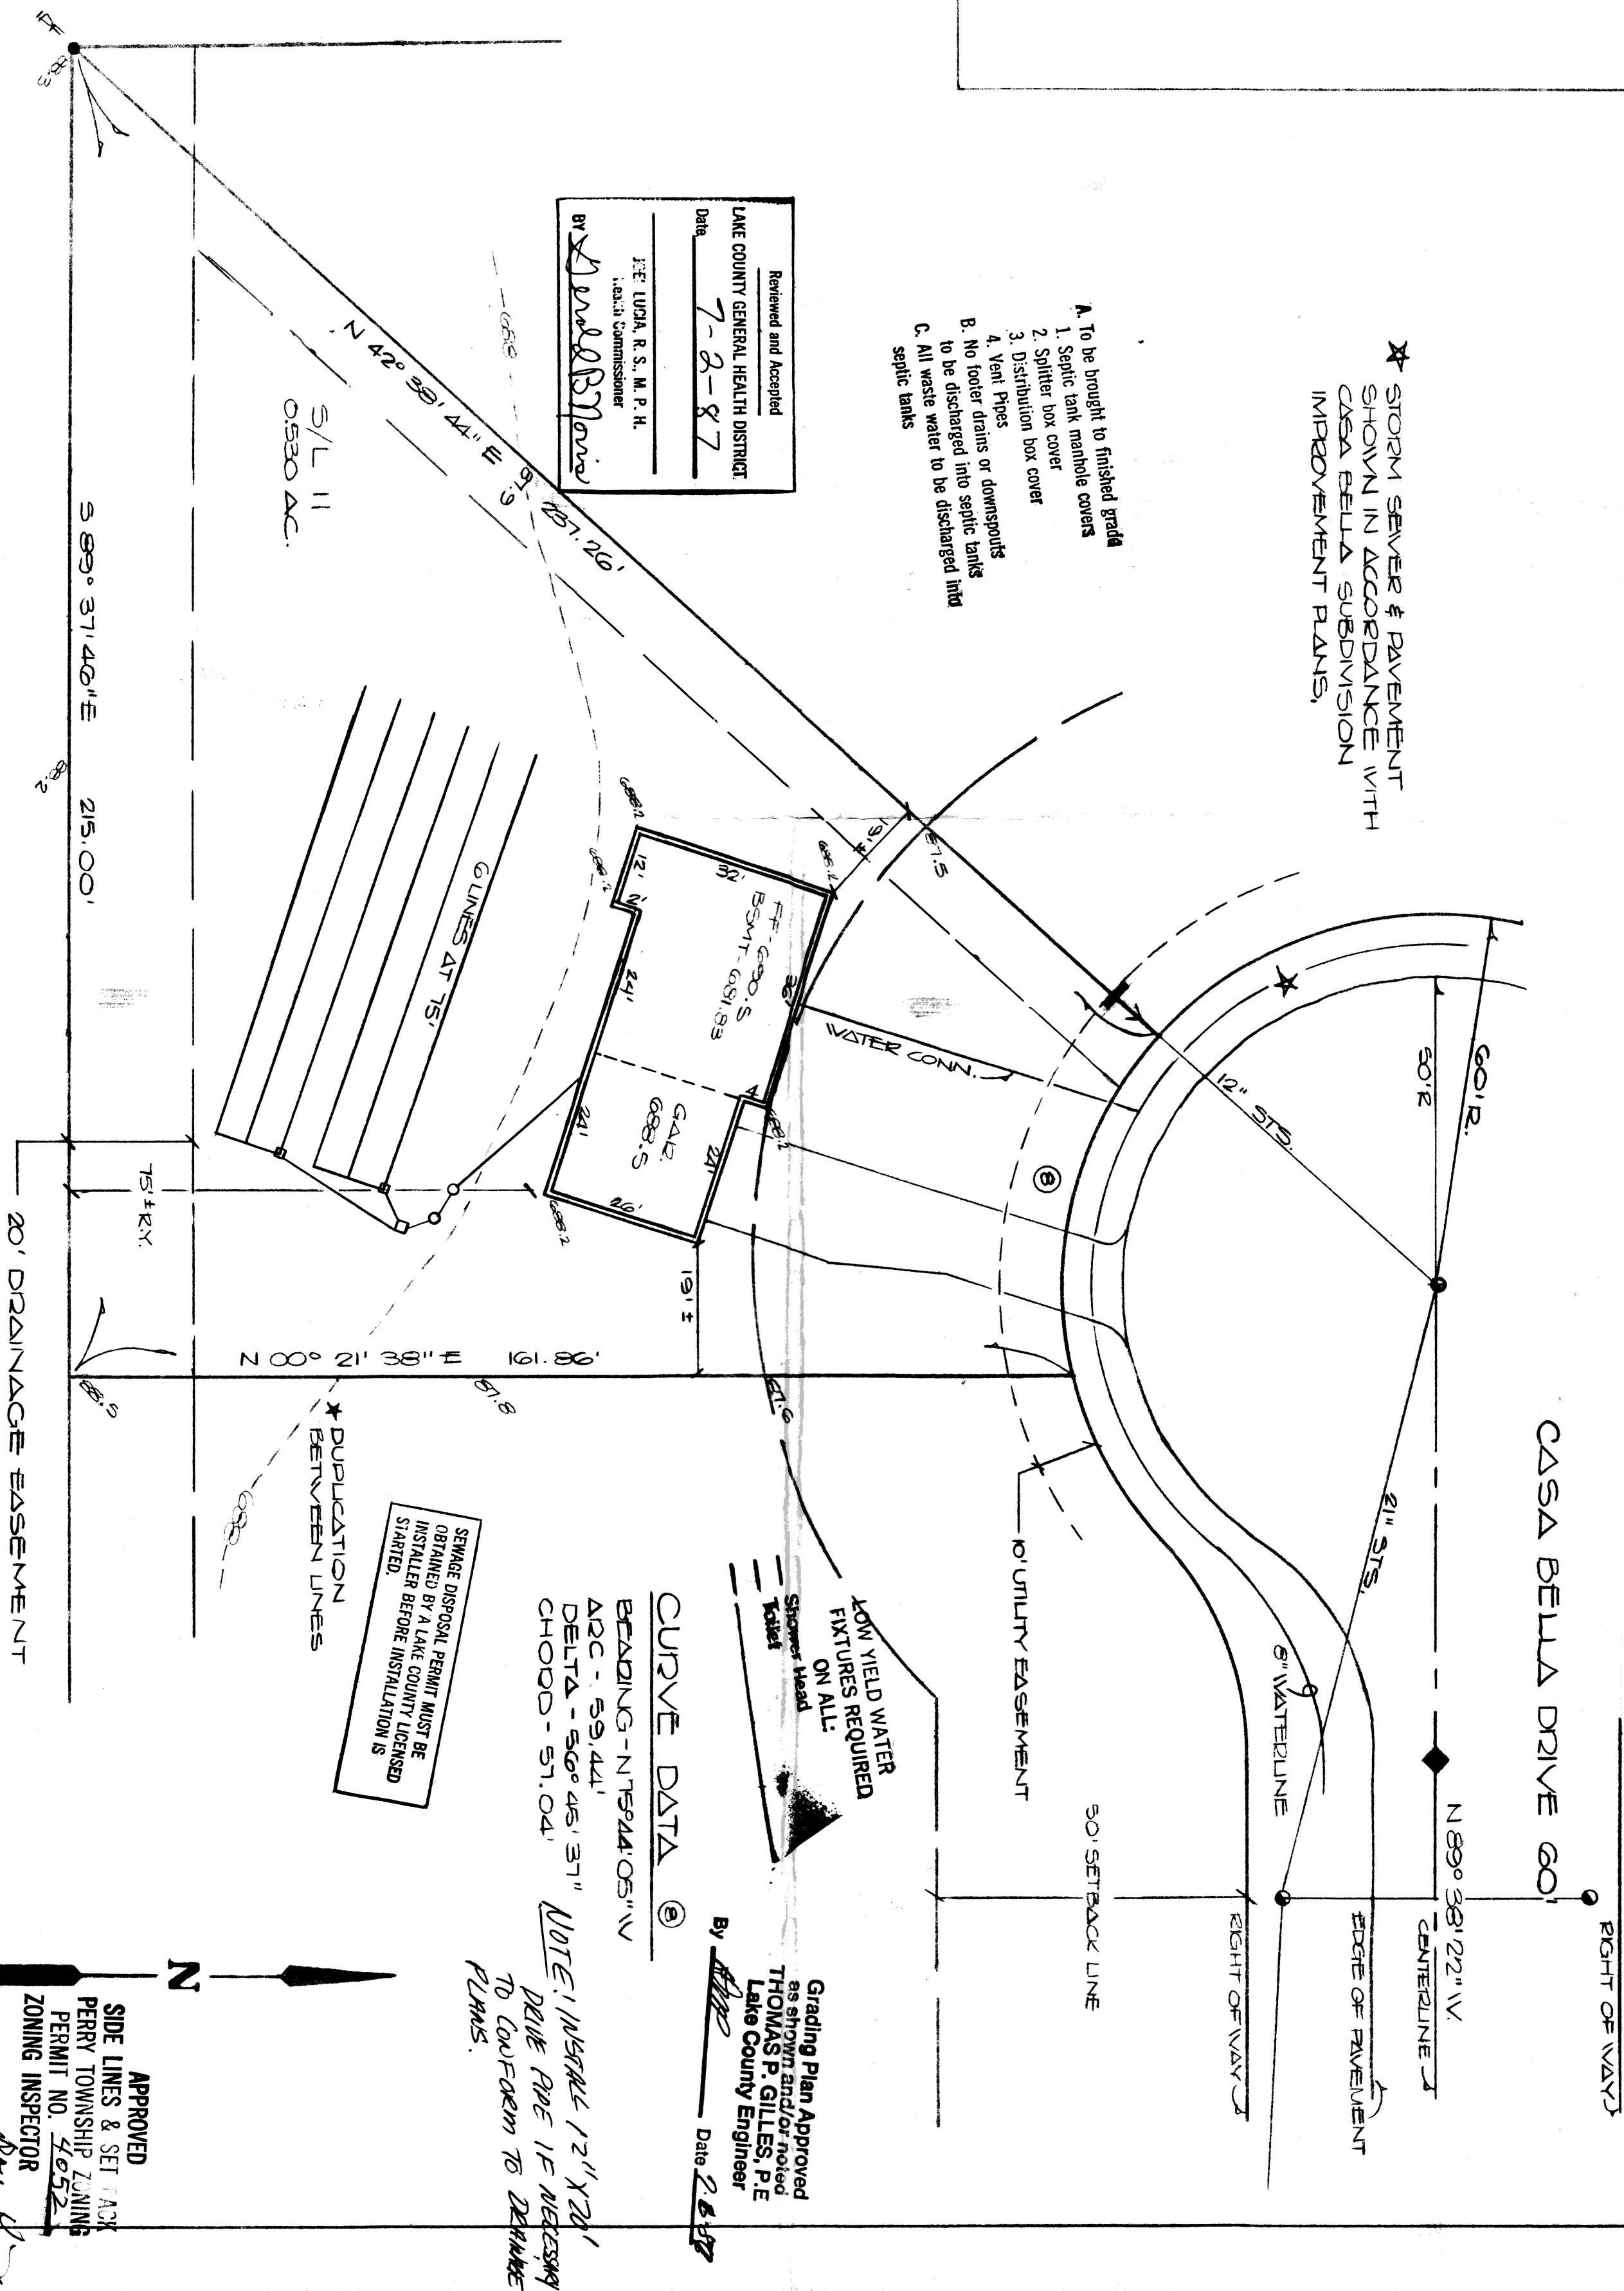

SEWAGE DISPOSAL PERMIT MUST BE  
OBTAINED BY A LAKE COUNTY LICENSED  
INSTALLER BEFORE INSTALLATION IS  
STARTED.

★ DUPLICATION  
BETWEEN LINES

CURVE DATA ③

BEADING - N 75° 44' 05" W  
ARC - 59.44'  
DELTA - 56° 45' 37"  
CHORD - 51.04'

NOTE: INSTALL 12" X 24"  
PIPE PIPE IF NEEDED  
TO CONFORM TO DRAINAGE  
PLANS.

Grading Plan Approved  
as shown and/or noted  
THOMAS P. GILLES, P.E.  
Lake County Engineer  
By APR  
Date 2-8-87

APPROVED  
SIDE LINES & SET BACK  
PERRY TOWNSHIP ZONING  
PERMIT NO. 4052  
ZONING INSPECTOR  
Don King

SCALE: 1" = 20'

VILLAGE SURVEYING CO.

THOMAS M. COFFMAN, P.S.  
202 THIRD ST., FAIRPORT HARBOR, OHIO 44071  
(216) 357-1353