
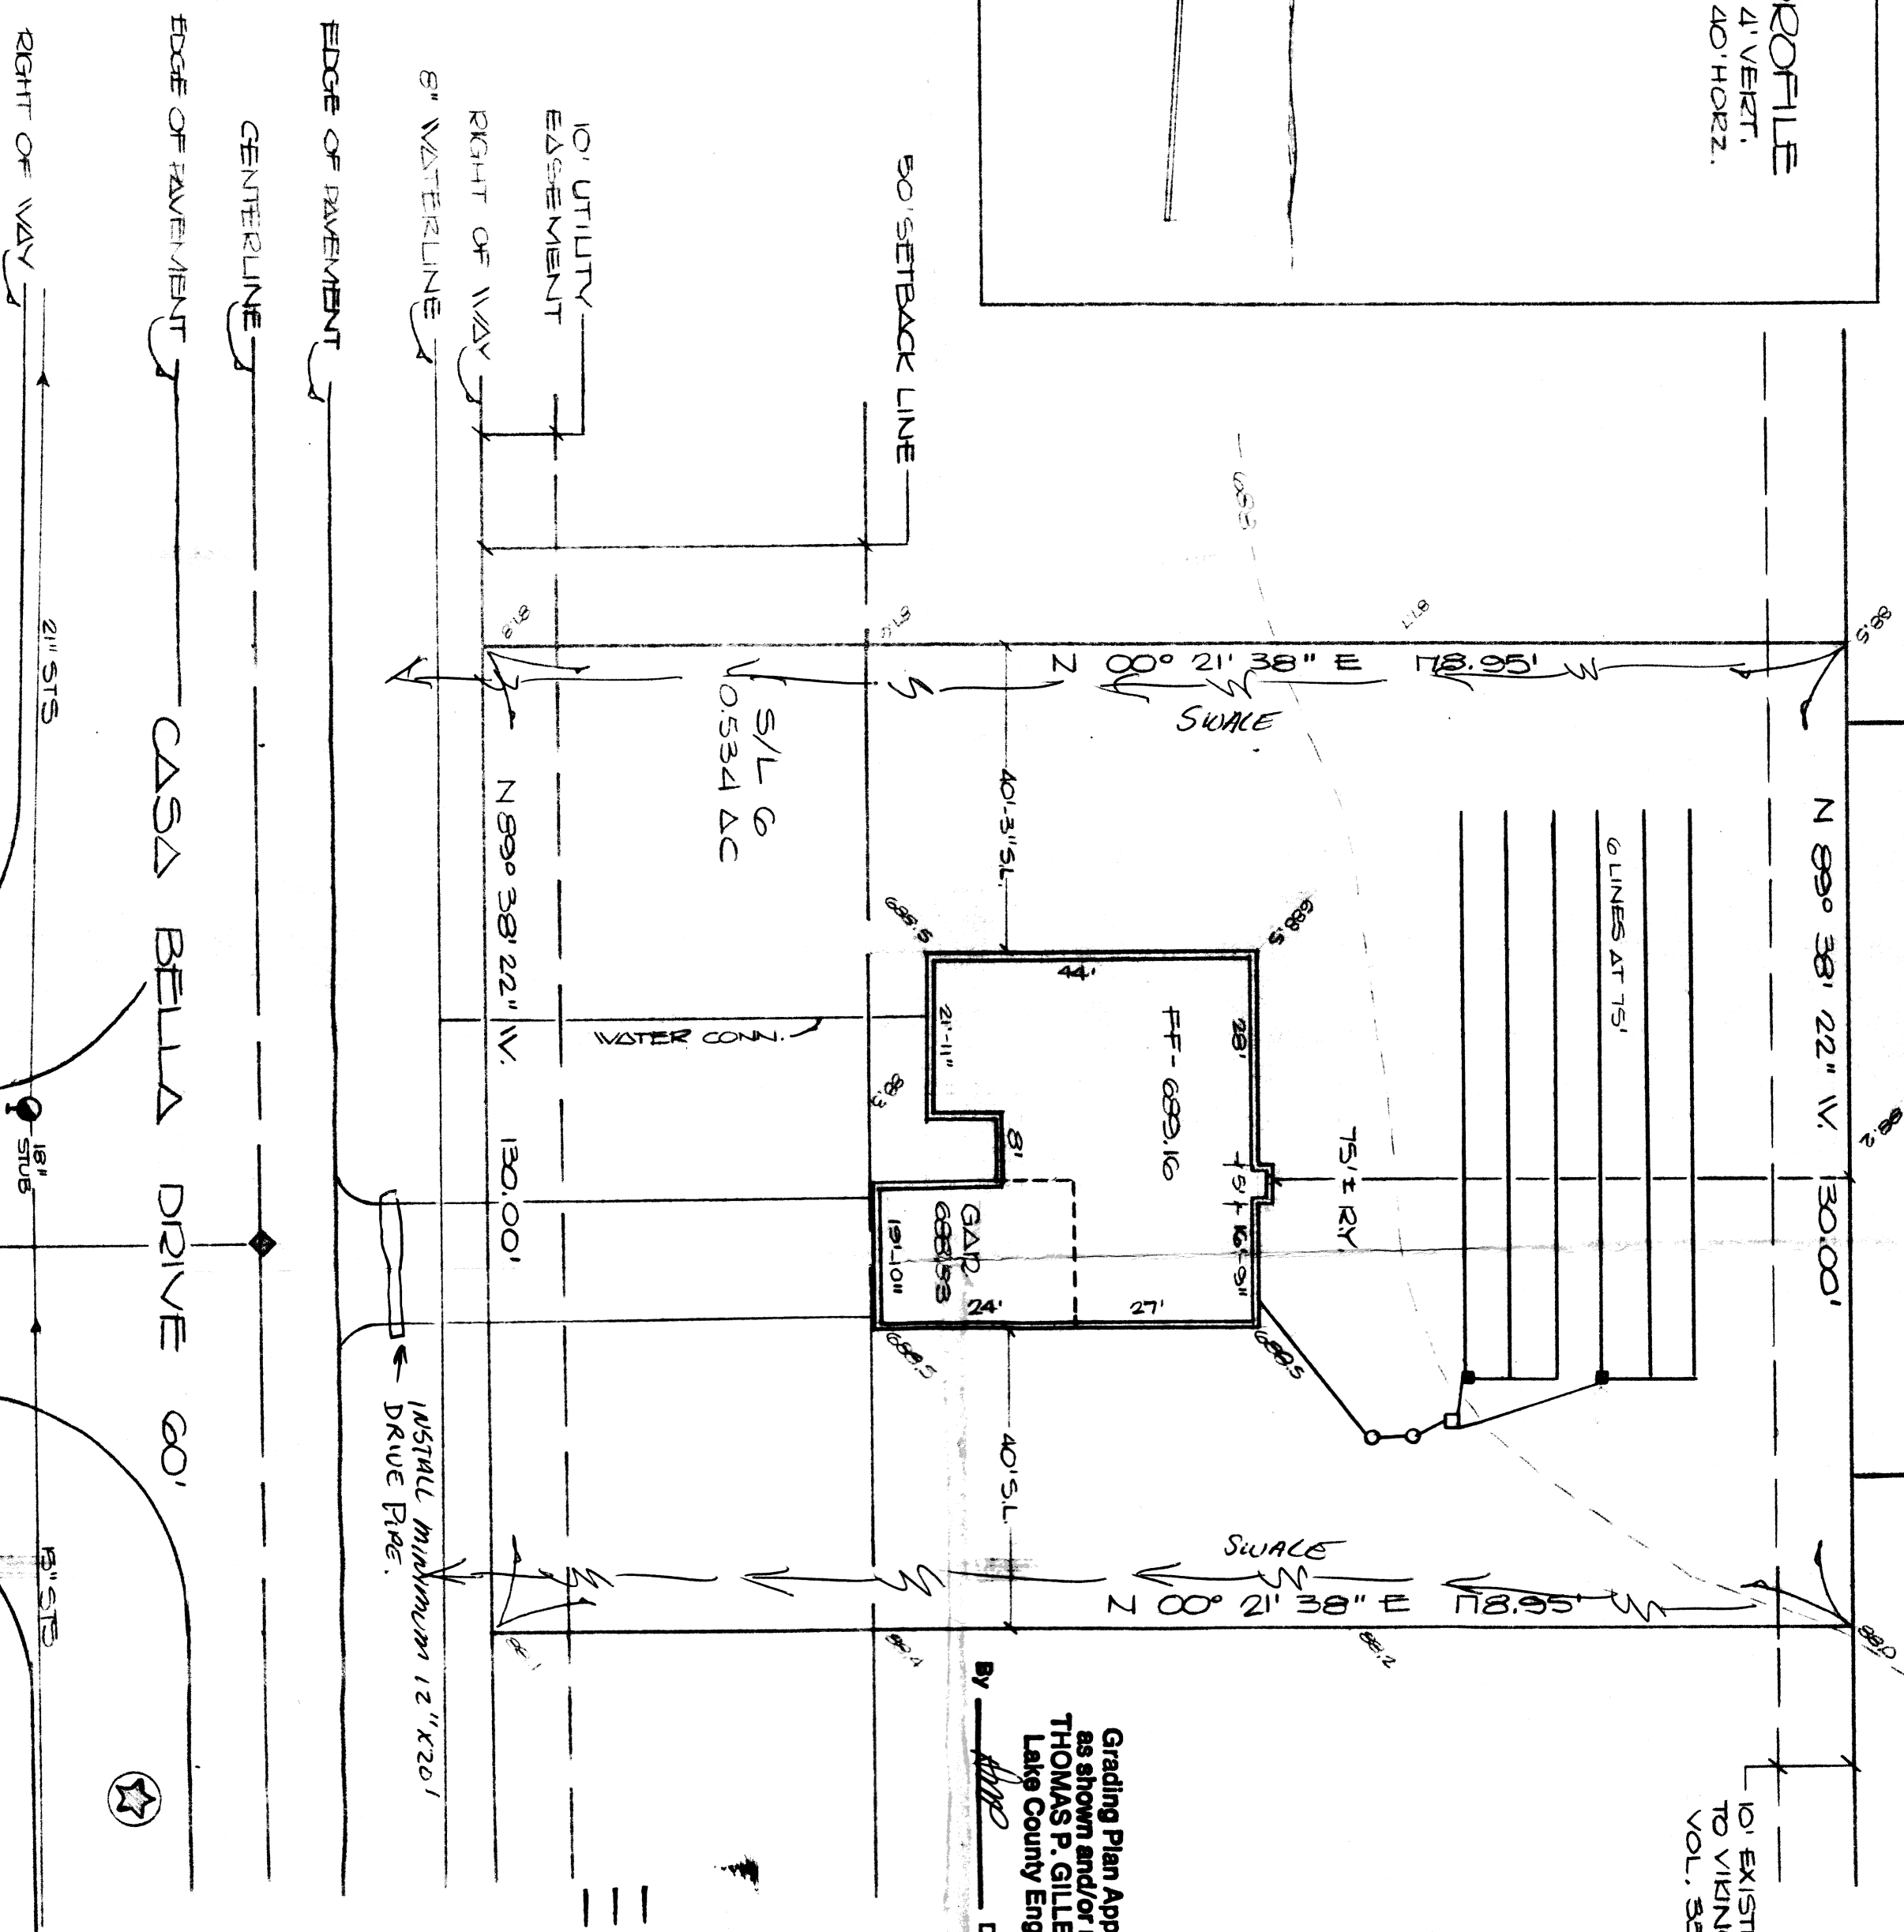


SCALE: 1" = 4' VERT.
1" = 40' HORIZ

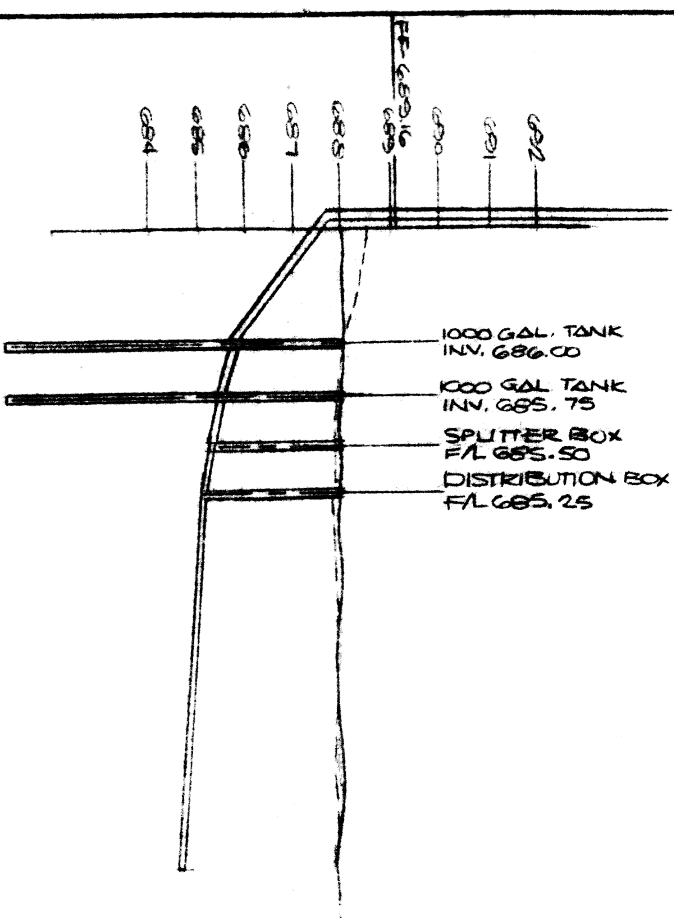

★ DUPLICATION BETWEEN LINES

101 EXISTING ~~HOUSE~~ ^{HOUSE} IN SEVENTH HEALTH DISTRICT
TO VIKING RESOURCES ~~73-2-87~~
VOL. 35-891

Revised and Accepted

HALL-SCHEINER GREENE HEALTH DISTRICT

SOURCE # 2-87

JOBEL HENCA R.S., M.D., LL.

Health Commissioner

David B. Jones

SCALE: 1" = 20'

SITE PLAN for FRANK ANGELORO

Grading Plan Approved
as shown and/or noted
THOMAS P. GILLES, P.E.
Lake County Engineer

By THP Date 2/1/11

Date 7.6.87

SEWAGE DISPOSAL PERMIT MUST BE OBTAINED BY A LAKE COUNTY LICENSED INSTALLER BEFORE INSTALLATION IS STARTED.

**LOW YIELD WATER
FIXTURES REQUIRED**

ON ALL:

BEING A PART OF LOT NO. 84 IN THE TOWNSHIP OF PERCY (S/L NO. 6 IN CASA BELLA SUBDIVISION), COUNTY OF LAKE, STATE OF OHIO.

STORM SEWER & PAVEMENT
SHOWN IN ACCORDANCE WITH
CASA BELLA SUBDIVISION IM-
PROVEMENT PLANS.

- A. To be brought to finished grade
- 1. Septic tank manhole covers
- 2. Splitter box cover
- 3. Distribution box cover
- 4. Vent Pipes
- B. No footer drains or downspouts to be discharged into septic tanks
- C. All waste water to be discharged into septic tanks

APPROVED
SIDE LINES & SET BACK
PERRY TOWNSHIP ZONING
PERMIT NO. 4051
ZONING INSPECTOR don

THIS PLAT WAS PREPARED BY ME
AND IS TRUE AND ACCURATE TO THE
BEST OF MY KNOWLEDGE & BELIEF.

THOMAS M. C. 8857
THOMAS M. C. 8857

VILLAGE SURVEYING CO.
THOMAS M. COFFMAN
202 THIRD STREET, FAIRPORT HARBOR, OHIO 44077
(216) 357-1359