

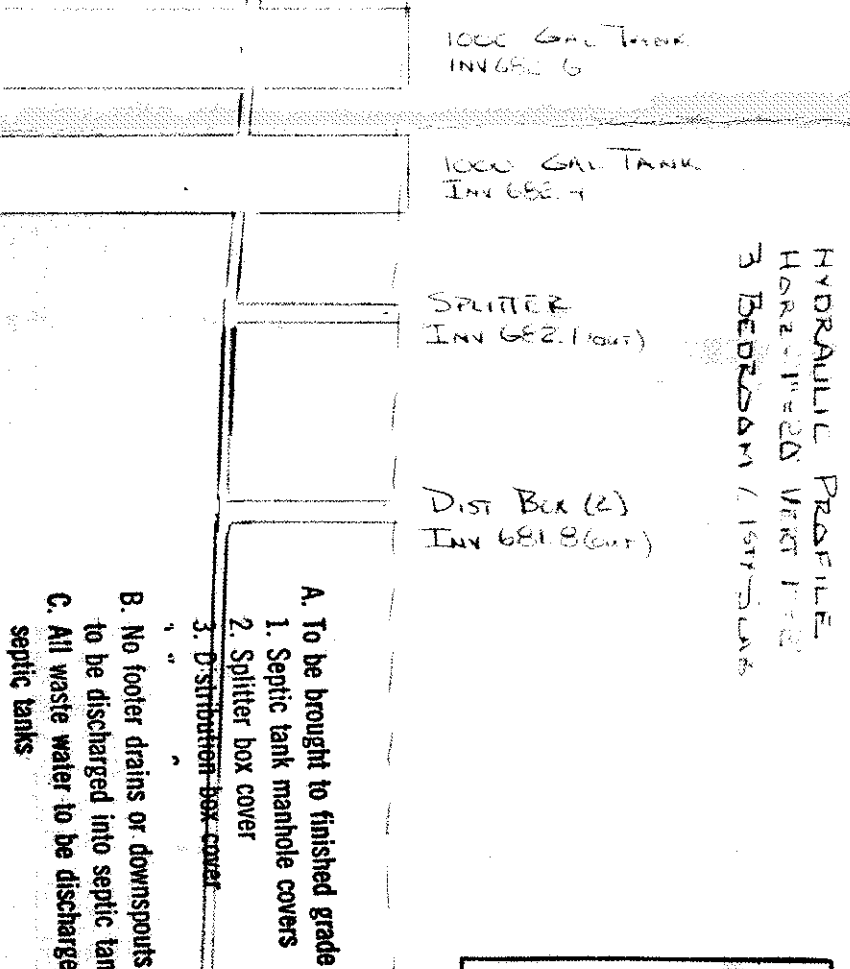


SITE PLAN
FOR
ANGELORD CONSTRUCTION
BEING SUBLOT NO. 3, COMA BELLA SUB'D,
TOWNSHIP OF PERRY LAKE COUNTY OHIO.

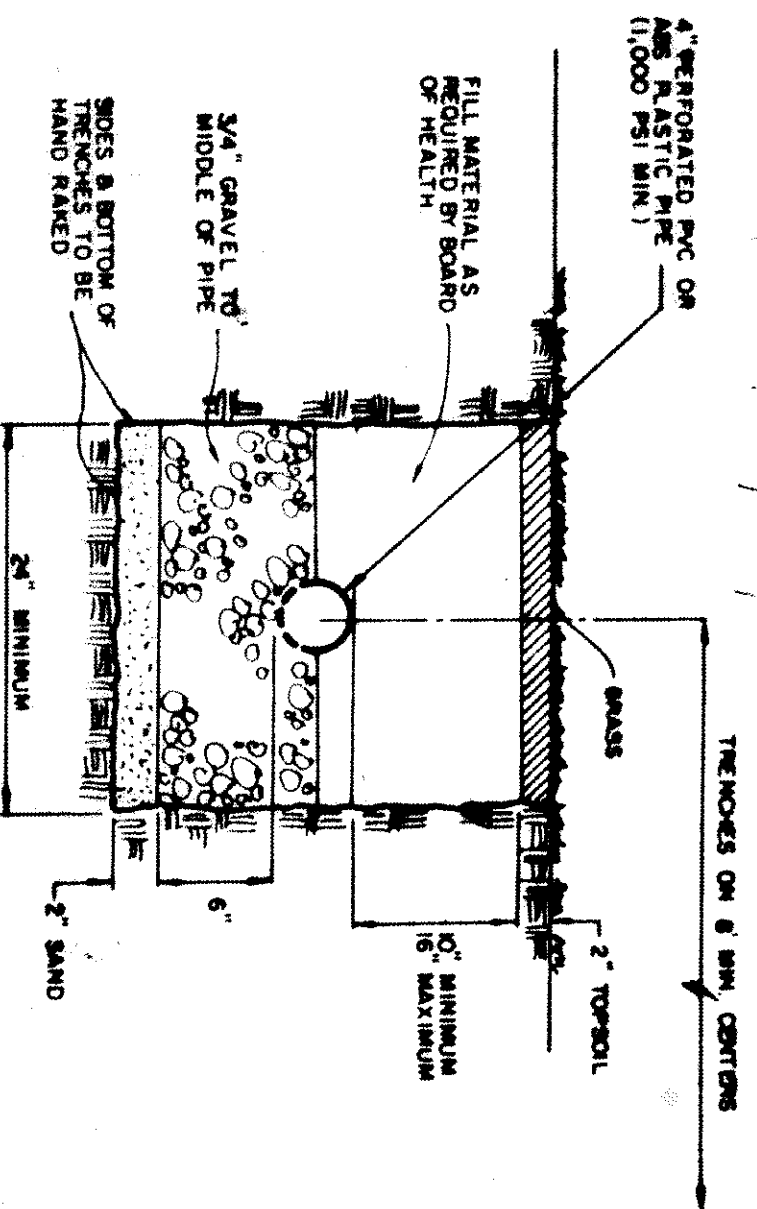


Reviewed and Accepted
LAKE COUNTY GENERAL HEALTH DISTRICT
Date 5-6-91
JOE LUCIA, R. S., M. P. H.
Health Commissioner
BY: M. N. N. N.

SEWAGE DISPOSAL PERMIT MUST BE
OBTAINED BY A LAKE COUNTY LICENSED
INSTALLER BEFORE INSTALLATION IS
STARTED.

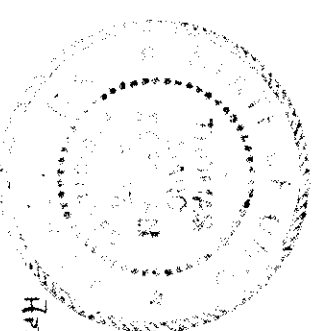

APPROVED
SIDE LINES & SET BACK
PERRY TOWNSHIP ZONING
PERMIT NO. 4466
ZONING INSPECTOR [Signature]

Grading Plan Approved
as shown and/or noted
THOMAS P. GILLES, P.E.
Lake County Engineer
By: G.H. Date: 5/9/91

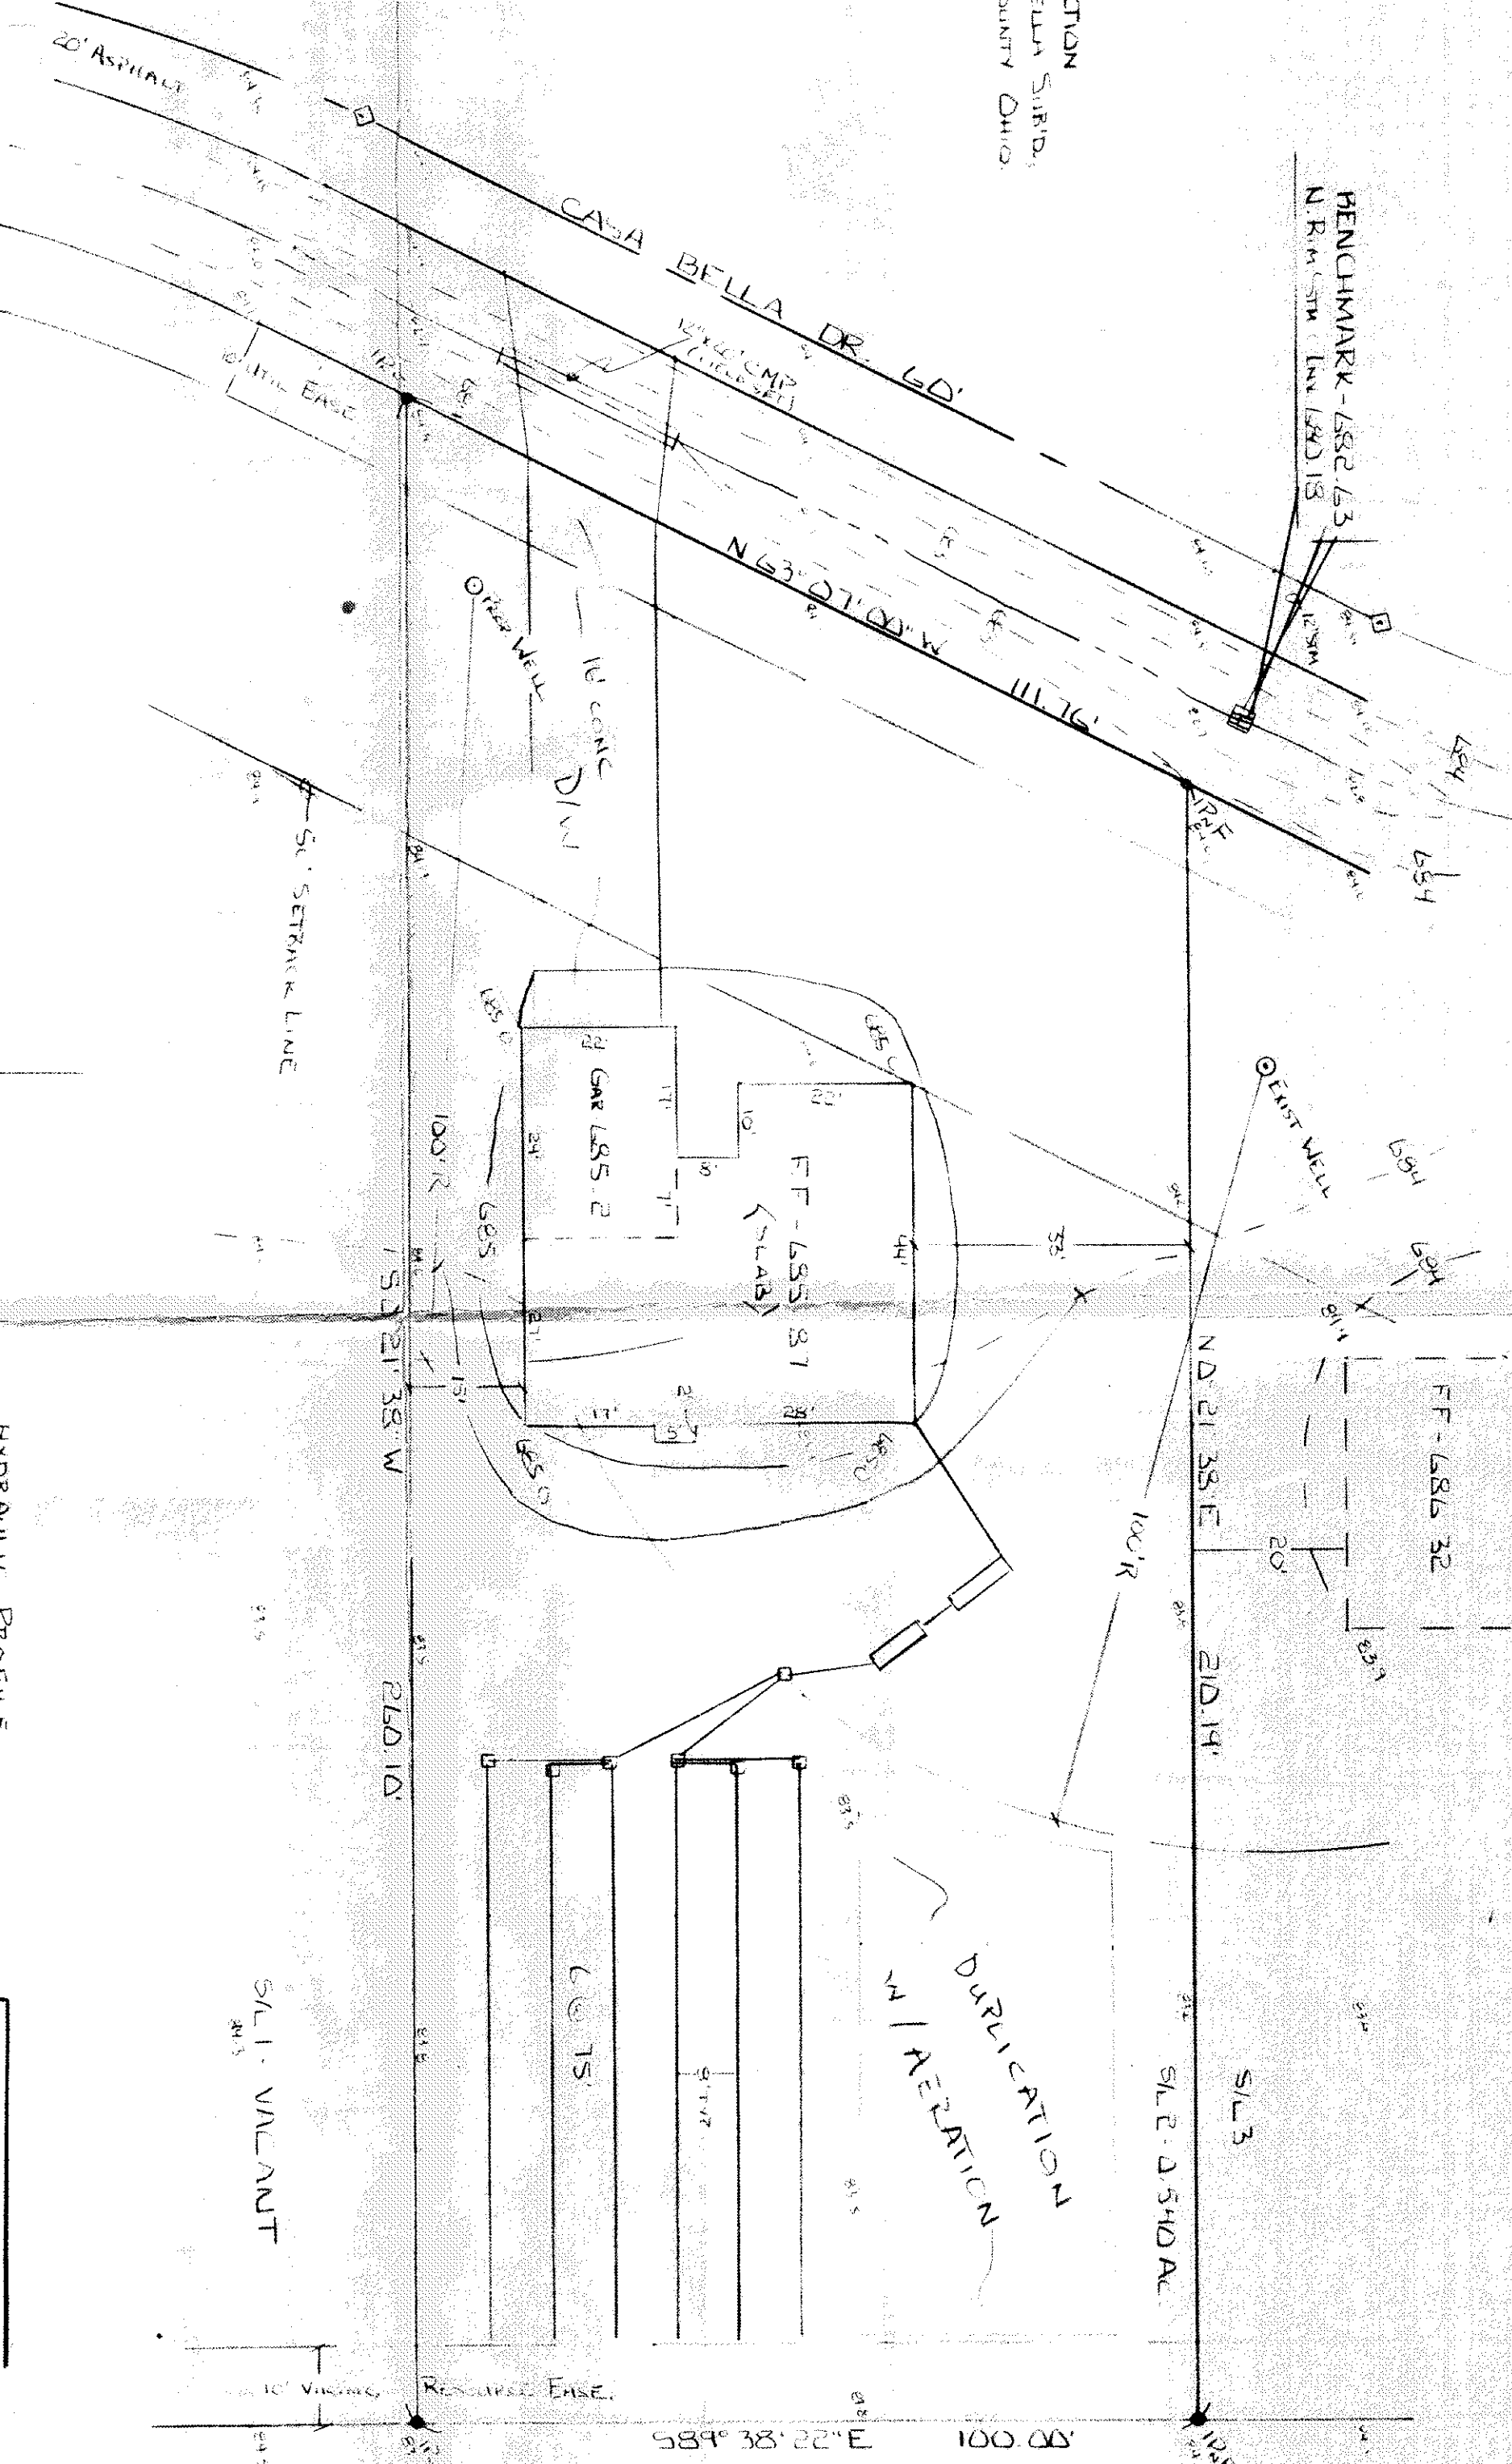

1" = 20'

EAST
TRUCK
EXIST
ROAD

VILLAGE SURVEYING CO.
202 THIRD ST. FAIRPORT HARBOR OH 44077
(216) 351-1359

I, the undersigned hereby certify that
this topography, indicated by 1' contours
and elevations shown hereon represent an
actual field survey made by me on April 4, 1991
and that the elevations were taken
at appropriate intervals and that as of that
date they existed as indicated hereon.
J. M. Coffey P.E.
No. 6851