

| Rev. No. | Description                                                      | Date    | By   |
|----------|------------------------------------------------------------------|---------|------|
| 1        | REVISED SEPTIC SYSTEM LOCATION PER OWNER & HEALTH DEPARTMENT     | 9/16/93 | D.A. |
| 2        | REVISED FINISHED GRADE & E.T. FIELD PER LAKE COUNTY HEALTH DEPT. | 9/30/93 | D.A. |


Site Plan for  
Phil Kertcher  
Clark Road - Perry Twp.  
July 1993

|           |                    |
|-----------|--------------------|
| Scale:    | Horizontal: 1"=30' |
|           | Vertical: 1"=30'   |
| Sheet No. | 01                 |
|           | 2                  |



**LAKE, INC.**  
ENGINEERS & SURVEYORS  
30601 BUCKLE AVENUE, SUITE 100, CINCINNATI, OHIO 45244  
PHONE: (513) 555-2100 FAX: (513) 555-5122

|              |             |
|--------------|-------------|
| Drawn By:    | BBS         |
| Filename:    | 93-87-89-87 |
| Checked By:  |             |
| Approved By: |             |

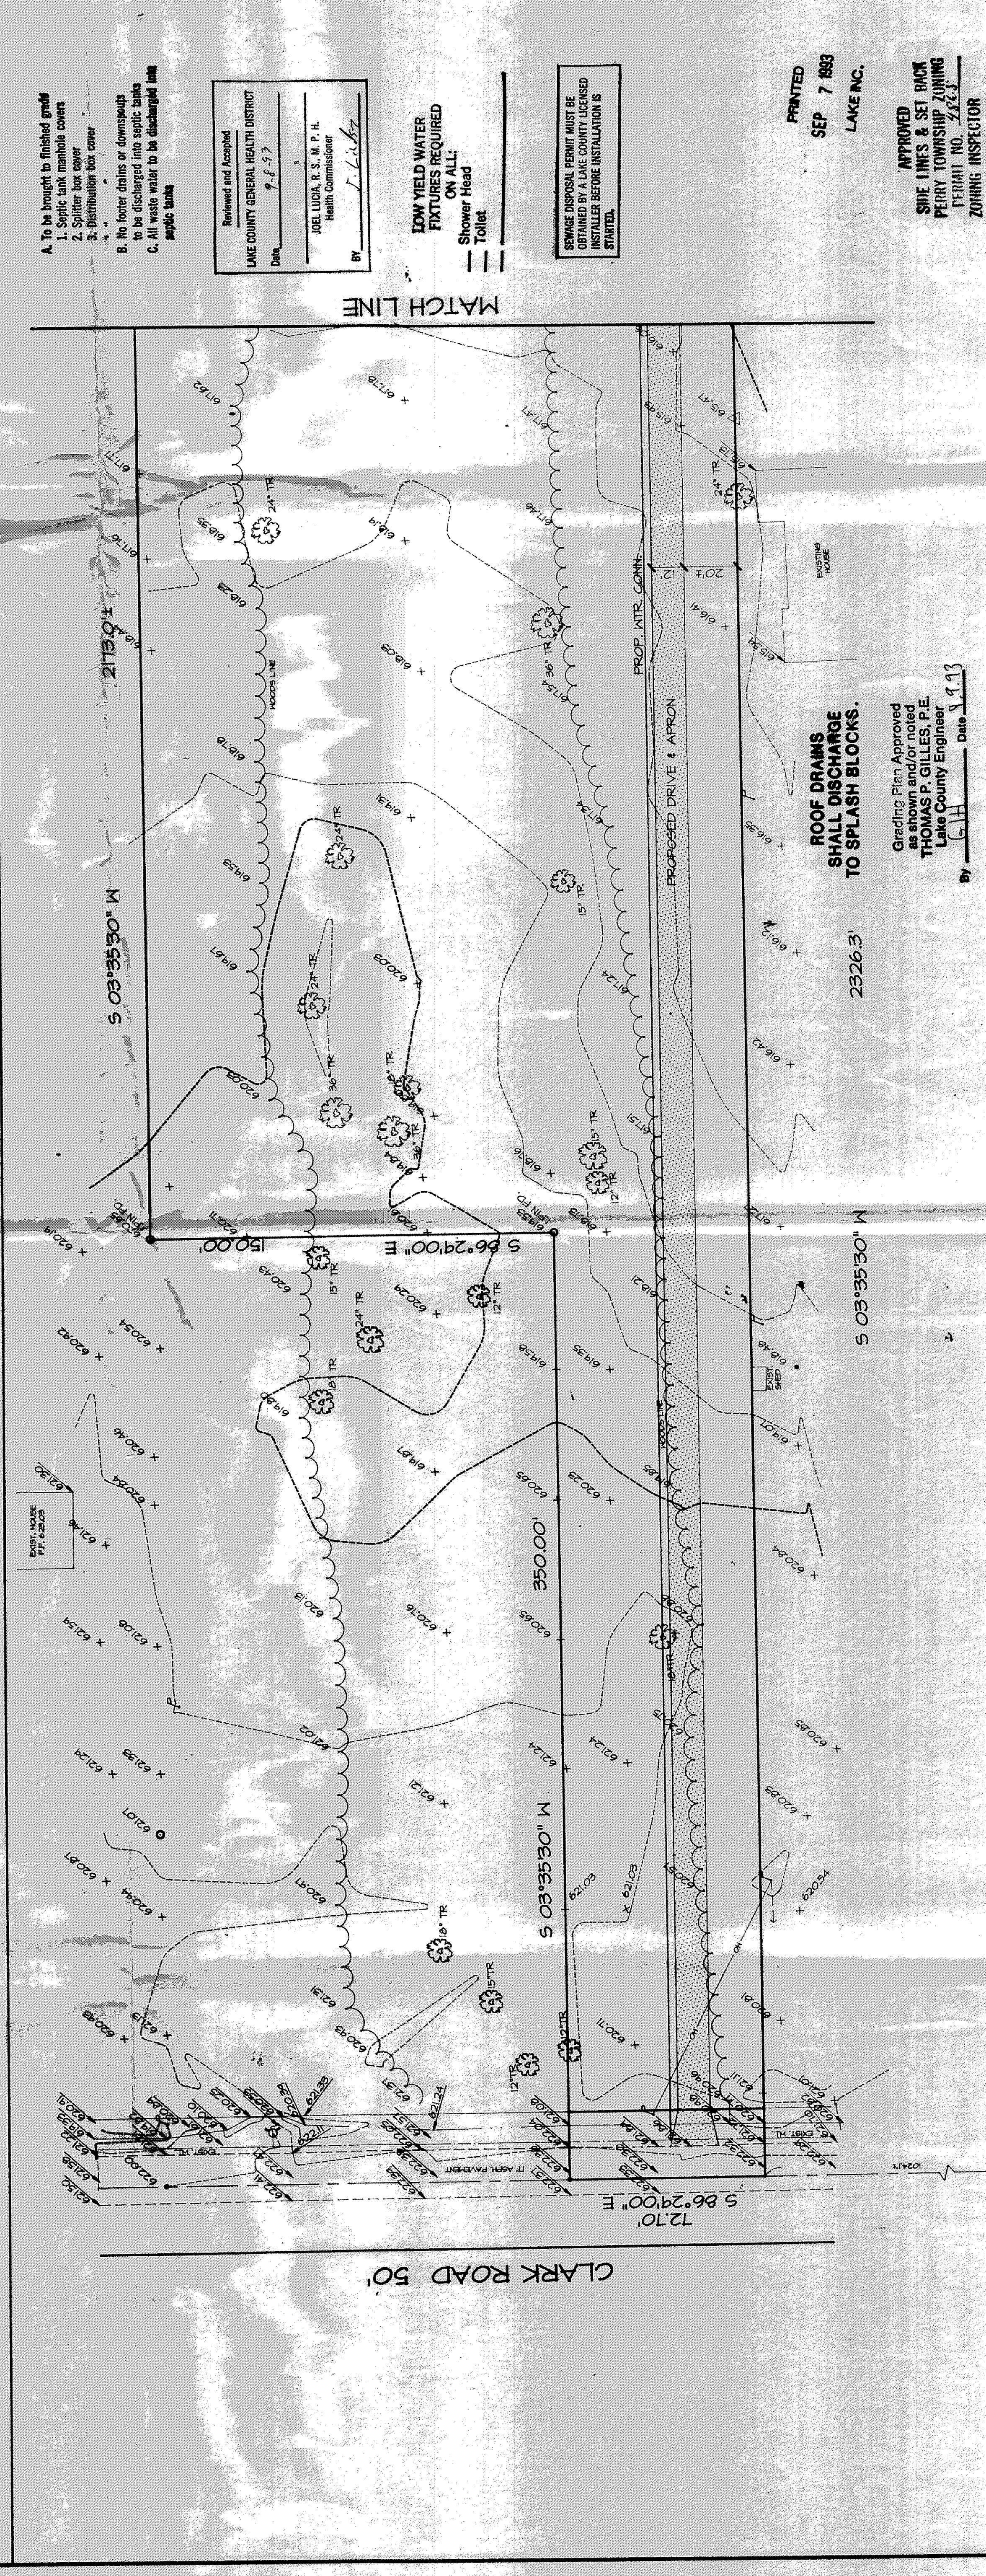

APPROVED  
SUE LINES & SET BACK  
PERRY TOWNSHIP ZONING  
PERMIT NO. 2233  
ZONING INSPECTOR

Grading Plan Approved  
as shown and/or noted  
THOMAS P. GILLES, P.E.  
Lake County Engineer  
By: T.H. Date: 7/93

PRINTED  
SEP 7 1993  
LAKE INC.

ROOF DRAWS  
SHALL DISCHARGE  
TO SPLASH BLOCKS.

SEWAGE DISPOSAL PERMIT MUST BE  
OBTAINED BY LAKE COUNTY LICENSED  
INSTALLER BEFORE INSTALLATION IS  
STARTED.

LOW YIELD WATER  
FIXTURES REQUIRED  
ON ALL:  
Shower Head  
Toilet

|                                     |                                                |
|-------------------------------------|------------------------------------------------|
| Reviewed and Accepted               |                                                |
| LAKE COUNTY GENERAL HEALTH DISTRICT |                                                |
| Date:                               | 9-8-93                                         |
| BY:                                 | JOEL LUCK, R.S., M.P.H.<br>Health Commissioner |

- A. To be brought to finished grade
- 1. Septic tank manhole covers
- 2. Siphon box cover
- 3. Distribution box cover
- B. No footer drains or downspouts  
to be discharged into septic tanks
- C. All waste water to be discharged into  
septic tanks