



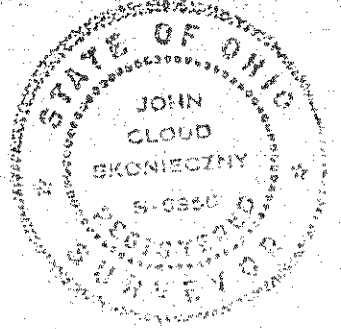

DESIGN CERTIFICATION
"I THE UNDERSIGNED, HEREBY CERTIFY THAT THIS TOPOGRAPHY INDICATED BY CONTOURS AND EXISTING ELEVATIONS SHOWN HEREON REPRESENTS AN ACTUAL SURVEY MADE BY ME ON JUNE 07, 2003 AND THAT THE ELEVATIONS WERE TAKEN AT THE APPROPRIATE INTERVALS AND AS OF THAT DAY THEY EXISTED AS INDICATED HEREON.

I FURTHER CERTIFY THAT THIS PLAN WAS PREPARED BY ME FROM AN ACTUAL BOUNDARY SURVEY AND IRON PINS WERE FOUND OR SET AT THE PROPERTY CORNERS AND ALL OF WHICH IS CORRECT TO THE BEST OF MY KNOWLEDGE AND BELIEF."


BY: John C. Skonieczny
REG. NO. 6356

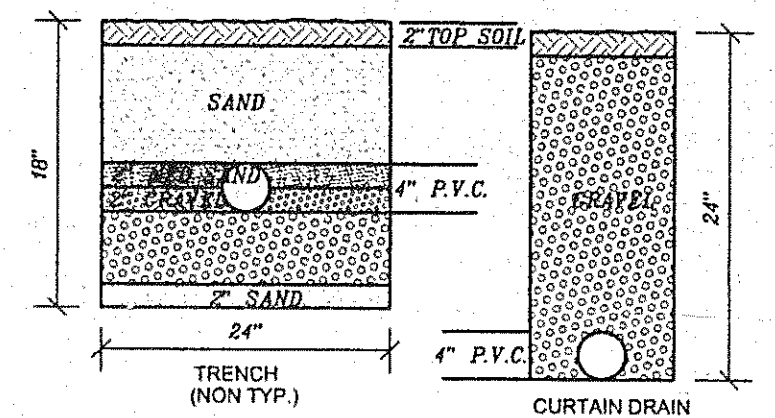

- NOTE 1
④ 6" P.V.C., STR. SEWER @1.00% MIN
⑤ 1" WATER CONN. TYPE "K" COPPER

NOTE 1
EXCAVATING CONTRACTOR TO FIELD VERIFY SERVICE CONNECTION LOCATION AND ELEVATIONS PRIOR TO BASEMENT EXCAVATION.

2 WORKING DAYS BEFORE YOU DIG
CALL TOLL FREE 800-362-2764
OHIO UTILITIES PROTECTION SERVICE

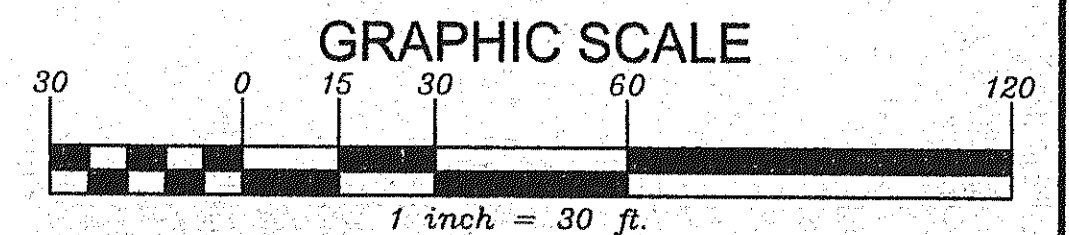


SITE PLAN FOR: CATHERINE NICHOLS	
SCALE: 1" = 30'	APPROVED:
DATE: JULY 03	DRAWN BY: SWC
BEING P.P. No.03A-031-002 AS RECORDED IN DOCUMENT No.20010546 IN THE LAKE COUNTY RECORD OF DEES	
TOWNSHIP OF PERRY - COUNTY OF LAKE - STATE OF OHIO	
DRAWING NUMBER NIC-001	

Stormwater Management Plan
Approved as shown and/or noted
JAMES R. GILLS, P.E.
County Drainage Engineer
By GH Date 2-25-04
See attached notes

I CERTIFY THAT THIS PLAN WAS PREPARED BY ME AND IS CORRECT TO THE BEST OF MY KNOWLEDGE AND BELIEF
John C. Skonieczny
REG. SURVEYOR #6356

JOHN C. SKONIECZNY
7739 VIEWMOUNT DR.
PAINESVILLE, OHIO 44077
PH. 352-7742

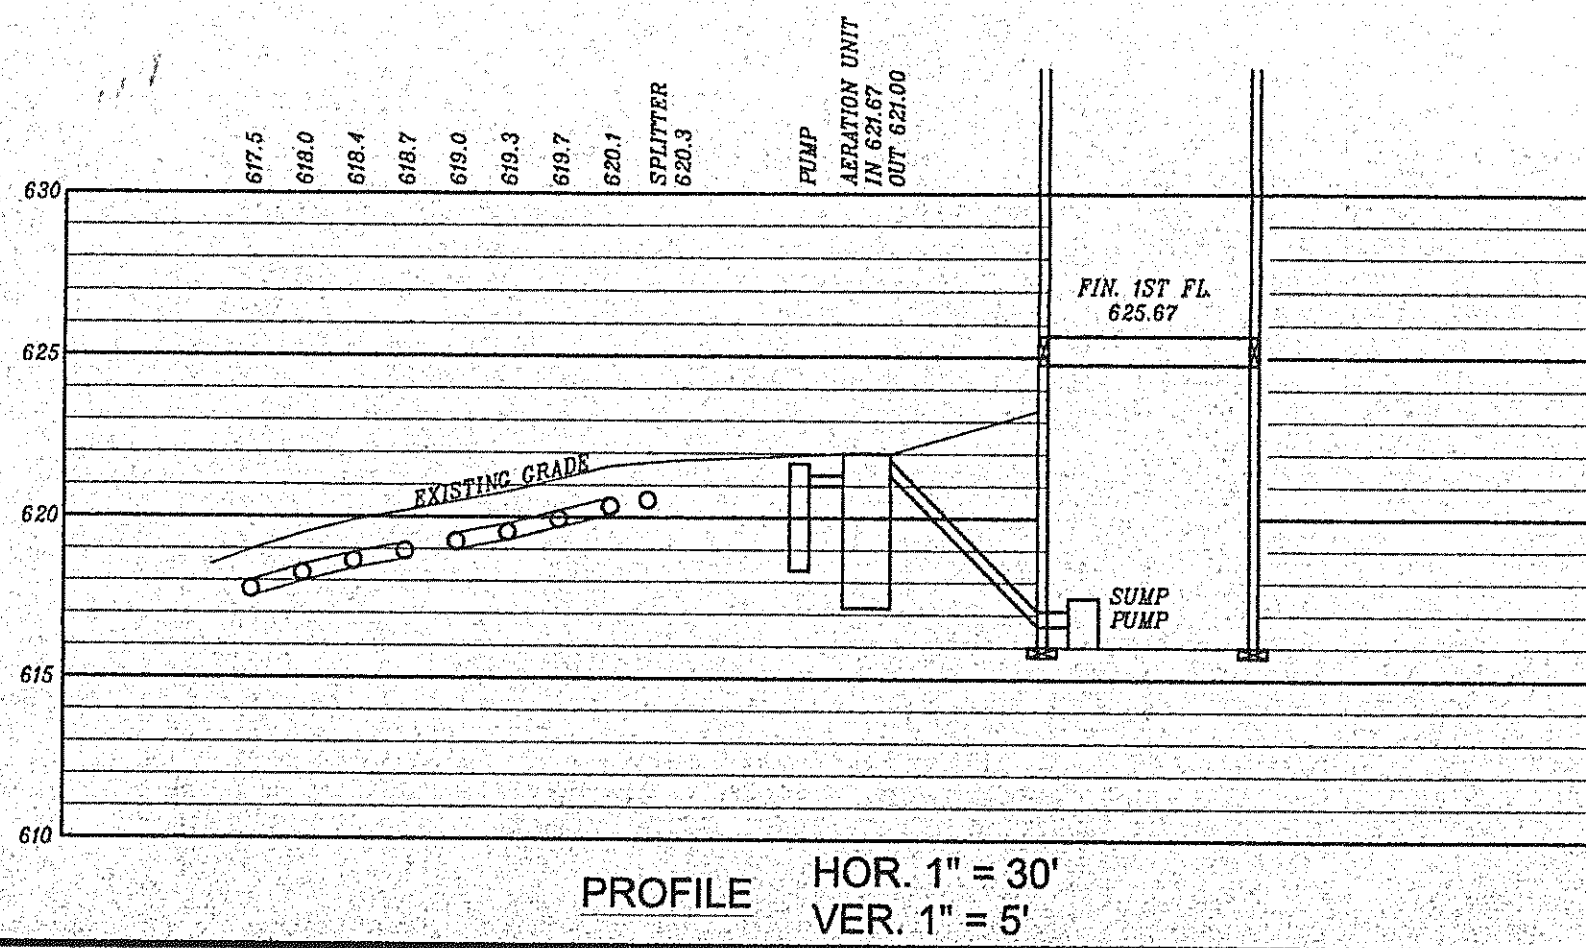

PROFILE HOR. 1" = 30'
VER. 1" = 5'

