
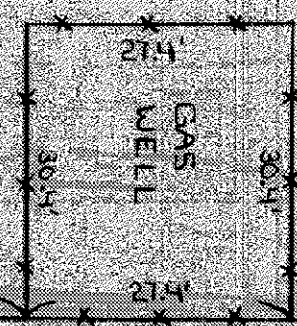


GREG ABRAHAMSEN
BEING PARCEL 12, LOT 91 IN THE TOWNSHIP
OF PERRY COUNTY OF LAKE, STATE OF OHIO

BENCHMARK: 100.00 ASSUMED
TOP BOLT HYDRANT

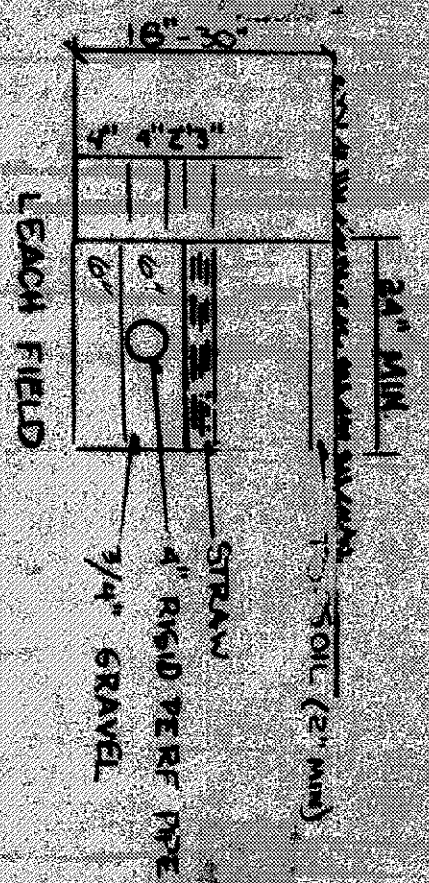

CLARK ROAD 60'

JOHN R. & MARCY J. CLARK
V. 552-743


586° 38' 15" E 100.00'

Reviewed and Accepted
LAKE COUNTY GENERAL HEALTH DISTRICT
Date 7.20.92
SCE 10/13
JOEL LUCIA, R.S., M.P.H.
Health Commissioner
BY Nancy Means

- A. To be brought to finished grade
1. Septic tank manhole covers
 2. Spillout box cover
 3. Distribution box cover
- B. No footer drains or downspouts
to be discharged into septic tanks
- C. All waste water to be discharged into
septic tanks

LOW YIELD WATER
FIXTURES REQUIRED
ON ALL:
Shower Head
Toilet

I, the undersigned hereby certify that
this map, plan, or specification, including all
and every part thereof, was prepared by
me or under my direct supervision and
that I am a duly licensed Professional
Engineer in the State of Ohio, and that
the work was done by me or under my
direct supervision and that I am a duly
licensed Professional Engineer in the
State of Ohio.

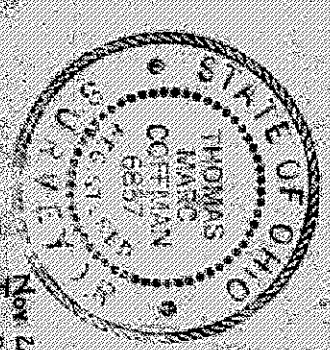

RON E. JR. & ALICE RONKE
V. 552-739

RON E. JR. & ALICE RONKE
V. 552-739

Grinder Pump
Rego Pumping
Basin

1000 GAL TANK
IN-13.1

1000 GAL TANK
IN-13.2

SPILLER
IN-13.2

HYDRAULIC PROFILE
HORIZ. 1" = 30' VERT. 1" = 3'
3 BEDROOM HOME

APPROVED
SIDE LINES & SET BACK
PERRY TOWNSHIP ZONING
PERMIT NO. 2563
ZONING INSPECTOR

SEWAGE DISPOSAL PERMIT MUST BE
OBTAINED BY A LAKE COUNTY LICENSED
INSTALLER BEFORE INSTALLATION IS
STARTED.

VILLAGE SURVEYING CO.

202 THIRD STREET FAIRPORT HARBOR, OHIO 44017
(216) 357-1359

- Please Note:
1. This plan is a 18' deep
every 4' pump may be
required to achieve this
the lot is very flat
 2. Notice the water line
is shown east of the drive

Grading Plan Approved
as shown and/or noted
THOMAS P. GILLETTE
Lake County Engineer
By 4/11 Date 12/2/92