

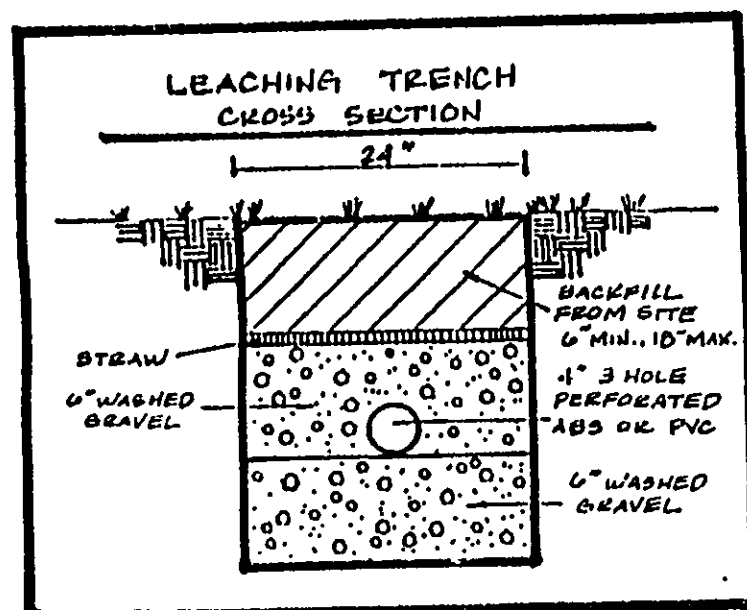


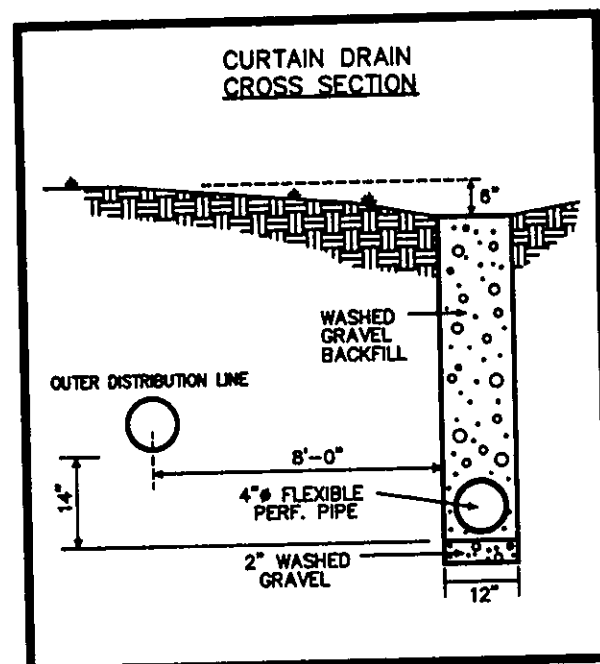


"I, the undersigned hereby certify that this topography indicated by 6", 1', or 2' contours, and elevations shown hereon represent an actual field survey made by me on the 27th day of Jan, 1999 and that the elevations were taken at appropriate intervals and that as of that date they existed as indicated hereon."

Harry Jones #6343
Name Reg. No.

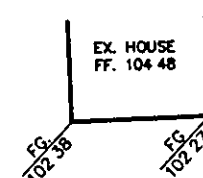

I. Pin Find (TBM)
ELEV. = 100.00

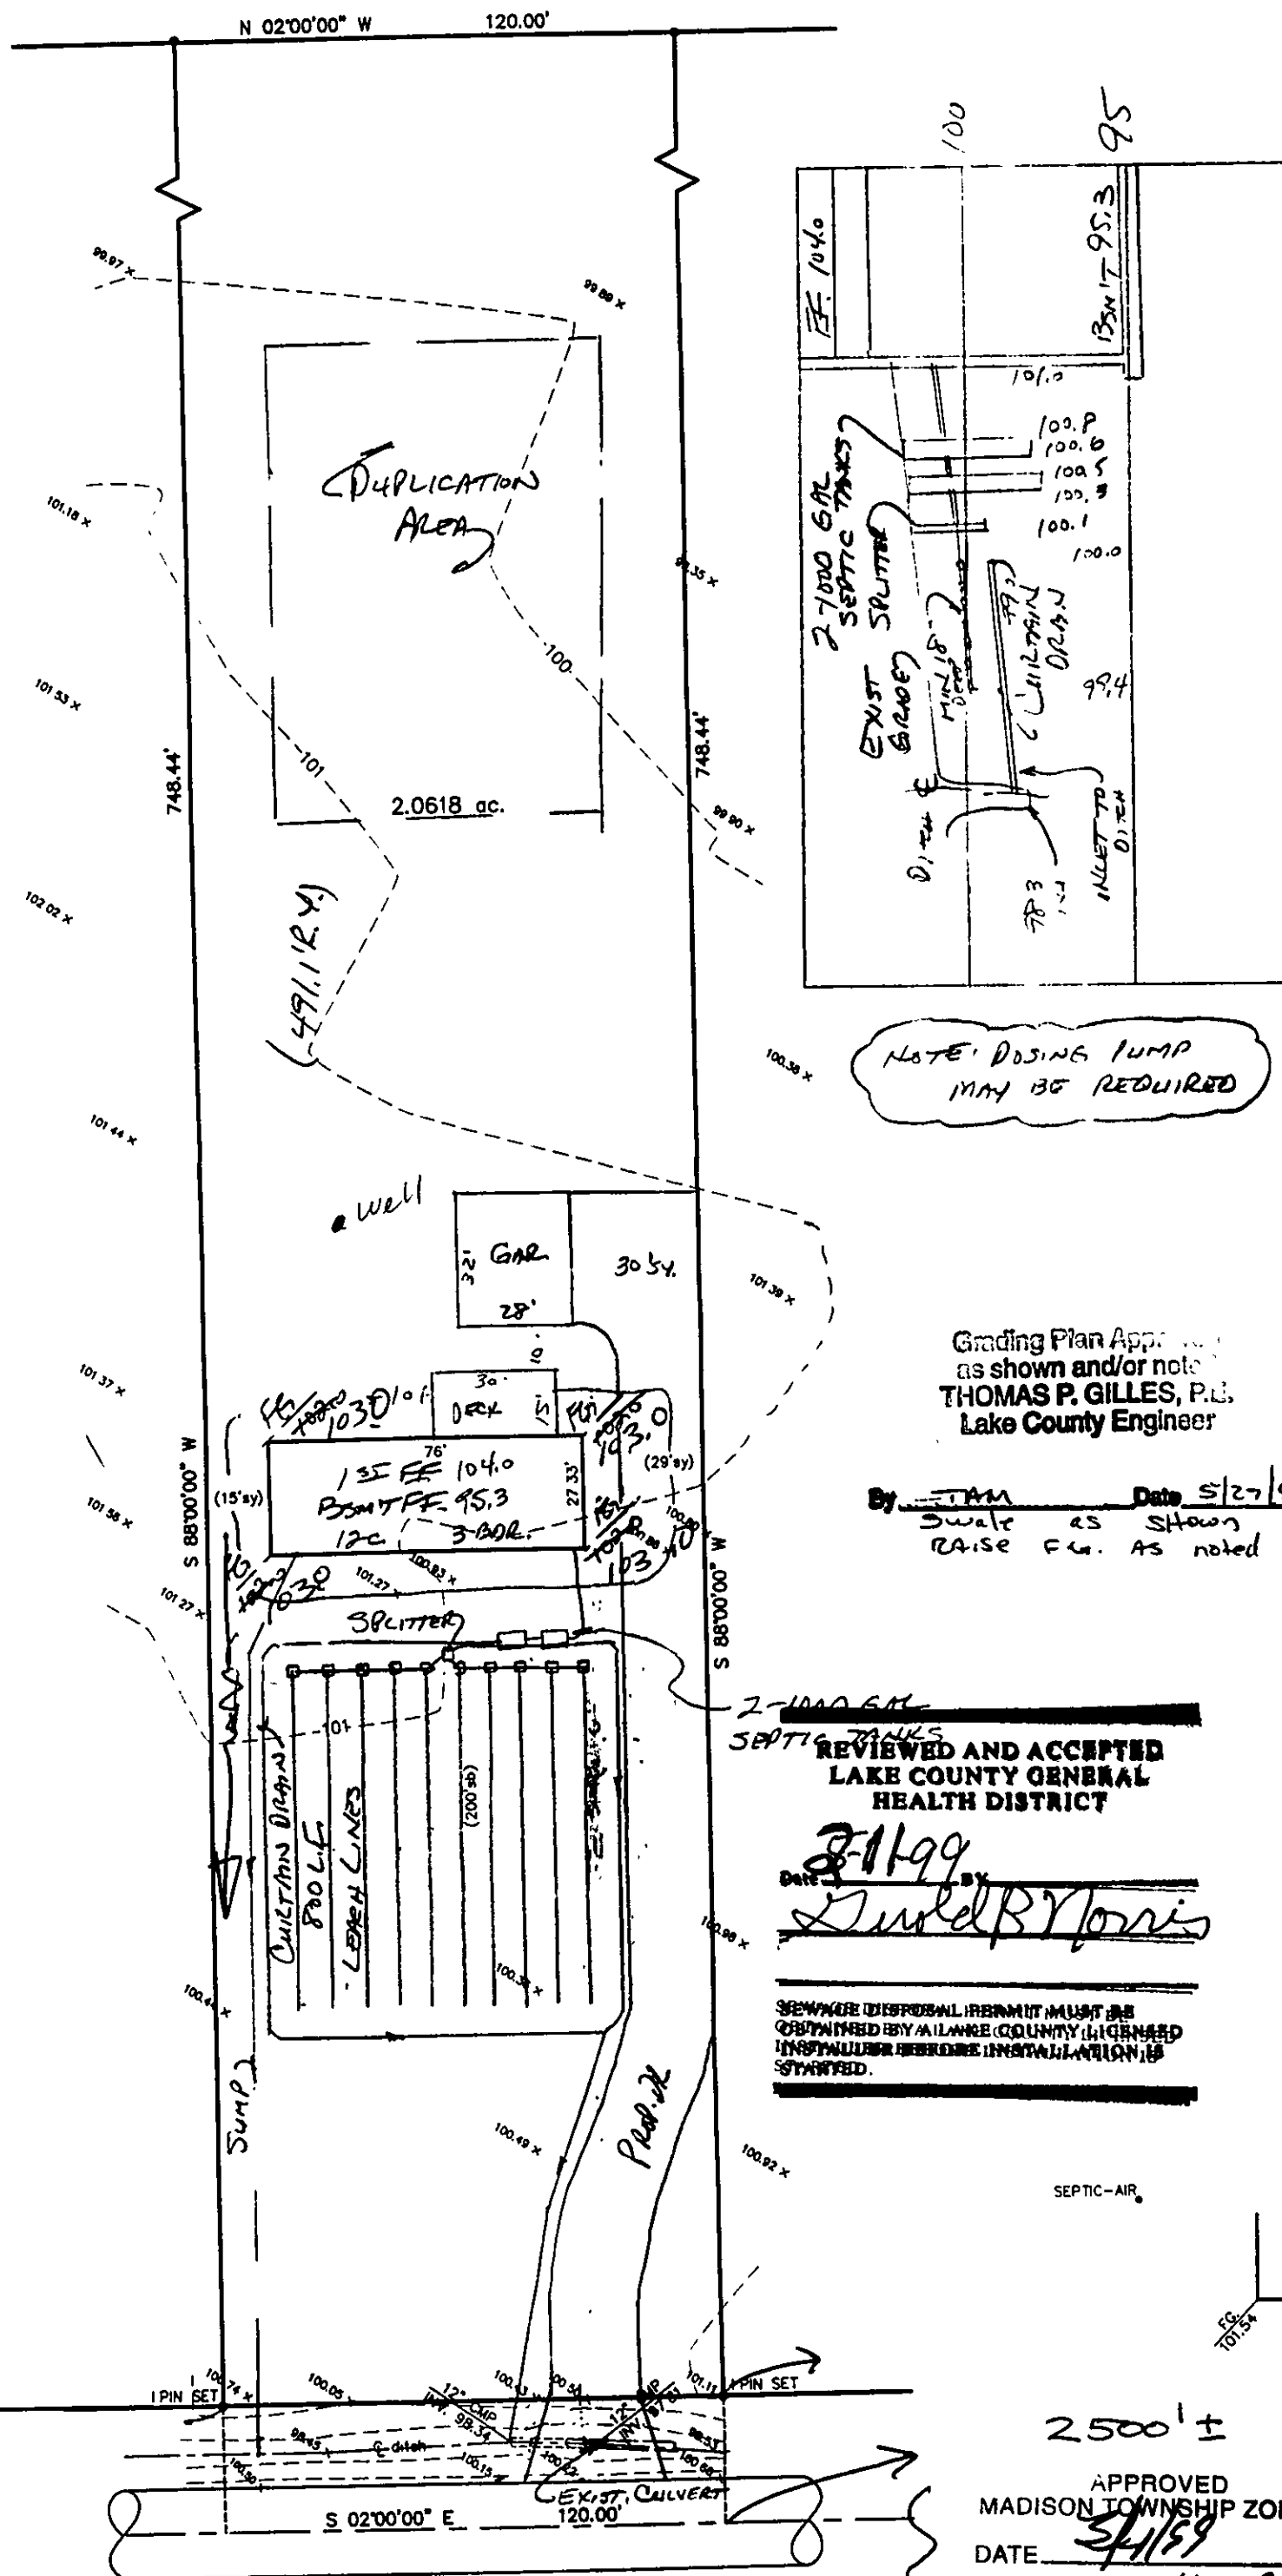

NOTE: DOSING PUMP
MAY BE REQUIRED

Grading Plan Approved
as shown and/or noted
THOMAS P. GILLES, P.E.
Lake County Engineer

By TAM Date 5/27/99
Sworn as shown
RAISE F.C. AS NOTED 1.0'

REVIEWED AND ACCEPTED
LAKE COUNTY GENERAL
HEALTH DISTRICT
3-11-99
Daniel R. Norris

SEWAGE DISPOSAL PERMIT MUST BE
OBTAINED BY A LAKE COUNTY LICENSED
INSTALLER BEFORE INSTALLATION IS
STARTED.

APPROVED
MADISON TOWNSHIP ZONING
DATE 5/1/99
BY CM 16083

COUNTY LINE ROAD - 60'

SITE PLAN

MADISON TOWNSHIP, LAKE COUNTY, OHIO

for: ED CLINE

CLIENT: ED CLINE OWNER: ED CLINE
ADDRESS: 2086 Carry Line STREET: CARRY LINE CITY: MADISON ZIP: 43080
SUBDIVISION: 2086 Carry Line NAME: ED CLINE TRACT: 100.0 COUNTY LINE: 100.0
VOL.-PG. 437-211 LOT: 100.0 STREET: CARRY LINE PERM. PARCEL NO.: 100.0

LEGEND

SANITARY MANHOLE: EXIST. ELEV. = 100.0 PROP. ELEV. = 100.0
STORM MANHOLE: AS BUILT ELEVATION
INLET OR CATCH BASIN:
HYDRANT: INDICATES
EXISTING CONTOURS: DIRECTION OF
PROPOSED CONTOURS: SURFACE DRAINAGE

REMARKS

ALL BOUNDARY DATA SHOWN WAS OBTAINED FROM (DEEDS, RECORDED SUBDIVISION PLAT OR OTHER PUBLIC RECORDS)

LOCATIONS AS SHOWN OF ADJACENT WELLS AND SEPTIC TANKS OBTAINED FROM LAKE COUNTY HEALTH DEPARTMENT

DESIGN CERTIFICATION

THIS PLAT WAS PREPARED BY ME, AND IS CORRECT TO THE BEST OF MY KNOWLEDGE AND BELIEF.

Harry Jones #6343
NAME SURVEYOR REGISTRATION NO.

CHECK LIST

NO. OF BEDROOMS: 3 WATER MAIN SIZE, LOCATION: 1/2" x 40'
DIMENSIONS: 10' x 10' SAN. SEWER SIZE: 1/2" x 40'
BEARINGS: 10' x 10' SAN. MH. CAST. ELEV. INV. ELEV.: 100.0
TIE TO NEAREST STREET: 10' x 10' SAN. CONN. SIZE, LOC. DEPTH: 10' x 10'
SUBLOT NO. PARCEL NO.: 100.0 STORM SEWER SIZE: 1/2" x 40'
SURROUNDING OWNERS: 10' x 10' STORM MH. CAST. ELEV. INV. ELEV.: 100.0
BLDG. DIMENSIONS FIN GR.: 10' x 10' PAVT TYPE GRADE CURBS: 10' x 10'
BLDG. TIES FL'R. GRADES: 10' x 10' GAS LINE LOC. SIZE PRESSURE: 10' x 10'
APRON TYPE WIDTH THICKNESS: 10' x 10' SEPTIC TANK LOCATION & DUPLICATION AREA: 10' x 10'
SIDEWALK TYPE WIDTH THICKNESS: 10' x 10' WELL LOCATION: 10' x 10'
CULVERT TYPE DIA. LENGTH: 10' x 10' ISOLATION RADIUS FROM WELL: 10' x 10'
ROCK OUTCROPPINGS: 10' x 10'

REVISIONS			PLAN PREPARED BY:		
NO.	DATE	BY	BABCOCK JONES & ASSOCIATES, INC.		
1	1/28/99	TR	PAINESVILLE, OHIO		
2	2/1/99	HT	DRAWN BY: T.R.	SCALE: 1" = 40'	PHONE NO. 440-357-1811
3	2/18/99	HT	CHK'D: H.J.	DATE: 9/21/98	DRAWING NO. 98-285
4			CREW: W.B.	APP'D: H.J.	
5			CHIEF: W.B.		

"AS BUILT" CERTIFICATION
I, HEREBY CERTIFY THAT THE CIRCLED GRADES ARE EXISTING
FINISH GRADES CHECKED IN THE FIELD ON 5/1/99, 19
AND ARE CORRECT TO THE BEST OF MY KNOWLEDGE AND BELIEF.

REGISTERED SURVEYOR

REG. NO.

TBM-TOP IRON PIN
ELEV. = 100.0

