


APPROVED
SIDE LINES & SET BACK
PERRY TOWNSHIP ZONING
PERMIT NO. 1349
ZONING INSPECTOR
Wallace D. Smith

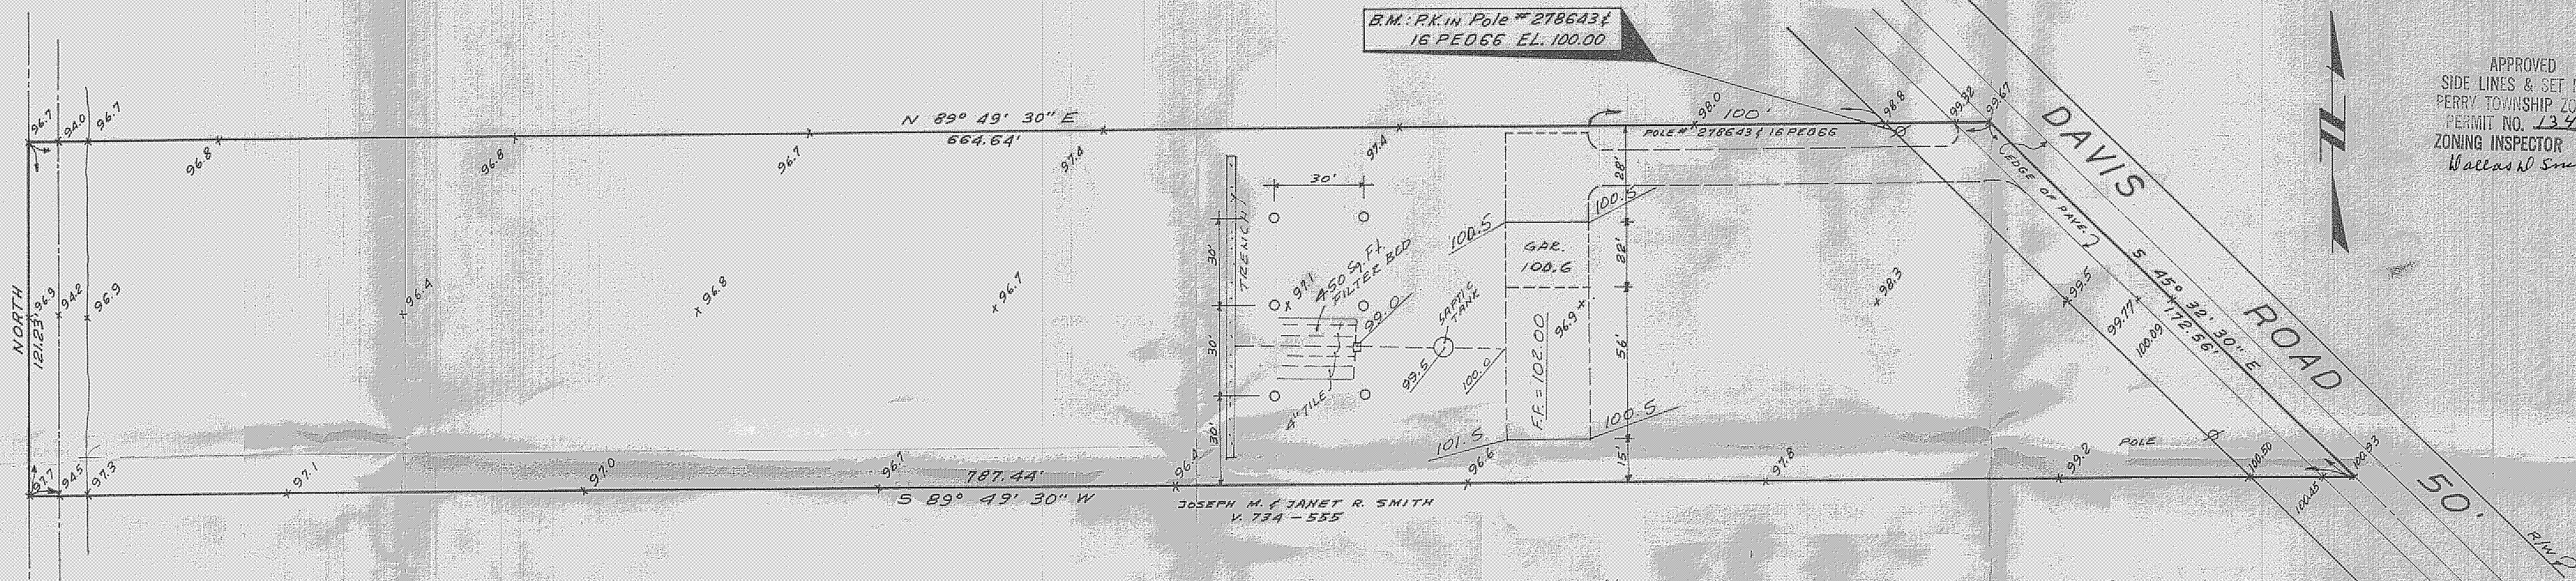

GRADING PLAN FOR JOHN W. BURNETT

PART OF LOT 52
PERRY TOWNSHIP, LAKE COUNTY, OHIO
SCALE: 1" = 30'
APRIL 1973

FULLERTON-KERR & ASSOC.
REG. ENGINEERS & SURVEYORS
180 S. STATE ST. TEL. 357-7569
PAINESVILLE - OHIO

"AS BUILT" CERTIFICATION
I HEREBY CERTIFY THAT CIRCLED GRADES
ARE EXISTING FINISH GRADES CHECKED
IN FIELD ON 19
SURVEY IS CORRECT TO THE BEST
OF MY KNOWLEDGE AND BELIEF
REG. SURVEYOR NO.

