


WILLIAM F. & NANCY K. HENDRICKS
VOL #1156-1049

VACANT
ANDREW & JULIE WILSON
VOL #1117-569

PARCEL #18
0.5897 ACRES

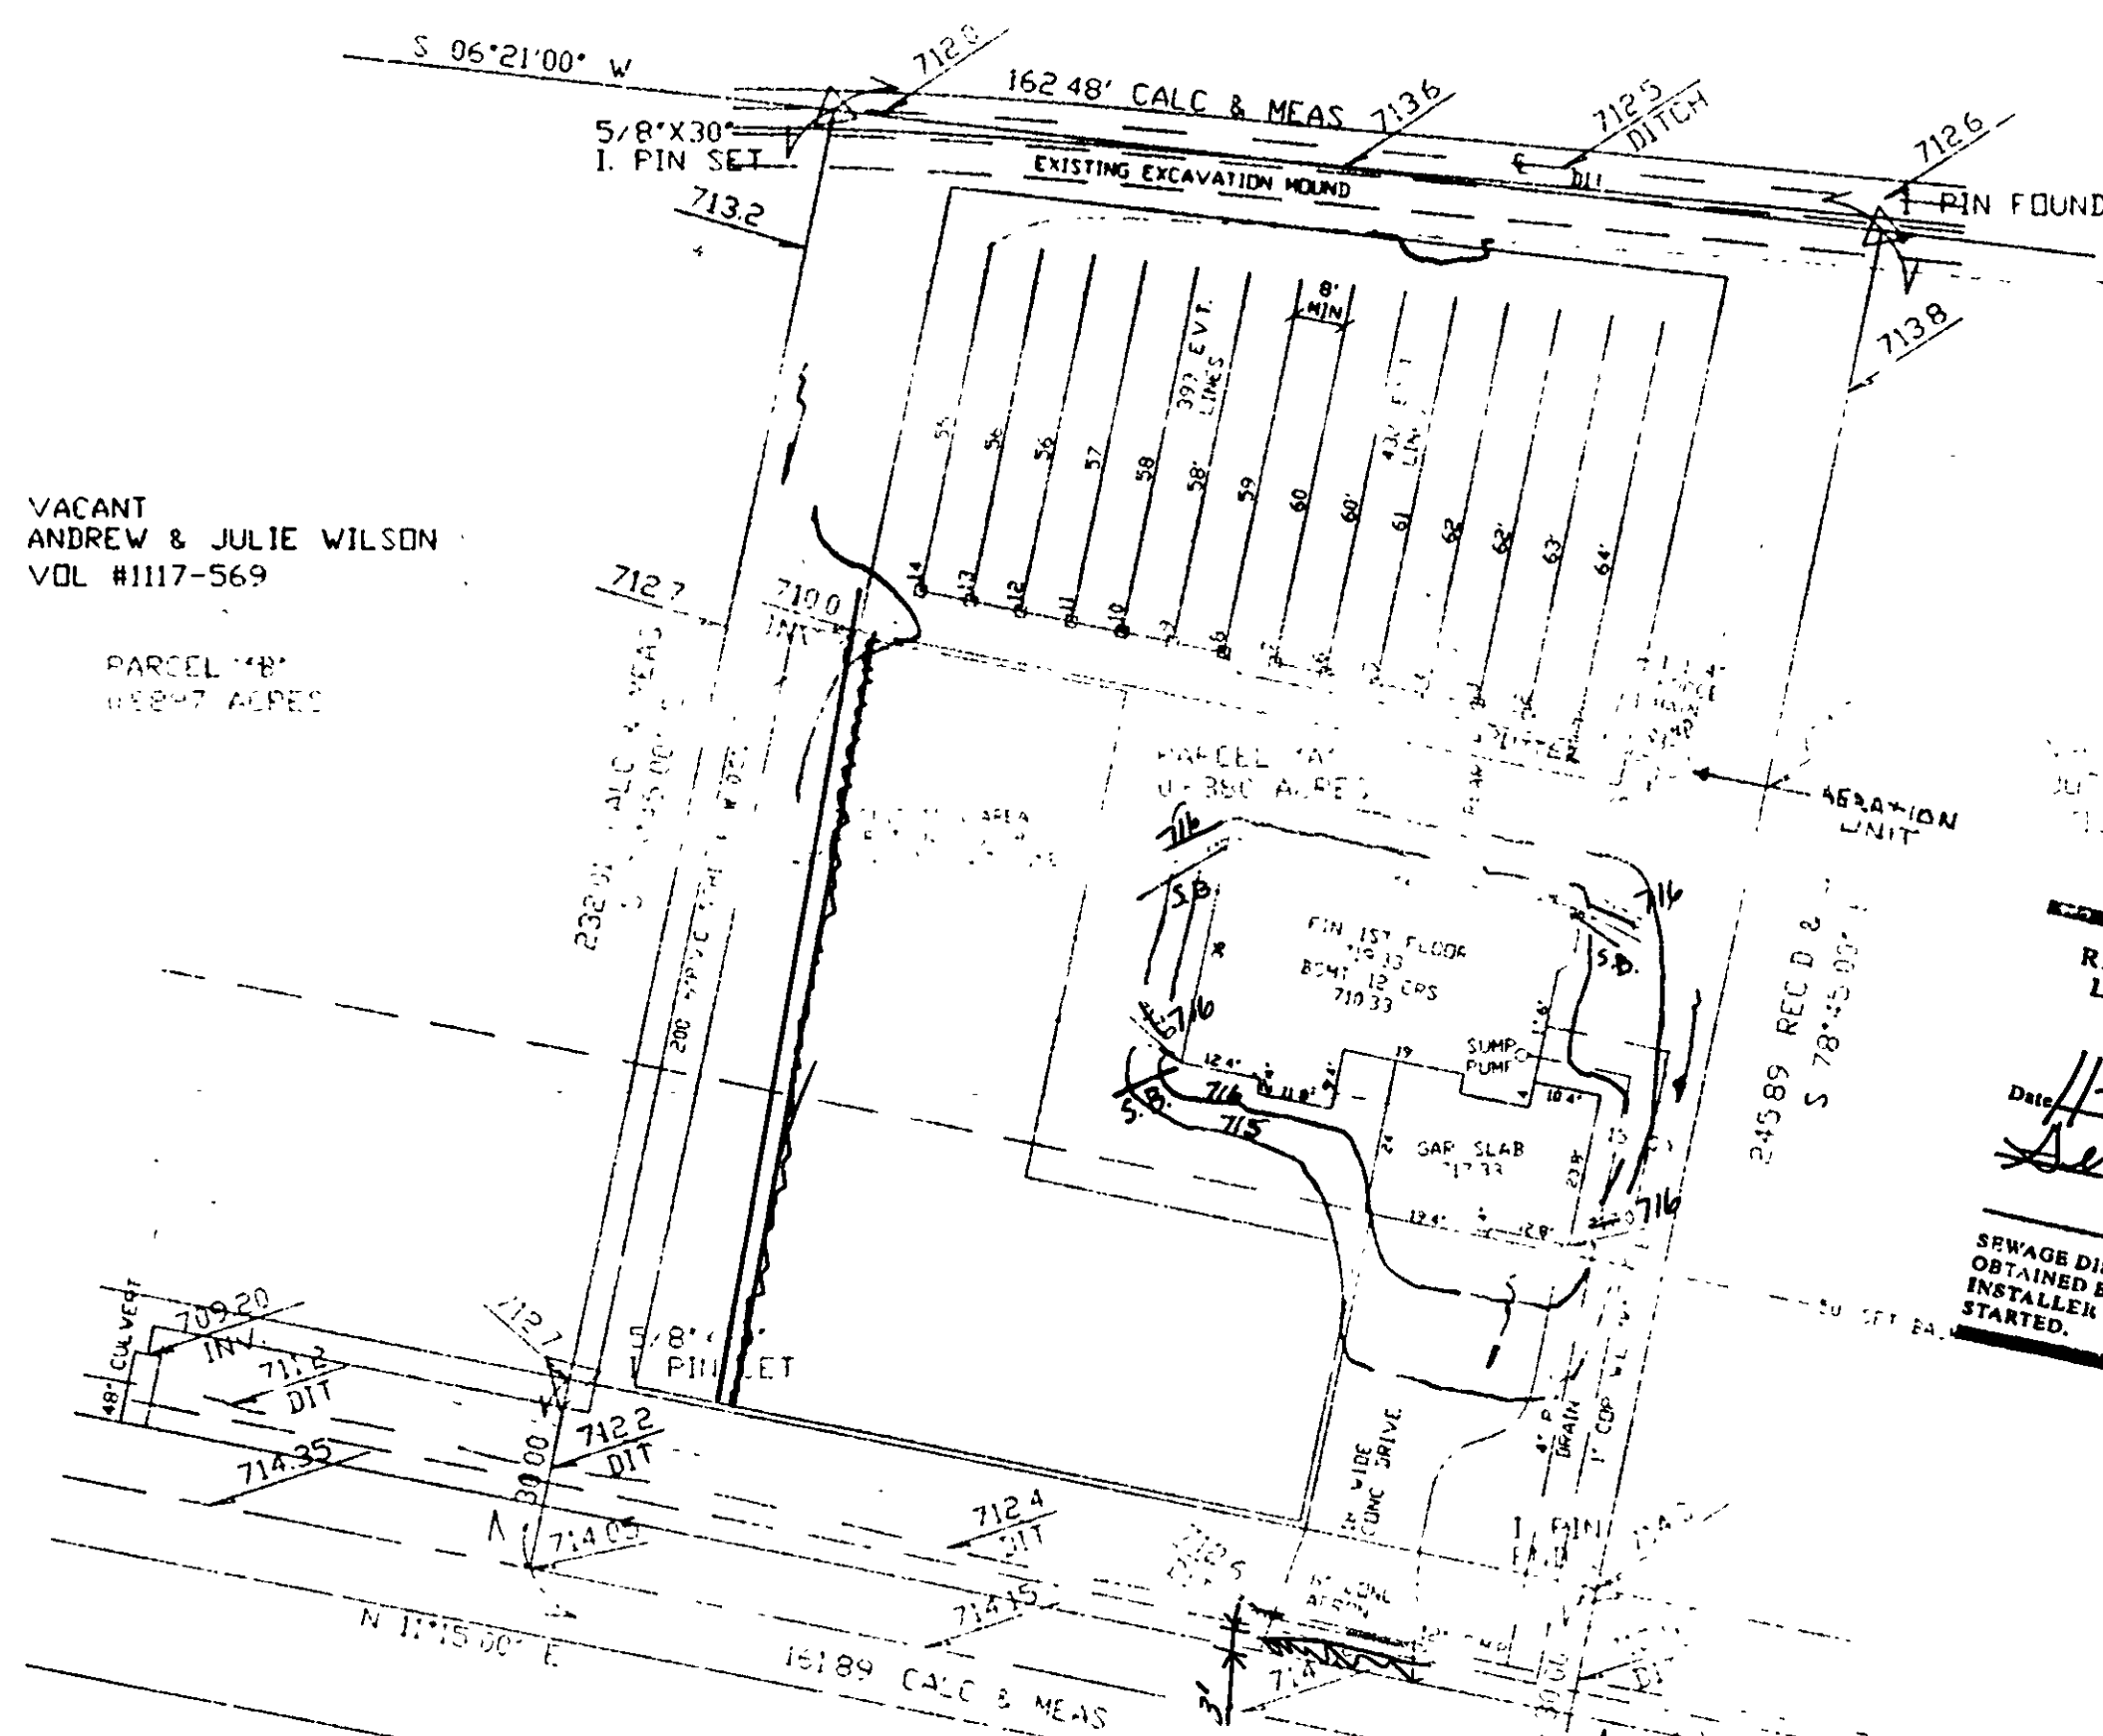


REVIEWED AND ACCEPTED
LAKE COUNTY GENERAL
HEALTH DISTRICT

DATE 11-4-99 BY
S. B. Norris
SEWAGE DISPOSAL PERMIT MUST BE
OBTAINED BY A LAKE COUNTY LICENSED
INSTALLER BEFORE INSTALLATION IS
STARTED.

BENCHMARK
TOP OF HIVERMONT
WELL


SOUTH RIDGE 60'

DAVIS ROAD 60'

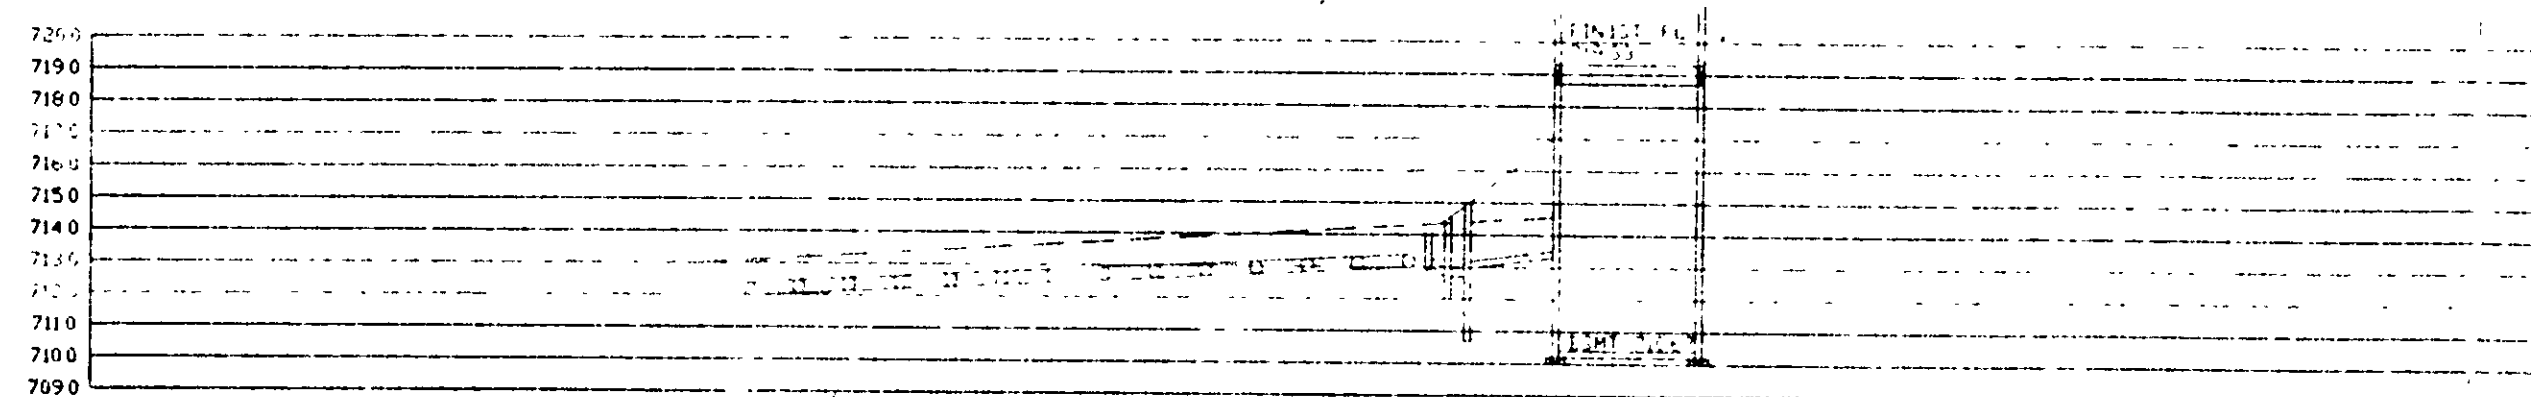

PROFILE

11-4-99
V. B. Norris

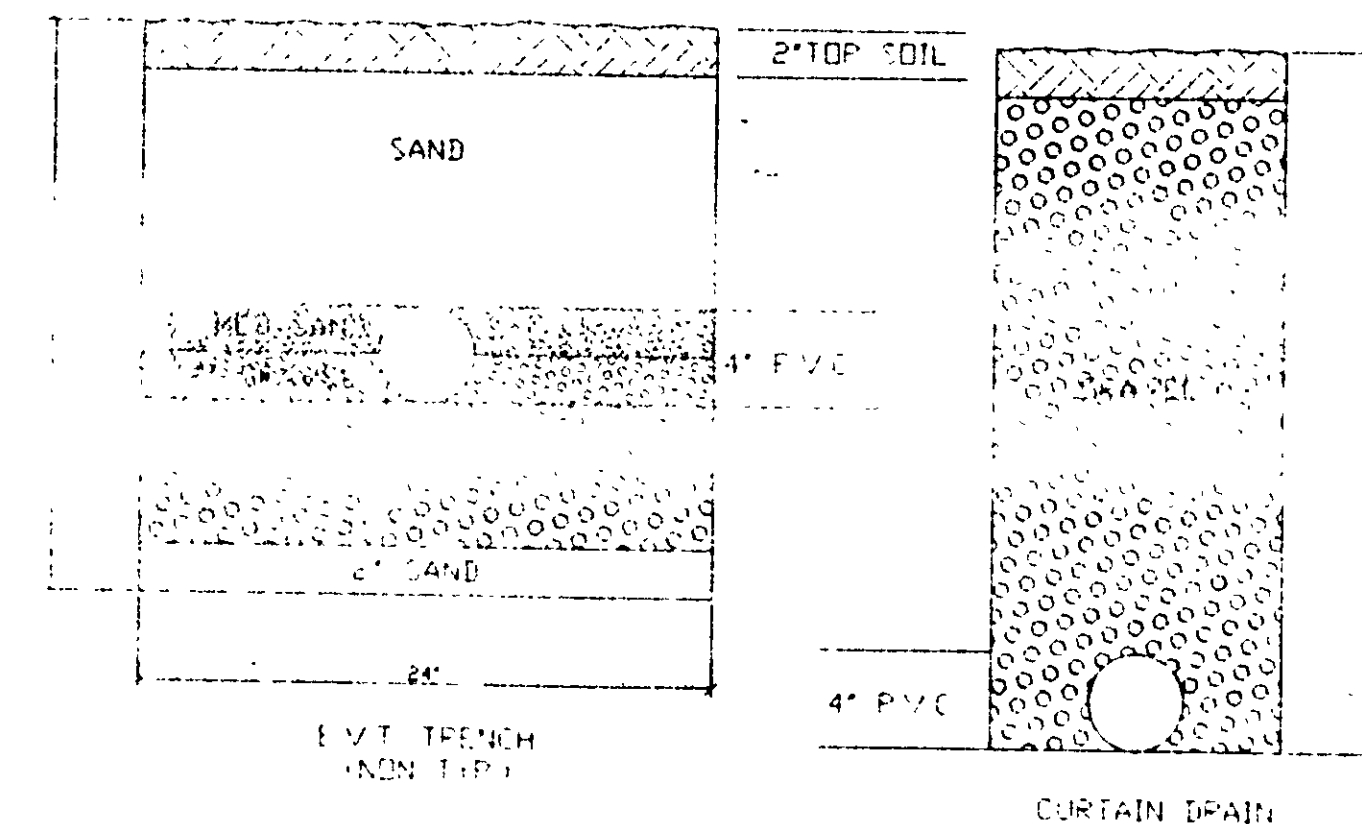

APPROVED
SIDE LINES & SET BACK
PERRY TOWNSHIP ZONING
PERMIT NO. 6927
ZONING INSPECTOR

Grading Plan Approved
as shown and/or noted
THOMAS P. GILLES, P.E.
Lake County Engineer

- By T. P. Gilles Date 12/1/99
1. Lower E.G. TO 716.00
 2. CONCRETE DRIVE SHALL END 3' FROM
DANS ROAD. FILL VOID WITH ASPHALT
OR STONE
 3. A PERMIT FROM LAKE County Engineer will have
be required for work within 12/1/99

11-3-99 MODIFY DUPLICATION AREA

I, THE UNDERSIGNED, HEREBY CERTIFY THAT THIS
SURVEY WAS MADE BY ME OR BY A LICENSED SURVEYOR
AND THAT THE SAME IS A TRUE AND CORRECT
INTERVAL AND AS OF THAT DAY THEY EXISTED AS
INDICATED HEREON.

I HEREBY CERTIFY THAT THIS PLAN WAS PREPARED
BY ME FROM AN ACTUAL SURVEY OF THE PROPERTY AND
THAT I AM A LICENSED SURVEYOR AND THAT I AM
NOT A PART OF THE PROPERTY OWNERS' INTEREST.


By T. P. Gilles
P.E. NO. 6356

2 WORKING DAYS
BEFORE YOU DIG
CALL TOLL FREE 800-362-2764
OHIO UTILITIES PROTECTION SERVICE

EXISTING GRADED
PROPOSED

SCALE

GRAPHIC SCALE

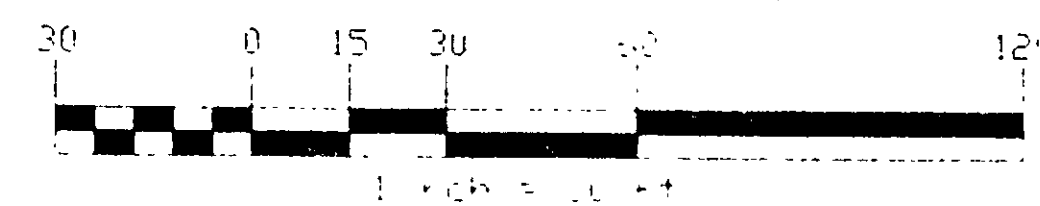

SITE PLAN FOR:
ANDREW WILSON

SCALE 1" = 30'

DATE OCT 99

REVISIONS

NO. 99-2467

DRAWN BY CWC

REVIEWED

DATE OF REVIEW

11-4-99