

Grading Plan Approved
as shown and/or noted
THOMAS P. GILLES, P.E.
Lake County Engineer

By Tam Date 7/13/00
**ROOF DRAINS
SHALL DISCHARGE
TO SPLASH BLOCKS.**

REVIEWED AND ACCEPTED
LAKE COUNTY GENERAL
HEALTH DISTRICT

Date 7-5-00
Amel B. Novis

SEWAGE DISPOSAL PERMIT MUST BE
OBTAINED BY A LAKE COUNTY LICENSED
INSTALLER BEFORE INSTALLATION IS
STARTED.

3A-72-40
(vacant)

APPROVED
SIDE LINES & SET BACK
PERRY TOWNSHIP ZONING
PERMIT NO. 6997
ZONING INSPECTOR

SITE PLAN

PERRY TOWNSHIP, LAKE COUNTY, OHIO
for: GORDON WANWEK

ADDRESS	STREET	CITY	ZIP
SUBDIVISION	NAME	TRACT	DAVIS RD.
VOL.-PG.	LOT	LOT	STREET
SUBLOT NO.	STREET	VOL.-PG.	3A-72-45
			PERM. PARCEL NO.

LEGEND

SANITARY MANHOLE	---○---	EXIST. ELEV. <u>100.0</u>	PROP. ELEV. <u>100.0 ±</u>
STORM MANHOLE	---●---	AS BUILT ELEVATION	
INLET OR CATCH BASIN	---○---	INDICATES	
HYDRANT	---○---	DIRECTION OF	
EXISTING CONTOURS	---○---	SURFACE DRAINAGE	
PROPOSED CONTOURS	---○---		

REMARKS
ALL BOUNDARY DATA SHOWN WAS OBTAINED FROM (DEEDS, RECORDED
SUBDIVISION PLAT OR OTHER PUBLIC RECORDS)
LOCATIONS AS SHOWN OF ADJACENT WELLS AND SEPTIC TANKS OBTAINED FROM
LAKE COUNTY HEALTH DEPARTMENT

DESIGN CERTIFICATION
THIS PLAT WAS PREPARED BY ME, AND IS CORRECT
TO THE BEST OF MY KNOWLEDGE AND BELIEF
Amel B. Novis *6343
NAME SURVEYOR REGISTRATION NO.

CHECK LIST

NO. OF BEDROOMS	WATER MAIN SIZE, LOCATION
DIMENSIONS	SAN. SEWER SIZE & GR. LOC.
BEARINGS	SAN. MH. CAST. ELEV. INV. ELEV.
TIE TO NEAREST STREET	SAN. CONN. SIZE, LOC. DEPTH
SUBLOT NO. PARCEL NO.	STORM SEWER SIZE & GR. LOC.
SURROUNDING OWNERS	STORM MH. CAST. ELEV. INV. ELEV.
BLDG. DIMENSIONS FIN GR.	PAVT TYPE GRADE CURBS
BLDG. TIES FLTR. GRADES	GAS LINE LOC. SIZE PRESSURE
APRON TYPE WIDTH THICKNESS	SEPTIC TANK LOCATION & DUPLICATION AREA
SIDEWALK TYPE WIDTH THICKNESS	WELL LOCATION
CULVERT TYPE DIA. LENGTH	ISOLATION RADIUS FROM WELL
ROCK OUTCROPPINGS	


NO.	DATE	BY
1		
2		
3		
4		
5		

PLAN PREPARED BY:
Bj BABCOCK · JONES & ASSOCIATES, INC.
PAINESVILLE, OHIO

DRAWN BY T.R.	SCALE 1"=30'	PHONE NO. 440-357-1811
CHK'D. H.J.	DATE 5/1/00	DRAWING NO.
CREW W.B.	APP'D H.J.	00-111

"AS BUILT" CERTIFICATION
I, HEREBY CERTIFY THAT THE CIRCLED GRADES ARE EXISTING
FINISH GRADES CHECKED IN THE FIELD ON 5/1/00, 20
AND ARE CORRECT TO THE BEST OF MY KNOWLEDGE AND BELIEF.

REGISTERED SURVEYOR
REG. NO.
BM-IRON PIN FOUND
ELEV.=100.00

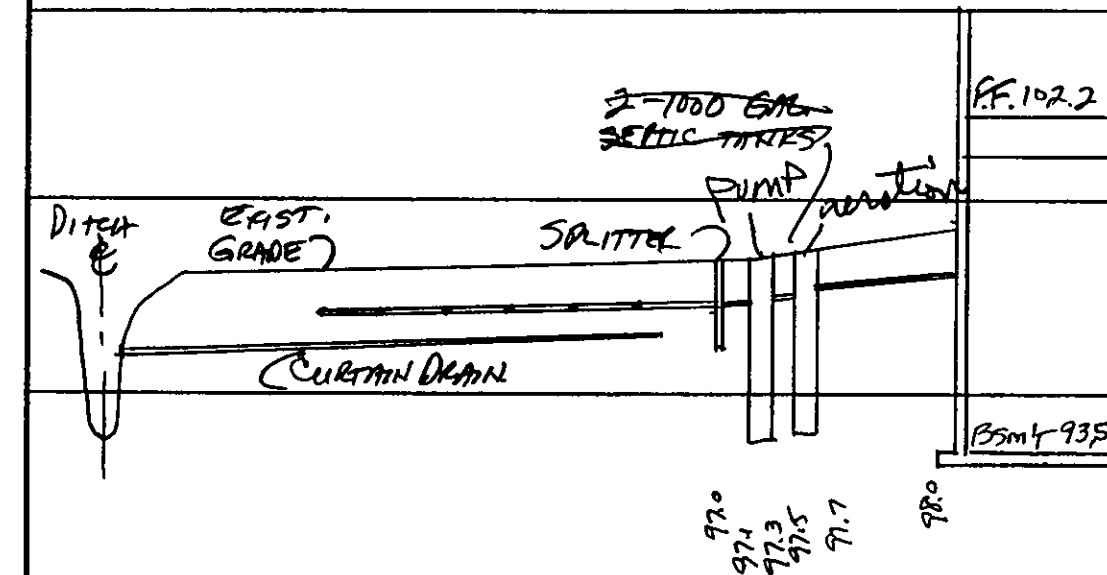

DAVIS ROAD - 60'

HYDRAULIC PROFILE
HORIZ: 1"=30' VERT: 1"=5'

"I, the undersigned hereby certify that
this topography indicated by 6", 1", or 2'
contours, and elevations shown hereon
represent an actual field survey made by
me on the 31st day of MAY, 20 00
and that the elevations were taken at
appropriate intervals and that as of that
date they existed as indicated hereon."

Amel B. Novis *6343
Name Reg. No.

