


APPROVED
SIDE LINES & SET BACK
PERRY TOWNSHIP ZONING
PERMIT NO. 7360
ZONING INSPECTOR


WILLIAM & NANCY HENDRICKS
VOL. 1156 - PG. 1049
3A-72-7

GORDON & KRISTIN WANYEK
DOC.# 200013257
3A-72-45

BRAD & DAWN BUBONIC
DOC.# 980050678
3A-72-46

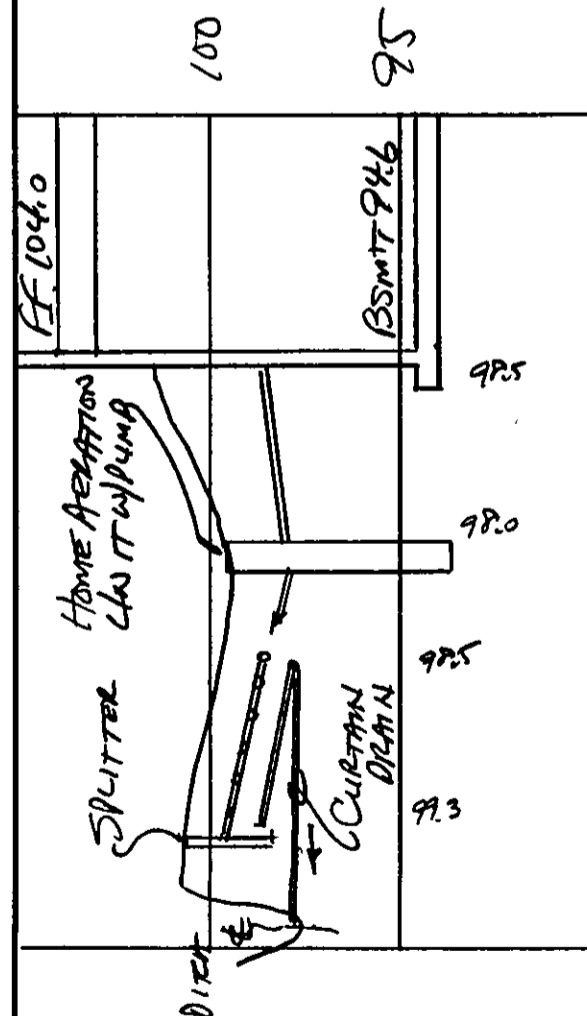

HYDRAULIC PROFILE
H/PZ-11 1/2" VERT 1" = 5'

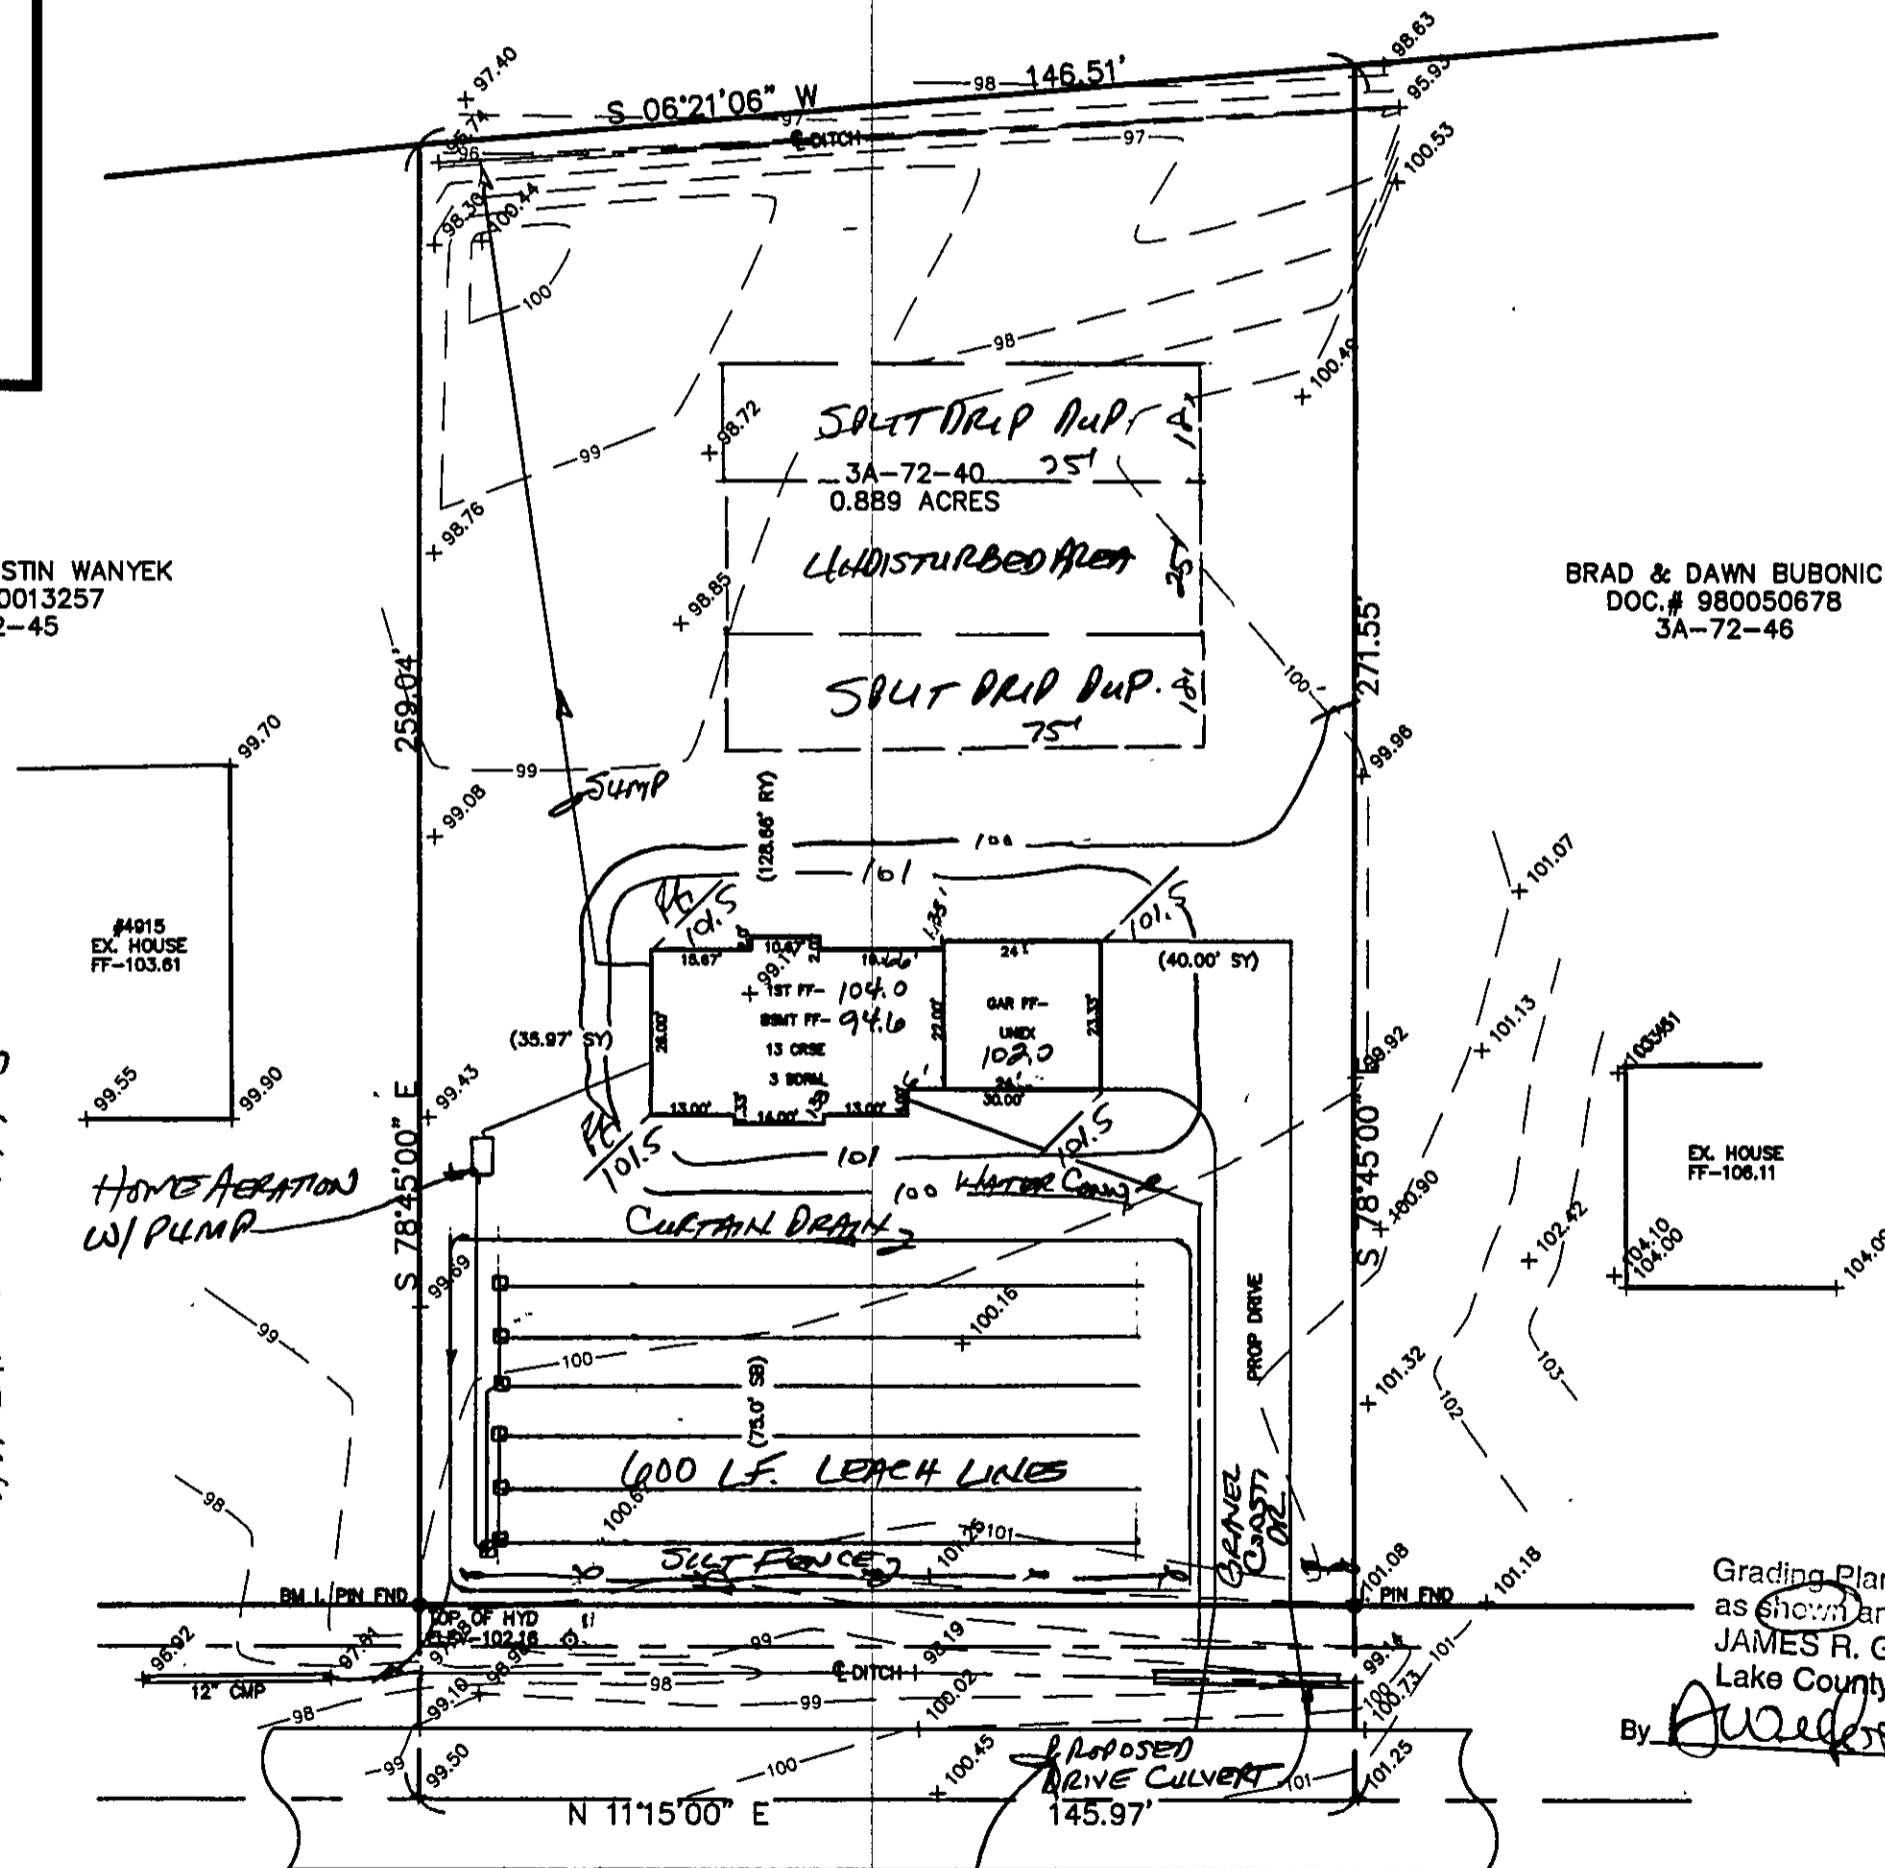

BM IRON PIN FOUND
ELEV-100.00

DAVIS ROAD - 60'

Grading Plan Approved
as shown and/or noted
JAMES R. GILLS, P.E.
Lake County Engineer
By [Signature] Date 3/27/2003

SITE PLAN

PERRY TOWNSHIP, LAKE COUNTY, OHIO

for: STADEN HOMES

CLIENT OWNER
ADDRESS STREET CITY ZIP

SUBDIVISION NAME TRACT STREET
VOL-PG. DAVIS ROAD LOT 3A-72-40
SUBLOT NO. STREET VOL-PG. PERM. PARCEL NO.

LEGEND

SANITARY MANHOLE --- ○ --- EXST. ELEV. 100.0 PROP. ELEV. 100.0
STORM MANHOLE --- ● --- AS BUILT ELEVATION
INLET OR CATCH BASIN --- □ --- INDICATES DIRECTION OF SURFACE DRAINAGE
HYDRANT --- ○ ---
EXISTING CONTOURS --- - - - - -
PROPOSED CONTOURS --- - - - - -

REMARKS

ALL BOUNDARY DATA SHOWN WAS OBTAINED FROM (DEEDS, RECORDED SUBDIVISION PLAT OR OTHER PUBLIC RECORDS)

LOCATIONS AS SHOWN OF ADJACENT WELLS AND SEPTIC TANKS OBTAINED FROM LAKE COUNTY HEALTH DEPARTMENT

DESIGN CERTIFICATION

THIS PLAT WAS PREPARED BY ME, AND IS CORRECT TO THE BEST OF MY KNOWLEDGE AND BELIEF.

NAME [Signature] SURVEYOR REGISTRATION NO. 6343

CHECK LIST

NO. OF BEDROOMS	WATER MAIN SIZE, LOCATION
DIMENSIONS	SAN. SEWER SIZE & OR. LOC.
BEARINGS	SAN. MH. CAST. ELEV. INV. ELEV.
TIE TO NEAREST STREET	SAN. CONN. SIZE, LOC. DEPTH
SUBLOT NO. PARCEL NO.	STORM SEWER SIZE & OR. LOC.
SURROUNDING OWNERS	STORM MH. CAST ELEV. INV. ELEV.
BLDG. DIMENSIONS FIN GR.	PAV'T TYPE GRADE CURBS
BLDG. TIEB FLTR. GRADES	GAS LINE LOC. SIZE PRESSURE
APRON TYPE WIDTH THICKNESS	SEPTIC TANK LOCATION & DUPLICATION AREA
SIDEWALK TYPE WIDTH THICKNESS	WELL LOCATION
CULVERT TYPE DIA., LENGTH	ISOLATION RADIUS FROM WELL
ROCK OUTCROPPINGS	

REVISIONS			PLAN PREPARED BY:		
NO.	DATE	BY	Bj BABCOCK · JONES & ASSOCIATES, INC.		
1	3/5/03	HW	PAINESVILLE, OHIO		
2			DRAWN BY N.S.	SCALE 1"=30'	PHONE NO. 440-367-1811
3			CHK'D. H.J.	DATE 2/28/03	DRAWING NO. 03-031
4			CREW W.B.	APP'D H.J.	
5					

"AS BUILT" CERTIFICATION
I, HEREBY CERTIFY THAT THE CIRCLED GRADES ARE EXISTING FINISH GRADES CHECKED IN THE FIELD ON 2/28/03, 20 AND ARE CORRECT TO THE BEST OF MY KNOWLEDGE AND BELIEF.

REGISTERED SURVEYOR REG. NO.

"I, the undersigned hereby certify that this topography indicated by 6", 1", or 2' contours, and elevations shown hereon represent an actual field survey made by me on the 27 day of Feb, 2003 and that the elevations were taken at appropriate intervals and that as of that date they existed as indicated hereon."

By [Signature] Date 3/27/2003
Name [Signature] Reg. No. 6343

EXISTING UTILITIES NOTE:
THE SIZE AND LOCATION, BOTH HORIZONTAL AND VERTICAL OF THE UNDERGROUND UTILITIES SHOWN HEREON, HAVE BEEN OBTAINED BY A SEARCH OF AVAILABLE RECORDS. VERIFICATION BY FIELD OBSERVATION HAS BEEN CONDUCTED WHERE PRACTICAL, HOWEVER, BABCOCK, JONES AND ASSOCIATES INC. DOES NOT GUARANTEE THE COMPLETENESS NOR ACCURACY THEREOF.

