



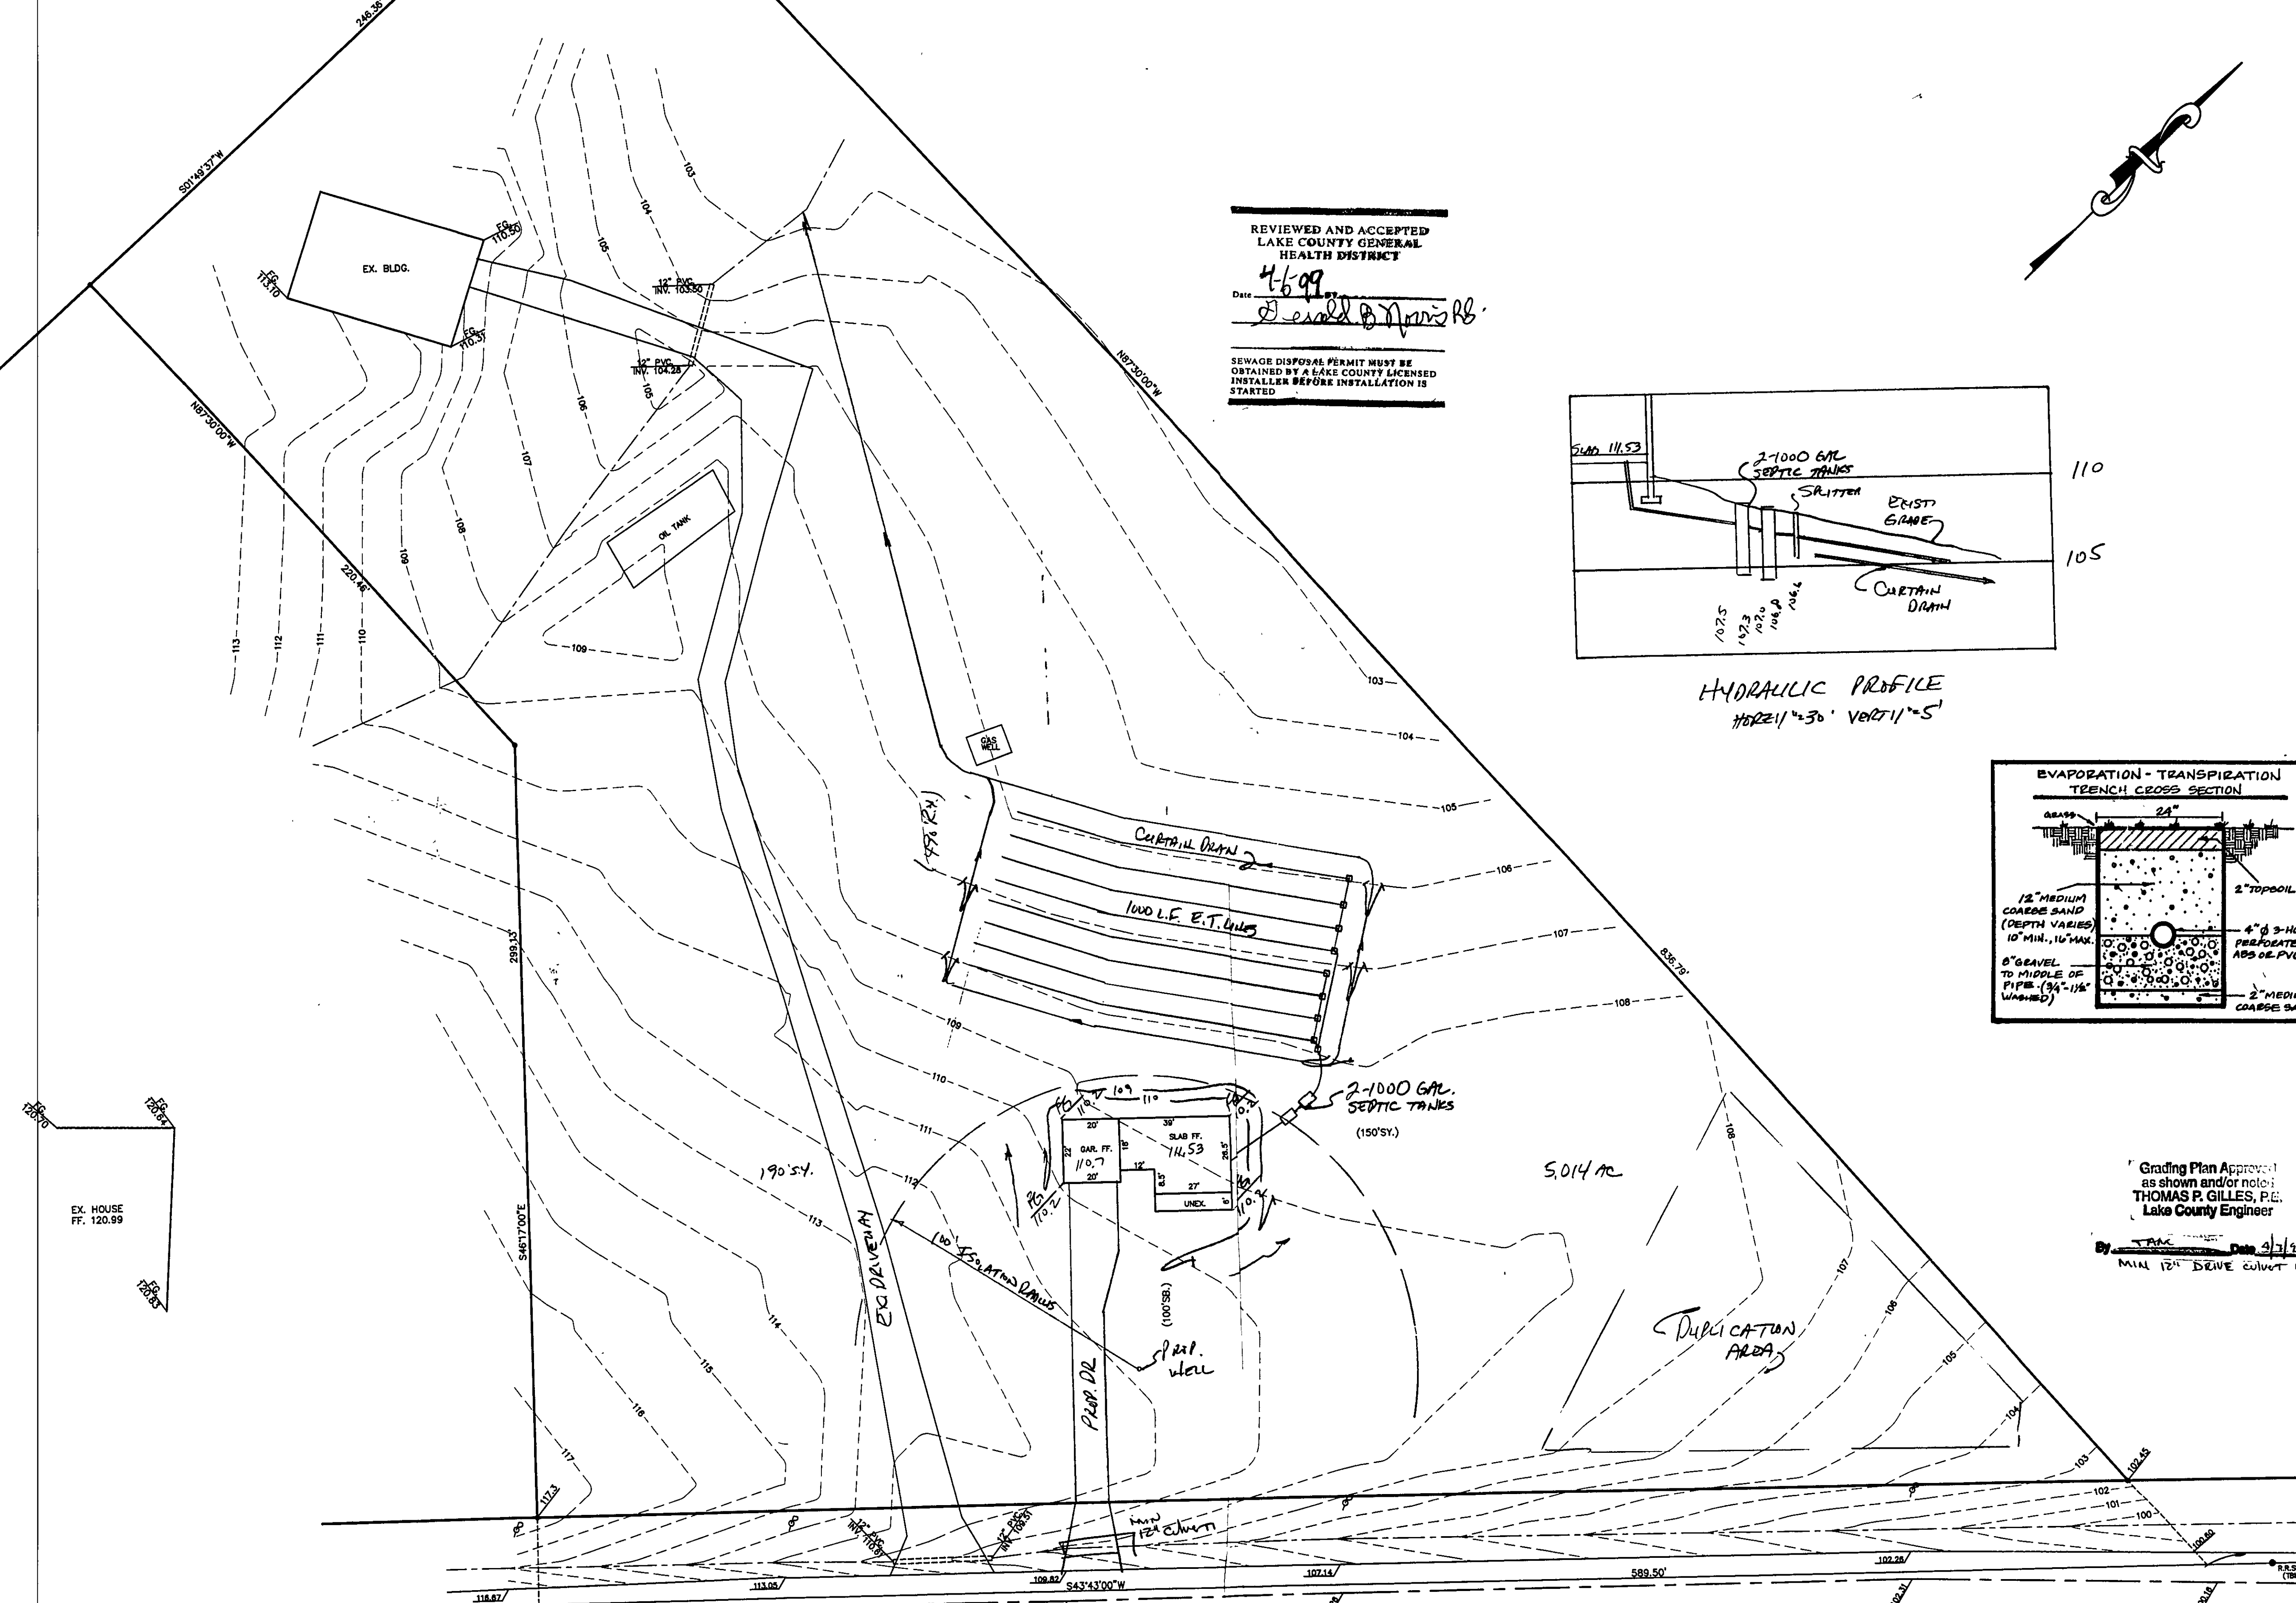



REVIEWED AND ACCEPTED
LAKE COUNTY GENERAL
HEALTH DISTRICT

Date: 4/6/99
Desal B. Norris R.B.

SEWAGE DISPOSAL PERMIT MUST BE
OBTAINED BY A LAKE COUNTY LICENSED
INSTALLER BEFORE INSTALLATION IS
STARTED

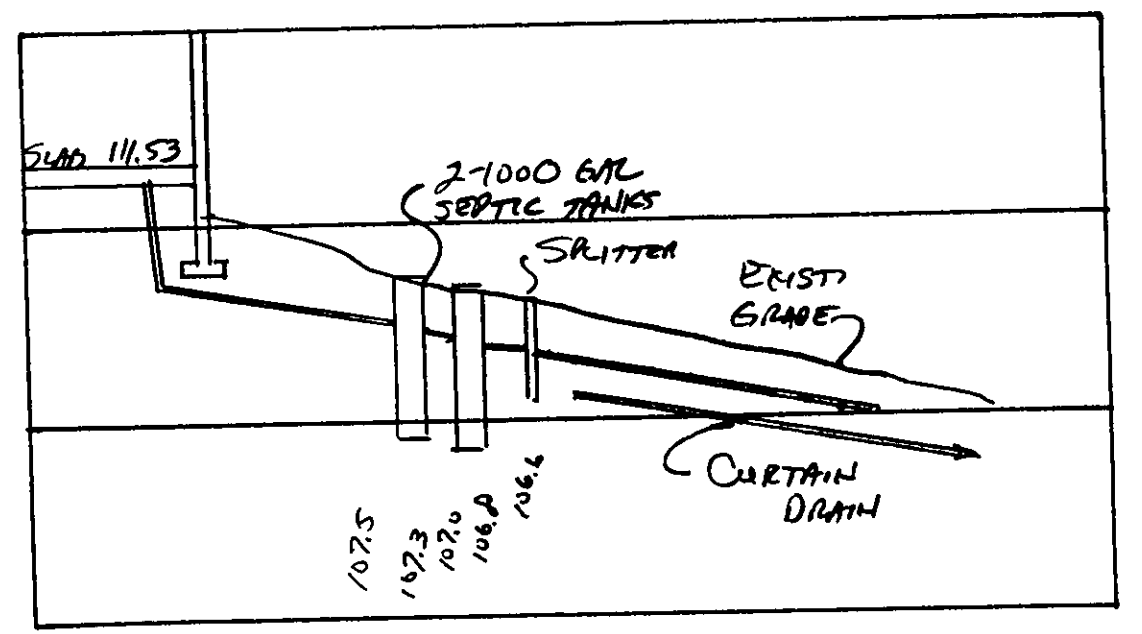

HYDRAULIC PROFILE
HORIZ 1"=30' VERT 1"=5'

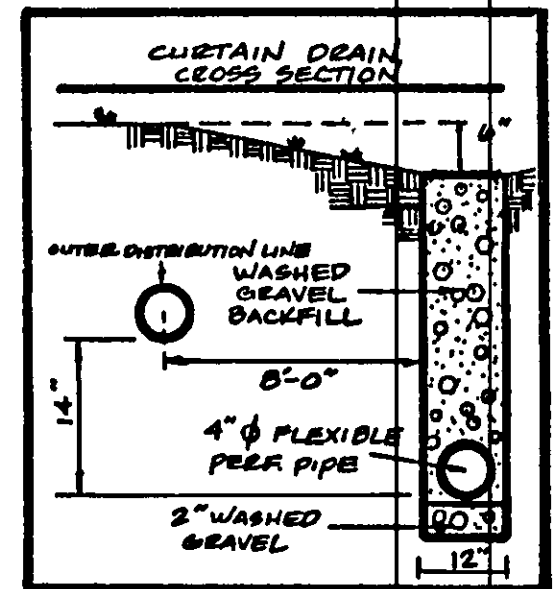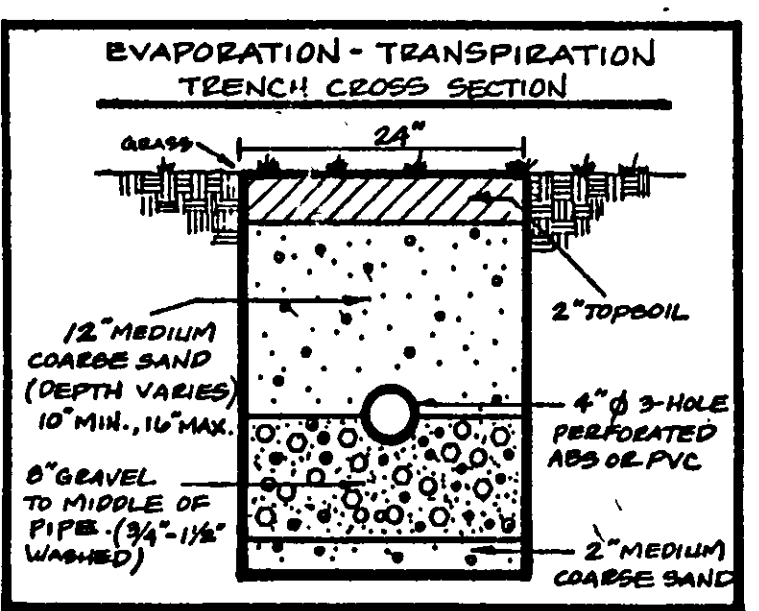


Grading Plan Approved
as shown and/or noted:
THOMAS P. GILLES, P.E.
Lake County Engineer

By: [Signature] Date: 3/1/99
MIN 12\"/>

"I, the undersigned hereby certify that
this topography indicated by 6\", 1\"/>

Name: [Signature] Reg. No. 26343

APPROVED
MADISON TOWNSHIP ZONING
DATE: 6/8/98
BY: [Signature]

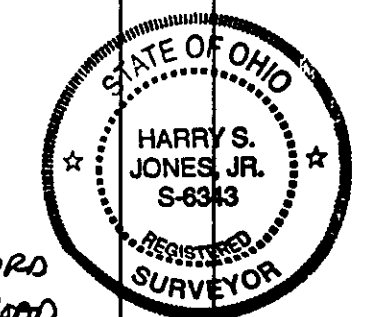

TBM - R.R. SPIKE
ELEV. = 100.00

REV. NO.	DESCRIPTION	DATE	BY	CHK'D

bj BABCOCK, JONES AND ASSOCIATES, INC
CIVIL ENGINEERS - SURVEYORS - LAND PLANNERS
PAINESVILLE OHIO 44077

DATE: 4/7/98
DESIGN BY: H.J.
DRAWN BY: T.R.
APPROVED BY: H.J.

MADISON TWP.

SITE PLAN
FOR
TERRY NEELY

LAKE COUNTY

SCALE: 1"=30'
JOB NO: 98-039
SHEET 1 OF 1