

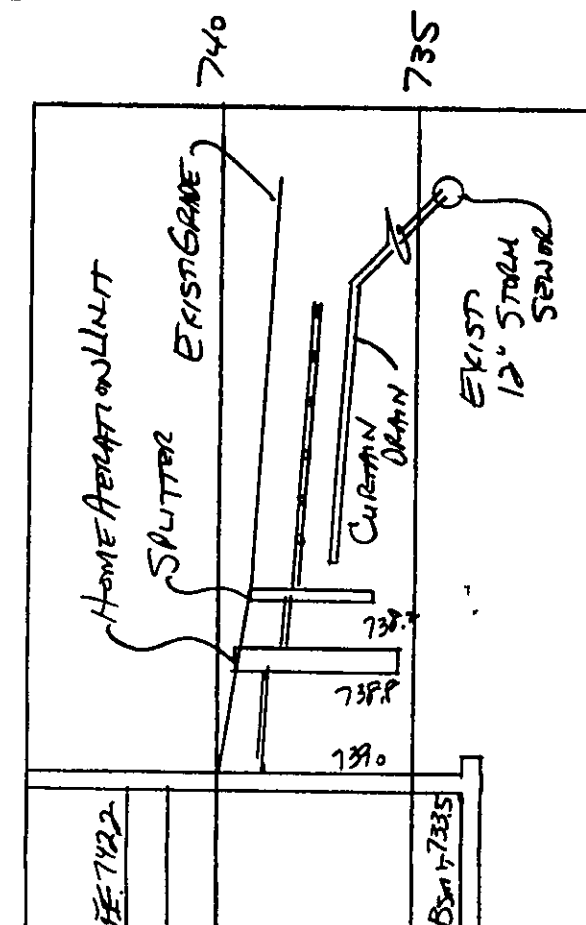
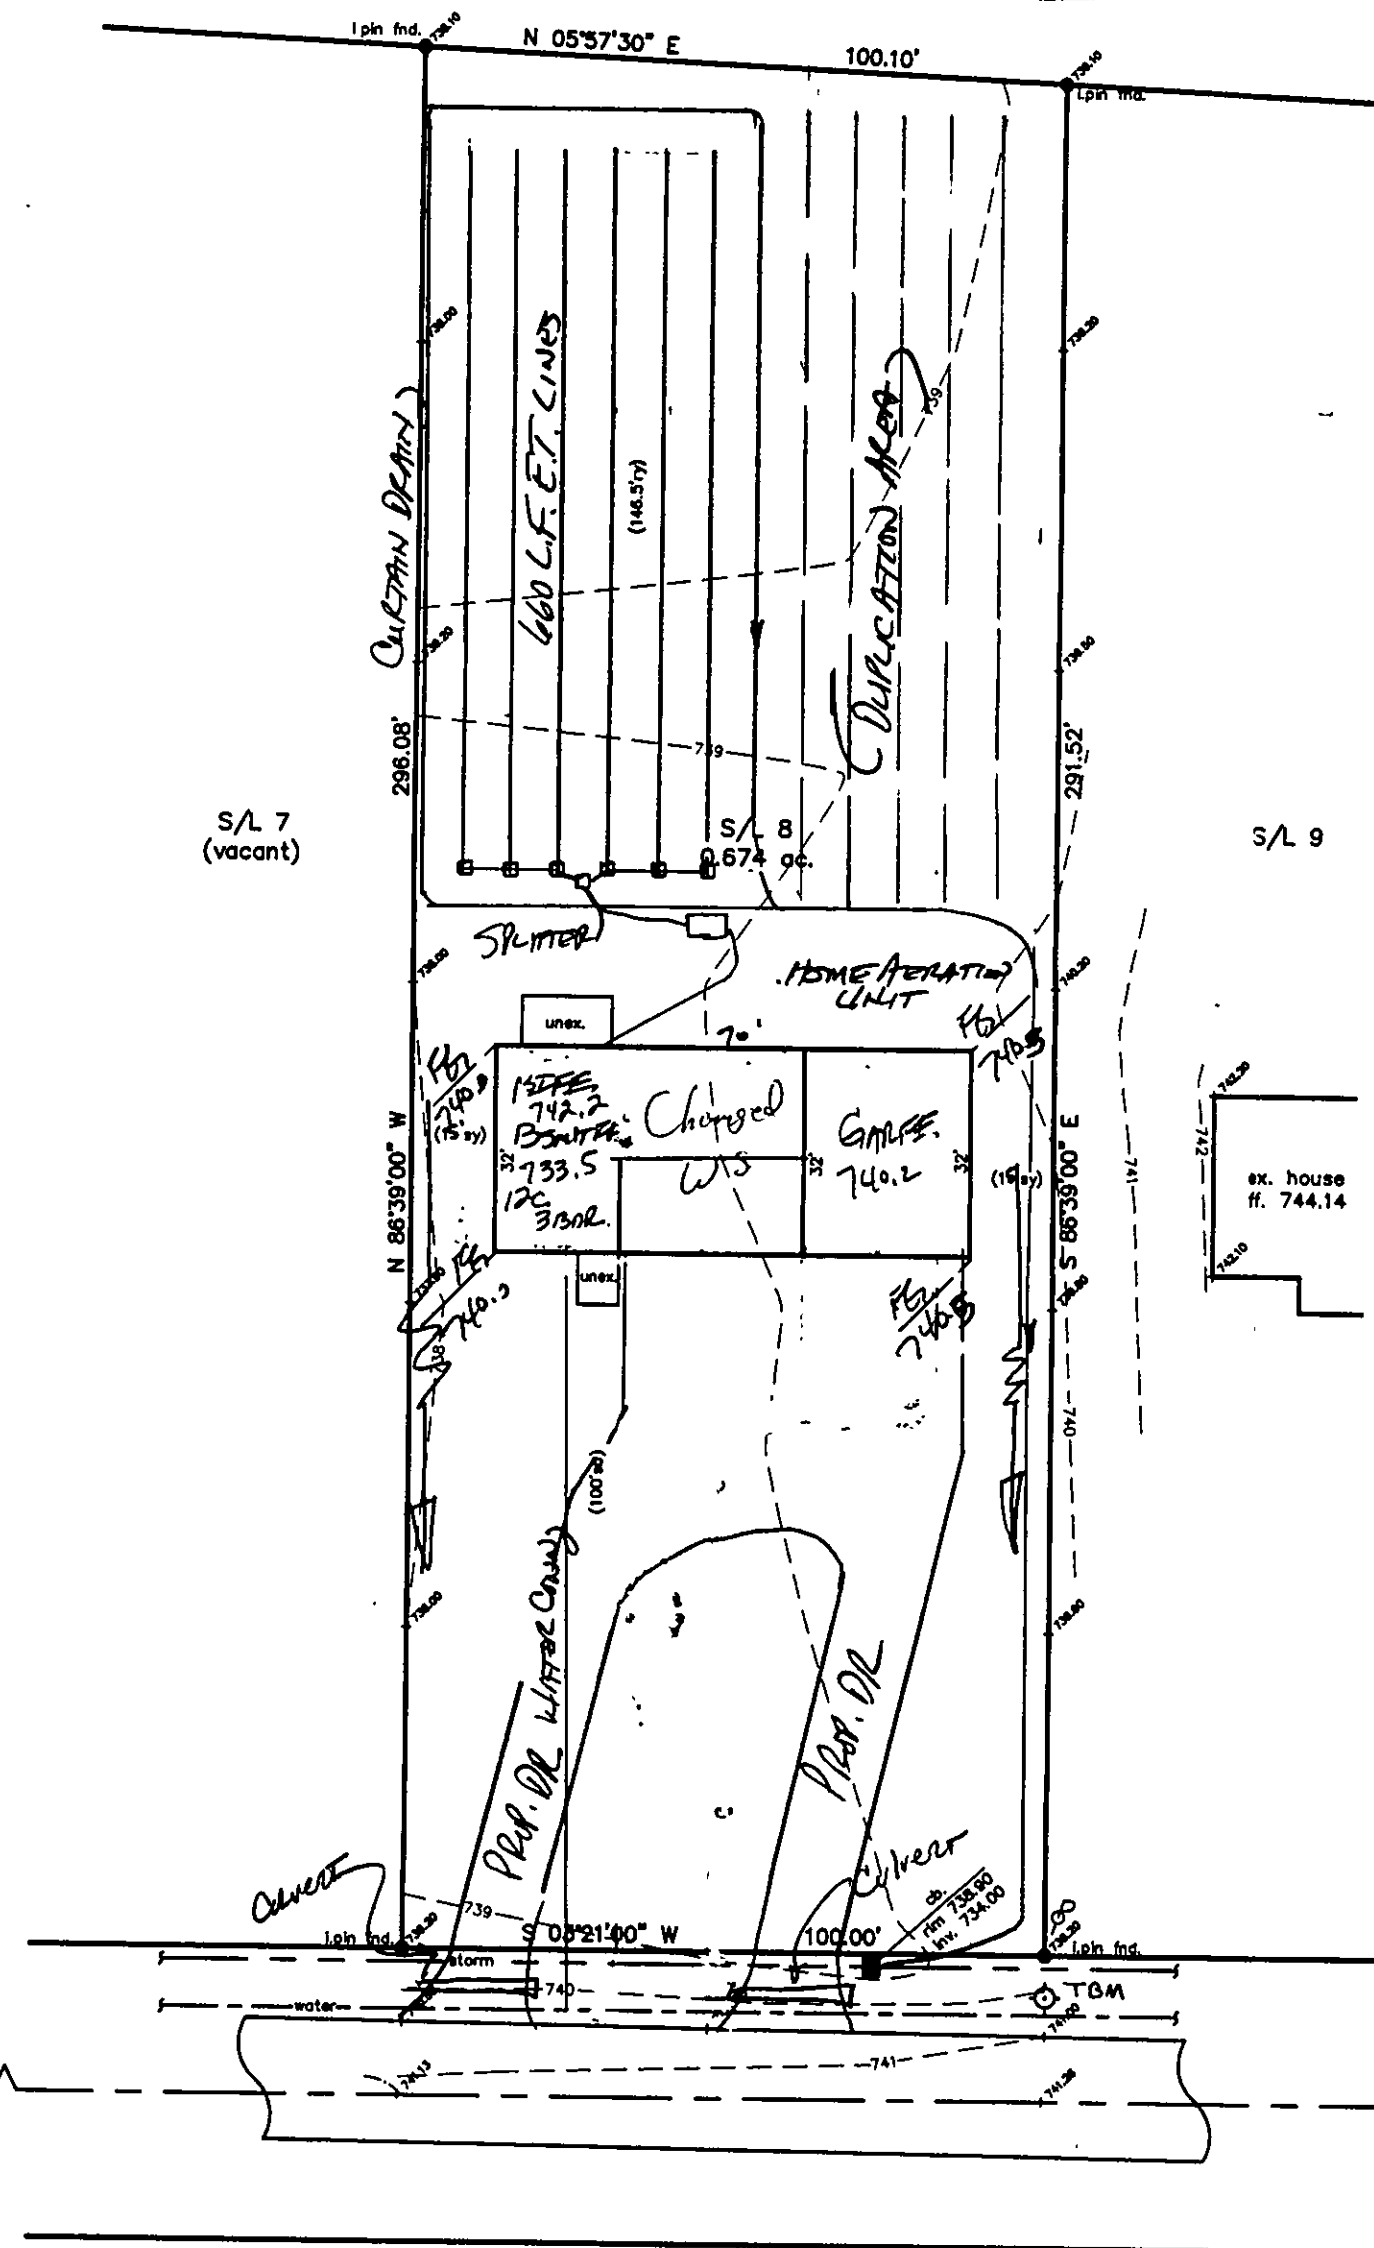


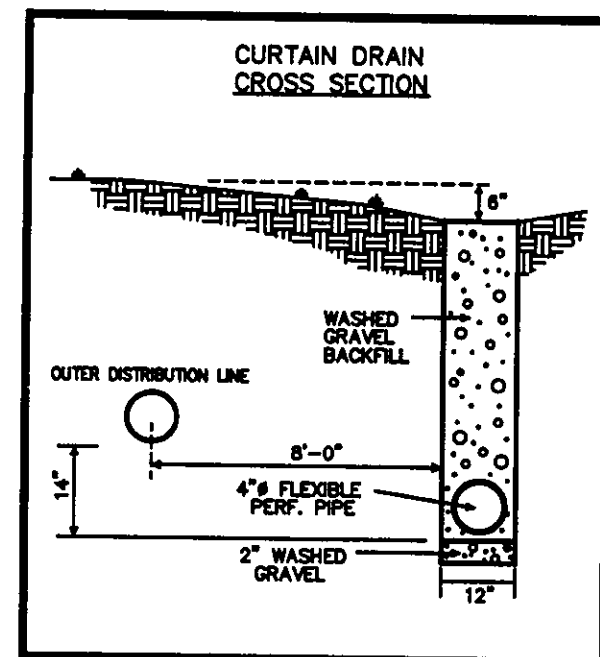

REVIEWED AND ACCEPTED
LAKE COUNTY GENERAL
HEALTH DISTRICT

3-4-99
Date BY
Daryl B. Norris

SEWAGE DISPOSAL PERMIT MUST BE
OBTAINED BY A LAKE COUNTY LICENSED
INSTALLER BEFORE INSTALLATION IS
STARTED

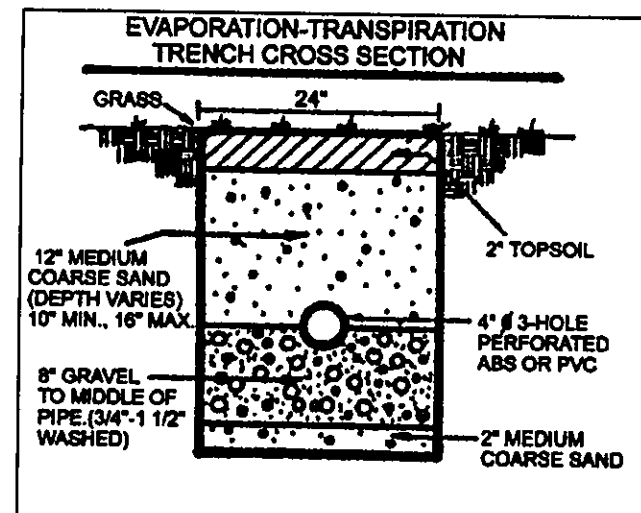

HYDRAULIC PROFILE
100.00' ± 30' ± 100.00' ± 5'

APPROVED
SIDE LINES & SET BACK
PERRY TOWNSHIP ZONING
PERMIT NO. 6800
ZONING INSPECTOR

SITE PLAN

PERRY TOWNSHIP, LAKE COUNTY, OHIO
for: WILLIAM HINE 428-8757
CLIENT OWNER
ADDRESS STREET CITY ZIP

COLONY ALLOTMENT
SUBDIVISION K-80 NAME TRACT
8 VOL-PC ELBERTA RD. LOT STREET
SUBLOT NO. STREET VOL-PC PERM. PARCEL NO.

LEGEND

SANITARY MANHOLE --- 1
STORM MANHOLE --- 2
INLET OR CATCH BASIN --- 3
HYDRANT --- 4
EXISTING CONTOURS --- 5
PROPOSED CONTOURS --- 6
EXIST. ELEV. --- 100.0
100.0 ± 2 --- PROP. ELEV.
AS BUILT ELEVATION
INDICATES
DIRECTION OF
SURFACE DRAINAGE

REMARKS

ALL BOUNDARY DATA SHOWN WAS OBTAINED FROM (DEEDS, RECORDED
SUBDIVISION PLAT OR OTHER PUBLIC RECORDS)
LOCATIONS AS SHOWN OF ADJACENT WELLS AND SEPTIC TANKS OBTAINED FROM
LAKE COUNTY HEALTH DEPARTMENT

DESIGN CERTIFICATION

THIS PLAT WAS PREPARED BY ME, AND IS CORRECT
TO THE BEST OF MY KNOWLEDGE AND BELIEF.

NAME SURVEYOR REGISTRATION NO.

CHECK LIST

NO. OF BEDROOMS
DIMENSIONS
BEARINGS
TIE TO NEAREST STREET
SUBLOT NO. PARCEL NO.
SURROUNDING OWNERS
BLDG. DIMENSIONS FIN GR.
BLDG. TIES FL.R. GRADES
APRON TYPE WIDTH THICKNESS
SIDEWALK TYPE WIDTH THICKNESS
CULVERT TYPE DIA. LENGTH
ROCK OUTCROPPINGS
WATER MAIN SIZE, LOCATION
SAN. SEWER SIZE & GR. LOC.
SAN. MH. CAST. ELEV. INV. ELEV.
SAN. CONN. SIZE, LOC. DEPTH
STORM SEWER SIZE & GR. LOC.
STORM MH. CAST. ELEV. INV. ELEV.
PAV'T TYPE GRADE CURVES
GAS LINE LOC. SIZE PRESSURE
SEPTIC TANK LOCATION & DUPLICATION AREA
WELL LOCATION
ISOLATION RADIUS FROM WELL

REVISIONS


NO.	DATE	BY	PLAN PREPARED BY:
1	3/2/99	HJ	BABCOCK · JONES & ASSOCIATES, INC.
2			PAINESVILLE, OHIO
3			DRAWN BY T.R. SCALE 1"=30' PHONE NO. 440-357-1811
4			CHK'D. H.J. DATE 2/11/99 DRAWING NO.
5			CREW K.J. APP'D H.J. 93-016-08

"AS BUILT" CERTIFICATION
I, HEREBY CERTIFY THAT THE CIRCLED GRADES ARE EXISTING
FINISH GRADES CHECKED IN THE FIELD ON 19
AND ARE CORRECT TO THE BEST OF MY KNOWLEDGE AND BELIEF.

REGISTERED SURVEYOR

REG. NO.

TBM-TOP OF HYDRANT
ELEV.=743.01

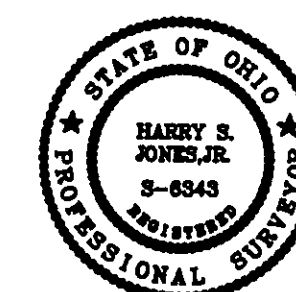

"I, the undersigned hereby certify that
this topography indicated by 6", 1", or 2"
contours, and elevations shown hereon
represent an actual field survey made by
me on the 10th day of Feb., 1999
and that the elevations were taken at
appropriate intervals and that as of that
date they existed as indicated hereon."

Name Date
Daryl B. Norris 4/22/99

Grading Plan Approved
as shown and/or noted
THOMAS P. GILLES, P.E.
Lake County Engineer

By T.R. Date 4/22/99
SEC. PLAN

ELBERTA ROAD - 45'