


FLORIDA ST 60'

FILE HYDRANT PENCH MARK
TOP OF HYD. EL. 696.63

8" WATER LINE

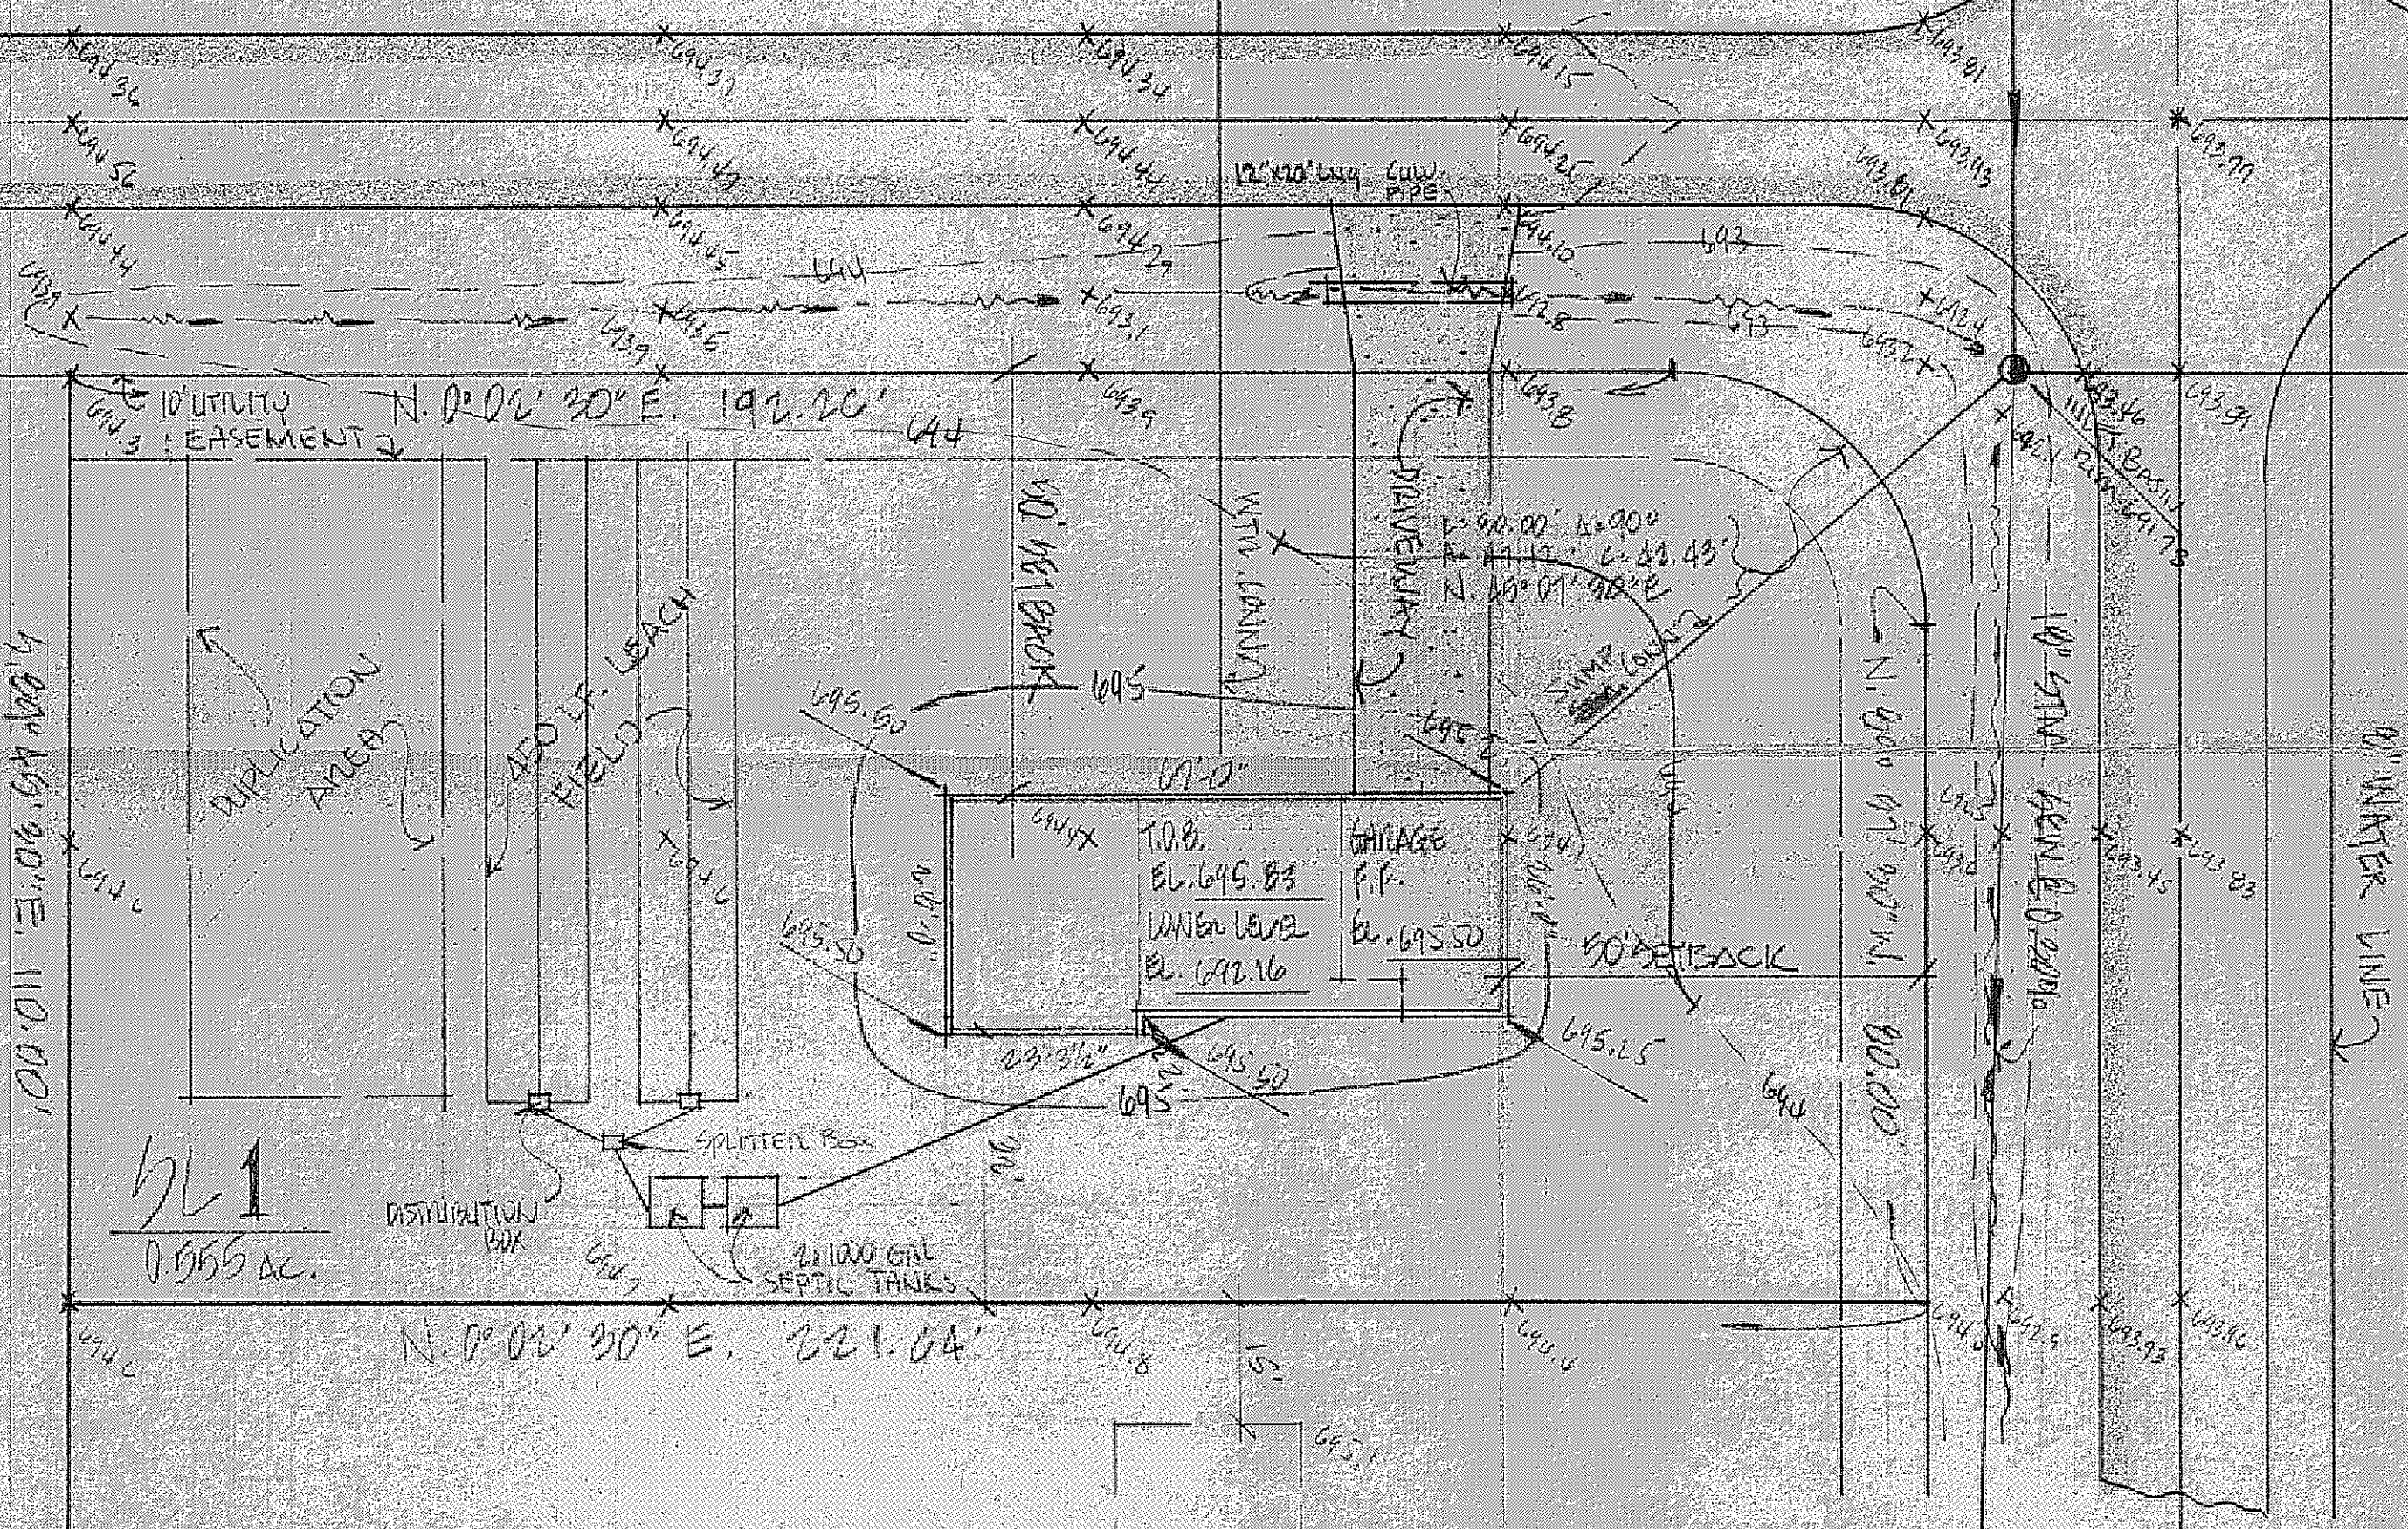

APPROVED
SIDE LINES & SET BACK
PERRY TOWNSHIP ZONING
PERMIT NO. 2363
ZONING INSPECTOR
R.W. Pitterhouse

Grading Plan Approved
as shown and/or noted
THOMAS P. GILLESPIE
Lake County Engineer
By *Thomas P. Gillespie* 4-9-80

UNDERLINED ELEVATIONS INDICATE PROPOSED GRADES

DESIGN CERTIFICATION
THIS PLAN WAS PREPARED BY ME
AND IS CORRECT TO THE BEST OF
MY KNOWLEDGE AND BELIEF.
Thomas P. Gillespie
REG. SURVEYOR NO. 14785

AS BUILT CERTIFICATION
I HEREBY CERTIFY THAT THE CIRCLES
ARE EXISTING FINISH GRADES CHECK
FIELD ON SURVEY IS CORRECT TO THE BEST
KNOWLEDGE AND BELIEF.
REG. SURVEYOR NO.

SITE PLAN FOR: CASEMENT HOMES
1281 MADISON AVENUE PAINESVILLE OHIO.
BEING SUBLOT NO. 1 IN THE LAKE GROVE ESTATES SUBDIVISION IN
PERRY TOWNSHIP, OHIO

DATE 2/20/80
SCALE 1"=20'
DRAWN BY
CHKD BY
F.B. 31 PG.



COLPETZER WOODS
CONSULTANTS, INC.
MENTOR, OHIO 44060

SHEET
1
CONTRACT
80

SEPTIC
SYSTEM
PROFILE

EXIST'G GROUND
PROFILES

SCALE: HORIZ. 1"=20'
VERT. 1"=5'

