


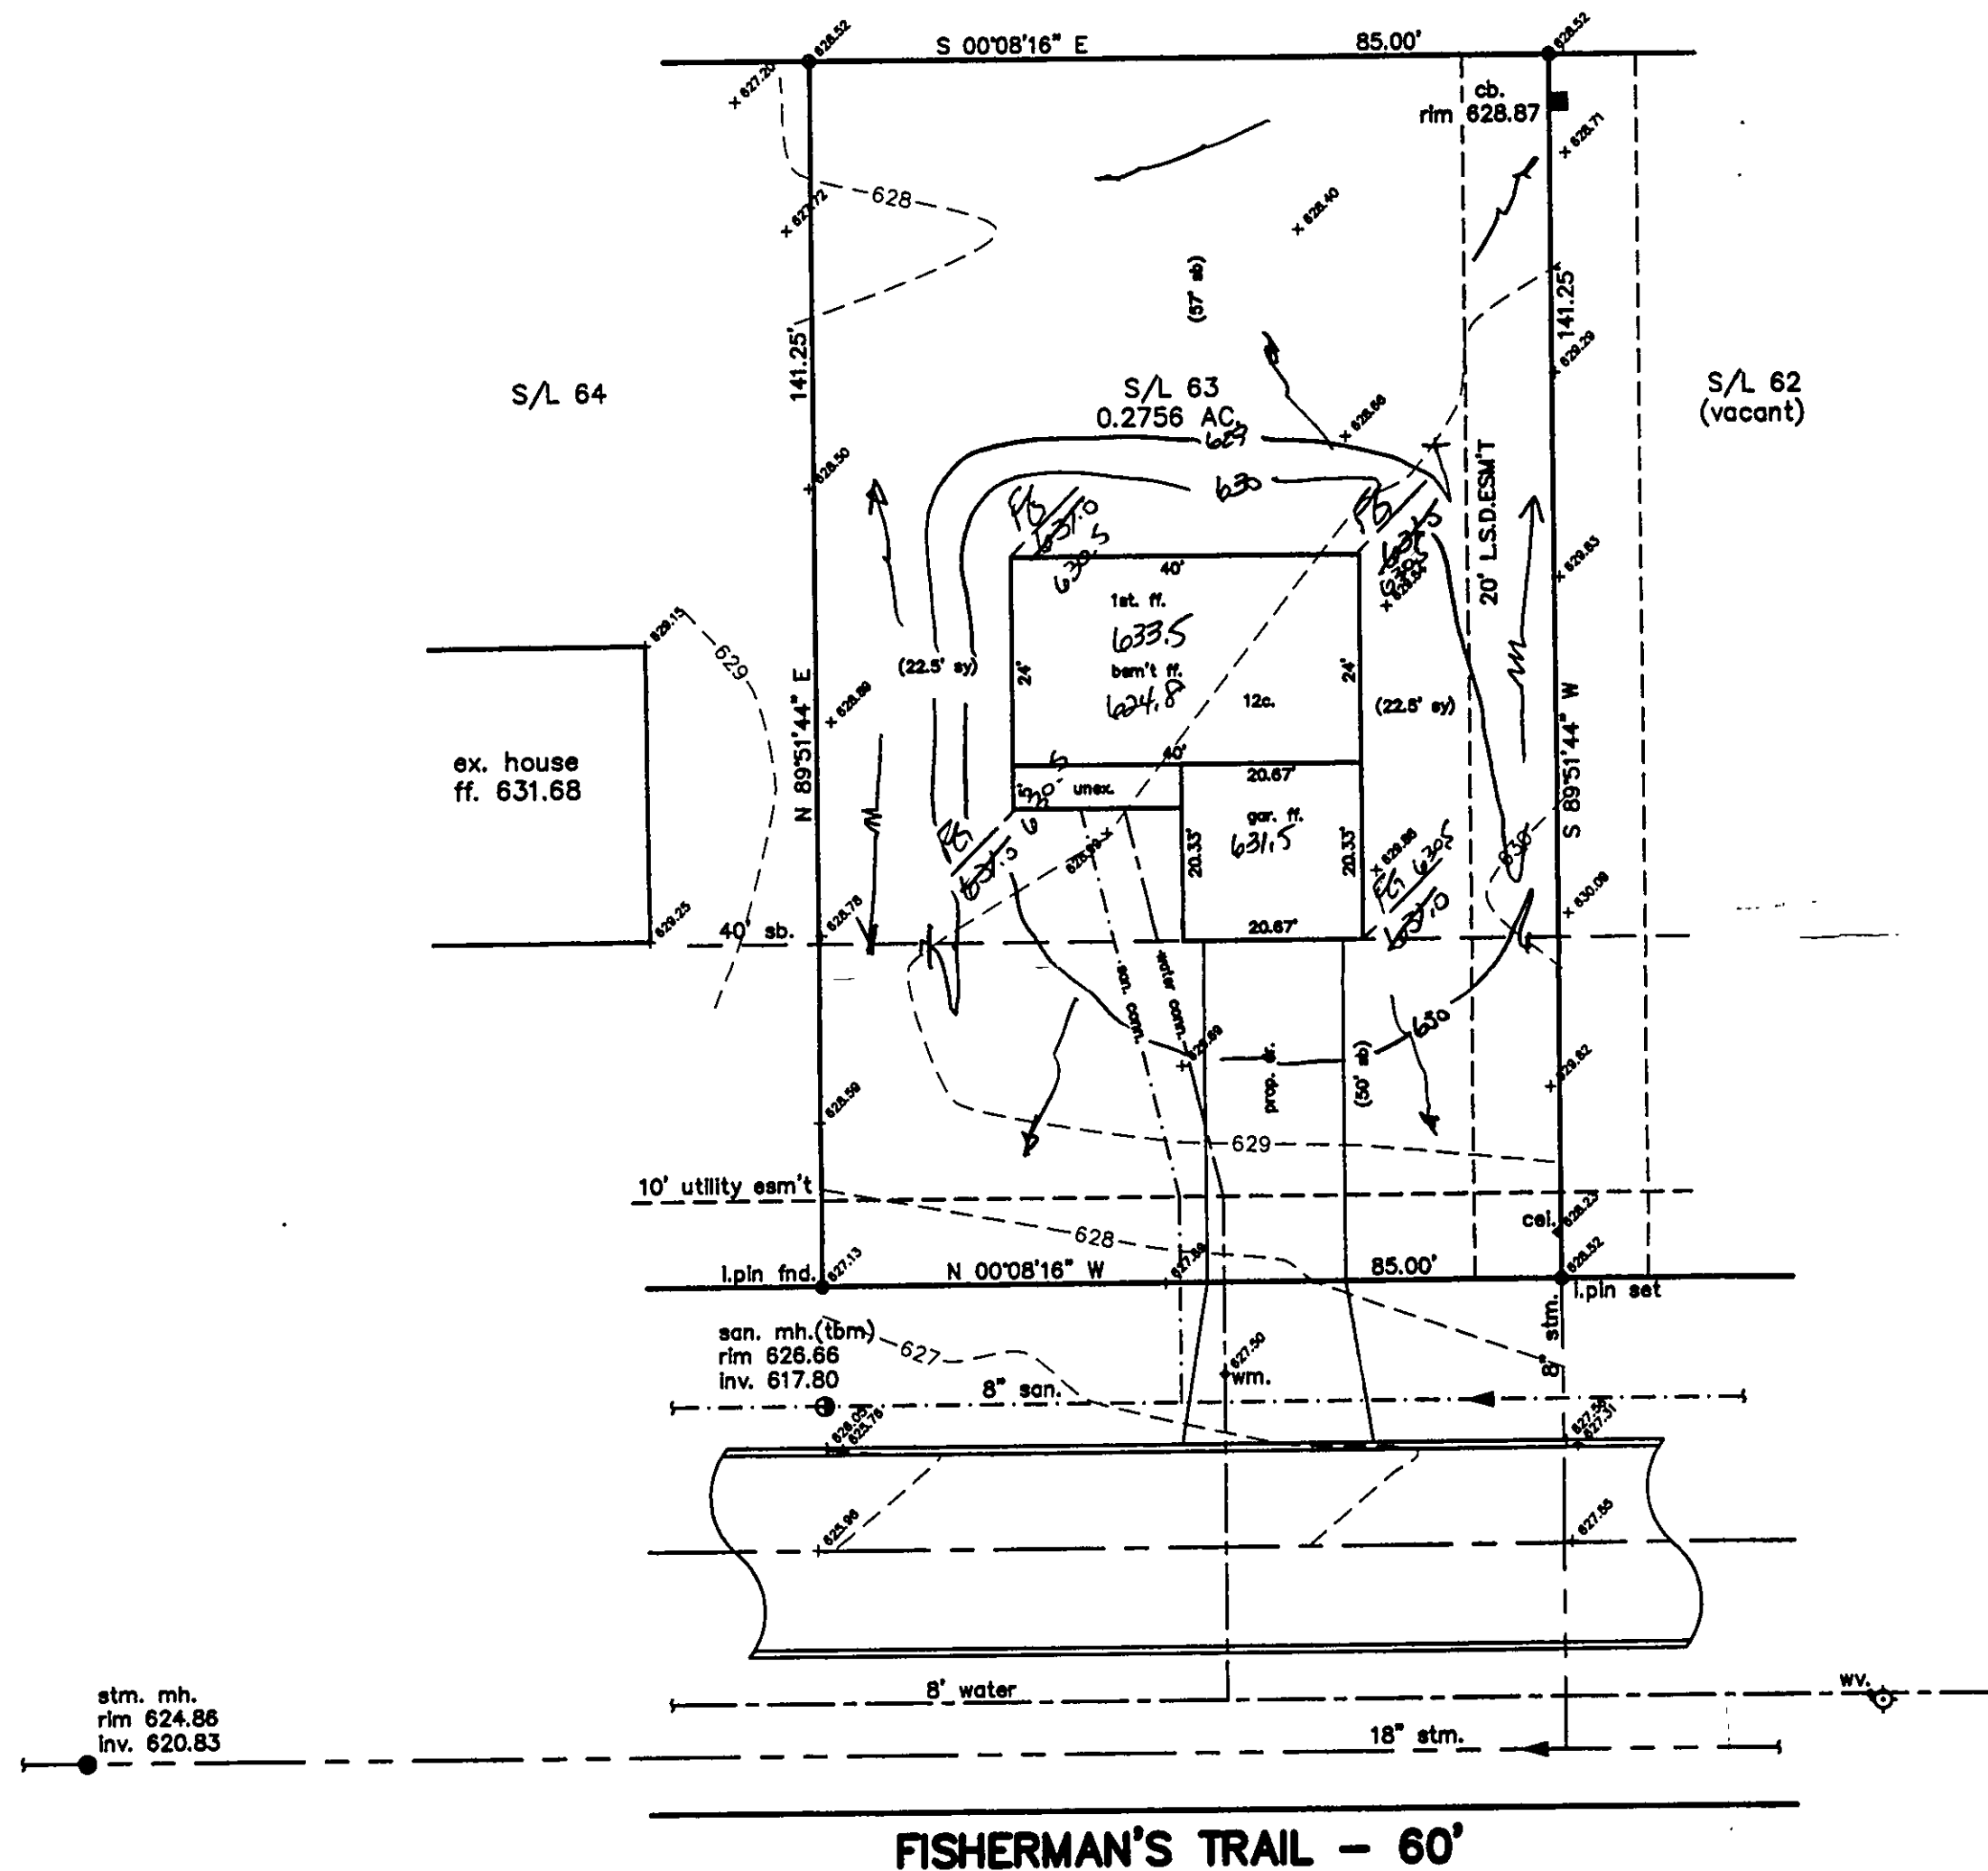

APPROVED
MADISON TOWNSHIP ZONING
DATE 10/3/99
BY DM 16445

SITE PLAN

MADISON TOWNSHIP, LAKE COUNTY, OHIO

for: NORTH COAST

CLIENT _____ OWNER _____

ADDRESS _____ STREET _____ CITY _____ ZIP _____

TITLE BAY

SUBDIVISION 33-15 NAME _____ TRACT _____ STREET _____

SUBLOT NO. 63 VOL-PG. FISHERMAN'S TR. LOT _____

SUBLOT NO. _____ STREET _____ VOL-PG. _____ PGM. PARCEL NO. _____

LEGEND

SANITARY MANHOLE --- --- EXIST. ELEV. --- 100.0 --- PROP. ELEV. --- 100.0

STORM MANHOLE --- --- AS BUILT ELEVATION

INLET OR CATCH BASIN --- --- INDICATES

HYDRANT --- --- DIRECTION OF

EXISTING CONTOURS --- --- SURFACE DRAINAGE

PROPOSED CONTOURS --- ---

REMARKS

ALL BOUNDARY DATA SHOWN WAS OBTAINED FROM (DEEDS, RECORDED SUBDIVISION PLAT OR OTHER PUBLIC RECORDS)

LOCATIONS AS SHOWN OF ADJACENT WELLS AND SEPTIC TANKS OBTAINED FROM LAKE COUNTY HEALTH DEPARTMENT

DESIGN CERTIFICATION

THIS PLAN WAS PREPARED BY ME, AND IS CORRECT TO THE BEST OF MY KNOWLEDGE AND BELIEF.

NAME Harry E. Jones, Jr. SURVEYOR REGISTRATION NO. 8-6843

CHECK LIST

NO. OF BEDROOMS _____

DIMENSIONS _____

BEARINGS _____

TIE TO NEAREST STREET _____

SUBLOT NO. PARCEL NO. _____

SURROUNDING OWNERS _____

BLDG. DIMENSIONS FIN GR. _____

BLDG. TIES FLTR. GRADES _____

APRON TYPE WIDTH THICKNESS _____

SIDWALK TYPE WIDTH THICKNESS _____

CULVERT TYPE DIA. LENGTH _____

ROCK OUTCROPPINGS _____

WATER MAIN SIZE, LOCATION _____

SAN. SEWER SIZE & OR. LOC. _____

SAN. MH. CAST. ELEV. INV. ELEV. _____

SAN. CONN. SIZE, LOC. DEPTH _____

STORM SEWER SIZE & OR. LOC. _____

STORM MH. CAST. ELEV. INV. ELEV. _____

PAV'T TYPE GRADE CURBS _____

GAS LINE LOC. SIZE PRESSURE _____

SEPTIC TANK LOCATION & DUPLICATION AREA _____

WELL LOCATION _____

ISOLATION RADIUS FROM WELL _____

REVISIONS

NO.	DATE	BY
1		
2		
3		
4		
5		

PLAN PREPARED BY: **BABCOCK · JONES & ASSOCIATES, INC.**

PAINEVILLE, OHIO

DRAWN BY T.R. SCALE 1"=20' PHONE NO. 440-357-1811

CHK'D. H.J. DATE 9/24/99 DRAWING NO. 97-268-63

CREW CHIEF W.B. APP'D H.J.

"AS BUILT" CERTIFICATION

I, HEREBY CERTIFY THAT THE CIRCLED GRADES ARE EXISTING FINISH GRADES CHECKED IN THE FIELD ON 9/24/99, 1999 AND ARE CORRECT TO THE BEST OF MY KNOWLEDGE AND BELIEF.

REGISTERED SURVEYOR _____ REG. NO. _____

TBM-SANITARY MH. RIM=626.66

Grading Plan Approved
as shown and/or noted
THOMAS P. GILLES, P.E.
Lake County Engineer

By Tam Date 10/6/99
Lower F4 to 630.5
Scale as shown

ROOF DRAINS
SHALL DISCHARGE
TO SPLASH BLOCKS.

