


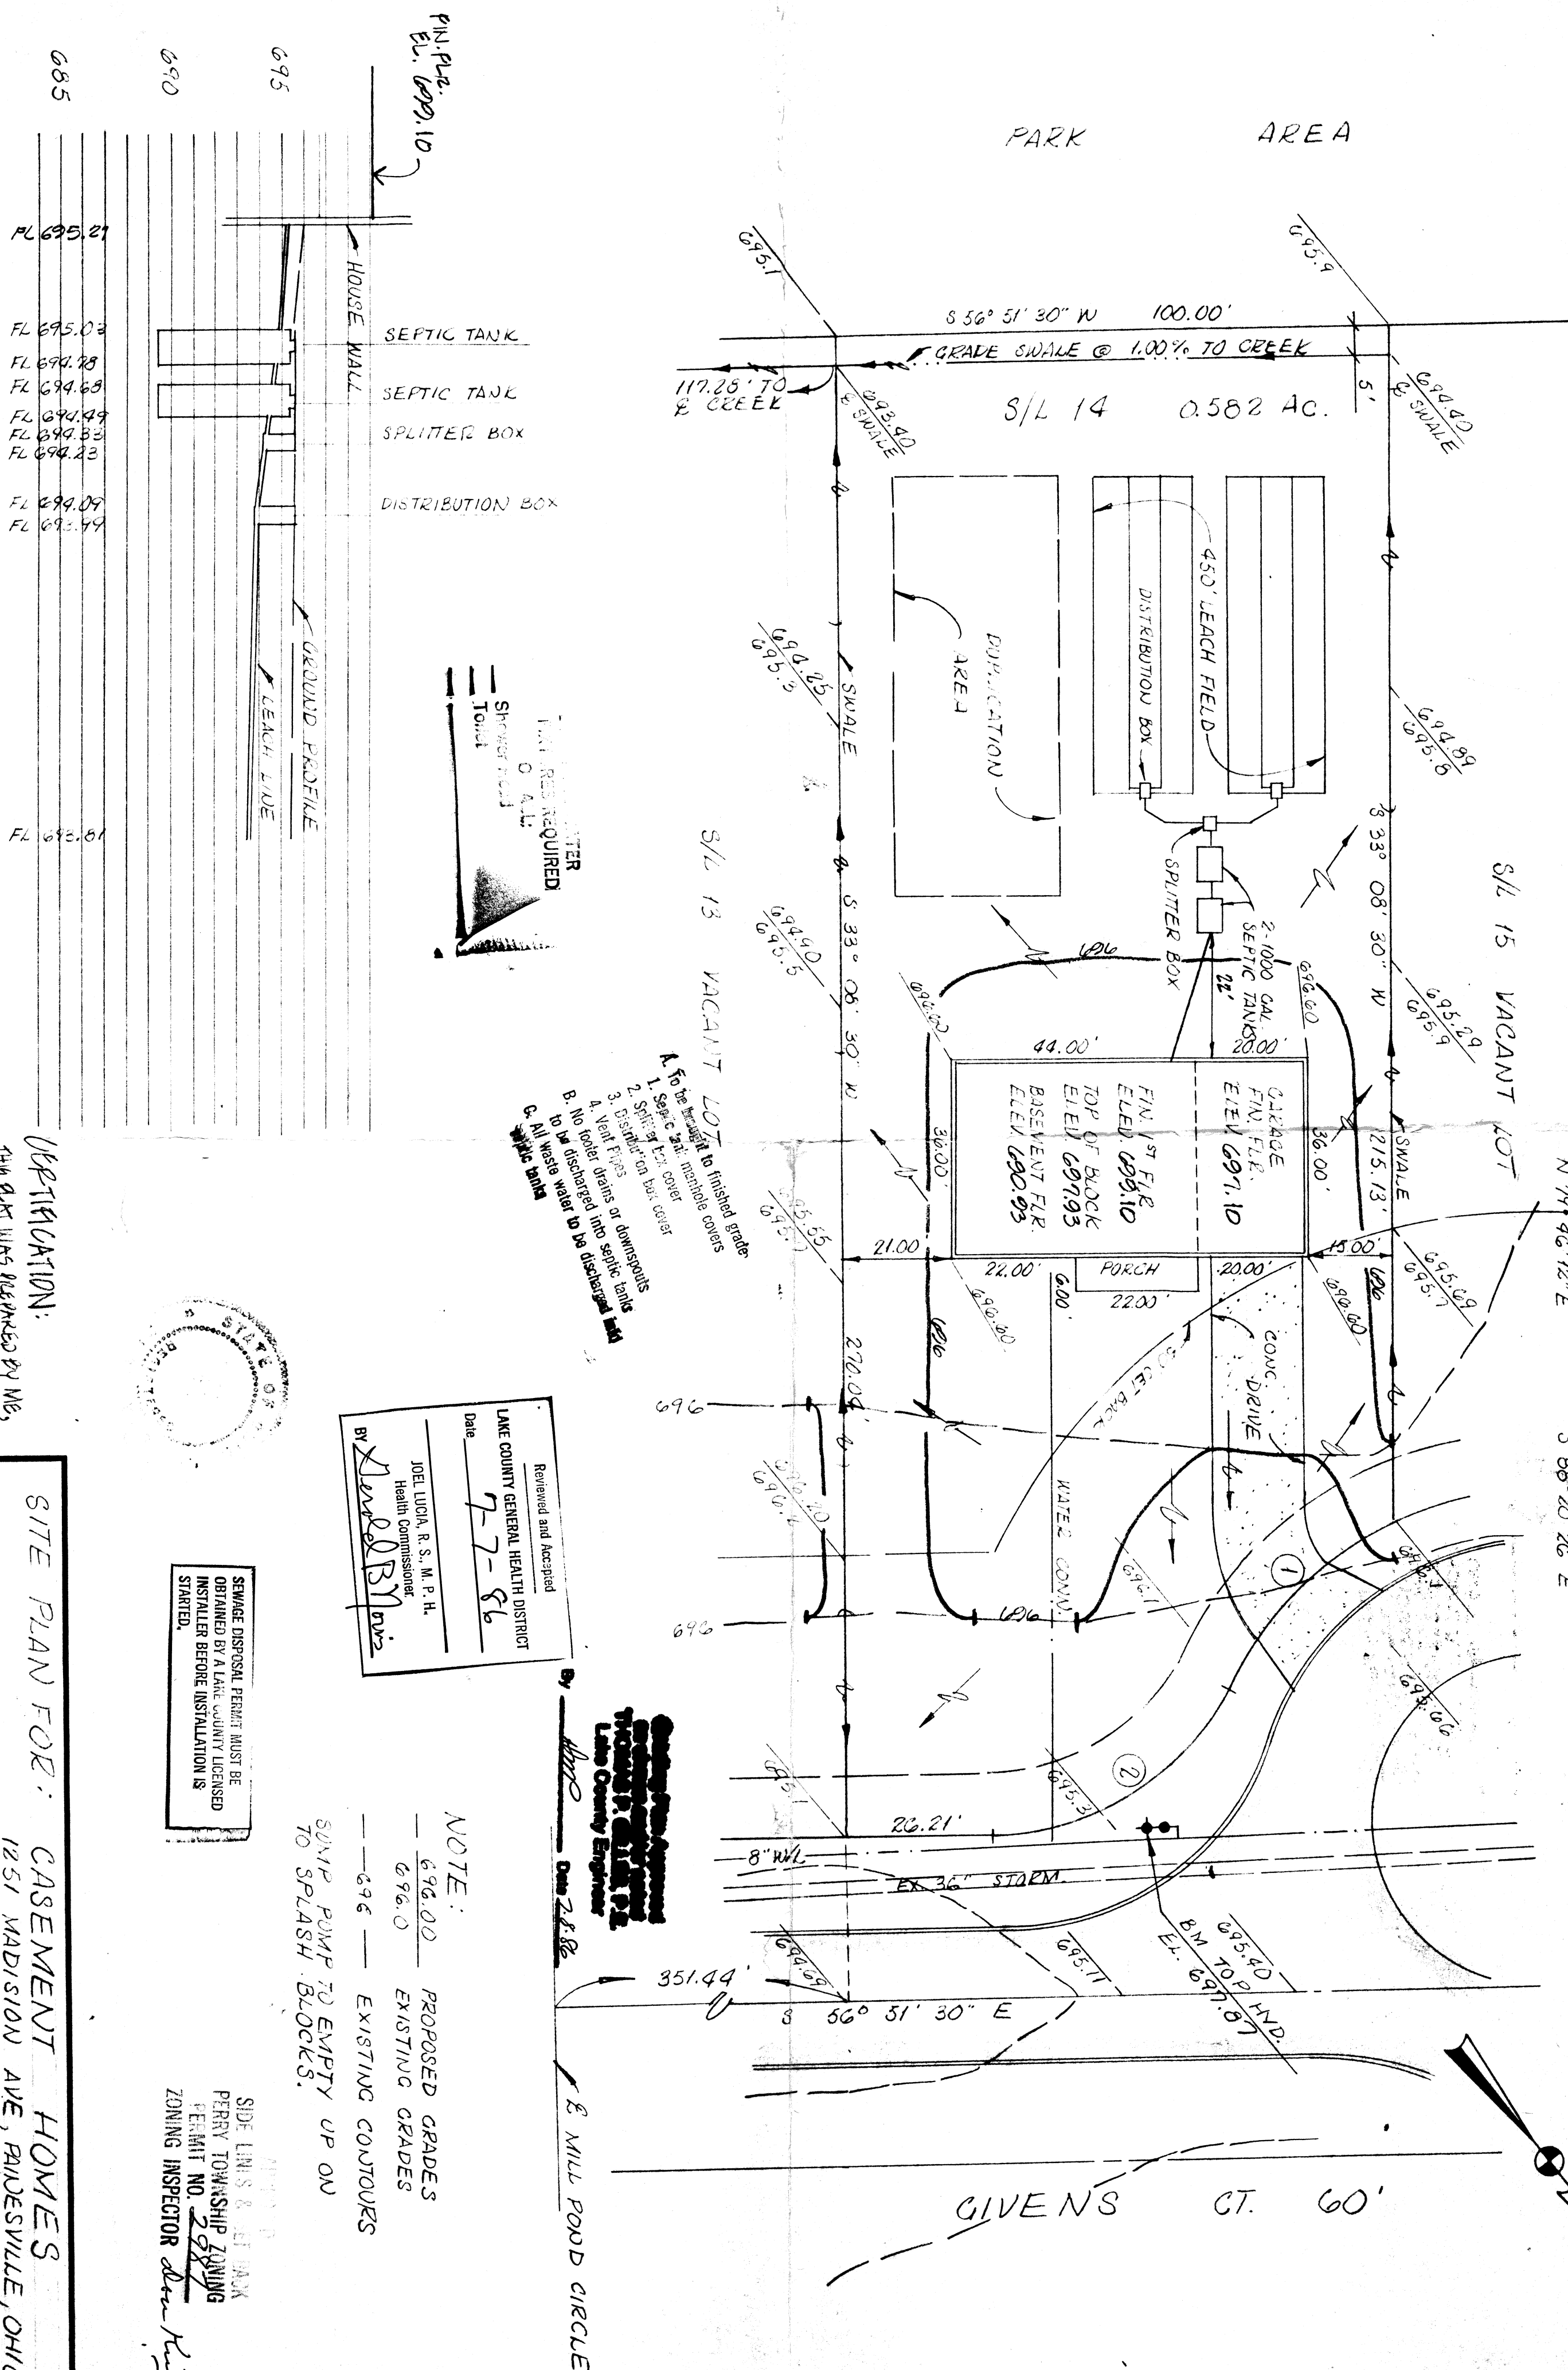

CURVE

①

K = 60.00'  
A = 41.03'  
Δ = 39° 01' 08"  
T = 71.36'  
C = 40.24'  
N 79° 46' 12" E

DATA

②

K = 50.00'  
A = 34.95'  
Δ = 62° 57' 52"  
T = 30.62'  
C = 58.28'  
S 86° 20' 26" E

1. Seepage cover
2. Seepage box cover
3. Vent pipes
4. No floor drains or downspouts to be discharged into septic tanks
5. All waste water to be discharged into septic tanks

Reviewed and Accepted \_\_\_\_\_  
 LAKE COUNTY GENERAL HEALTH DISTRICT  
 Date 7-7-86  
 \_\_\_\_\_  
 JOEL LUCIA, R. S., M. P., H.  
 Health Commissioner  
 BY David B. Jones

NOTE:

|                                               |        |
|-----------------------------------------------|--------|
| PROPOSED GRADES                               | 696.00 |
| EXISTING GRADES                               | 696.0  |
| EXISTING COUNTDRESS                           | 696    |
| SUMP PUMP TO EMPTY UP ON<br>TO SPLASH BLOCKS. |        |

SIDE LINES & SET BACK  
PERRY TOWNSHIP ZONING  
PERMIT NO. 2987  
ZONING INSPECTOR *den Haring*

FL 695.21  
FL 695.03  
FL 694.98  
FL 694.68  
FL 694.49  
FL 694.33  
FL 694.23  
FL 694.09  
FL 693.49

FL 693.81

VERIFICATION:

THIS PLAT WINS PURCHASED BY ME,  
AND IS DEPOSIT TO THE POST AT  
MY KNOWLEDGE AND DESIRE.

BY: Agnes

EXHIBED TO DIVISION, P. O. NO. 9244

SITE PLAN FOR: CASEMENT HOMES

1251 MADISON AVE, BRIDGESVILLE, OHIO  
BEING SUBLOT NO. 19, IN OAKBROOK VILLAGE SOBD., DEKEY TWP., OHIO

**COLPETZER-THOMAS, INC.**  
AN ENGINEERING GROUP

AN ENGINEERING GROUP

SHEET 1 OF 1

CONTRACT NO. 83-131-014