

B.M. SOUTH WEST
BOLT ON FIRE
HYDRANT
ELEV 100.00

HARPER STREET (49.5)

EDGE OF PVT.

R/W

N-77-24-10-E
100.00'

CITY WATER CONNECTION

60'

50' BLDG. LINE

SITEPLAN

FOR

TOM PARKER

HARPER STREET

PERRYVILLE, LAKE COUNTY

OHIO

I HEREBY CERTIFY THAT THE
TOPOGRAPHIC SURVEY SHOWN
HEREON, INDICATED BY 1' FOOT
CONTOURS, AND SPOT ELEVATION
ARE FROM AN ACTUAL SURVEY
DATED NOV. 16, 1992

GARAGE



F.F. 97.0
PROPOSED
1 STORY
3 BEDROOM
HOUSE

FOOTER
DRAIN

2-1000 GAL.
TANKS

8'x75' LEECH FIELD

DUPLICATION
AREA

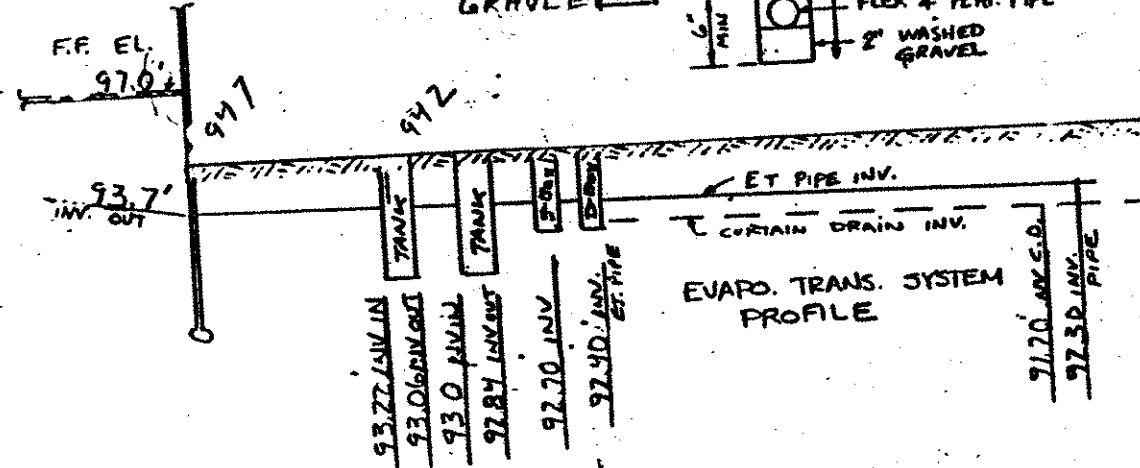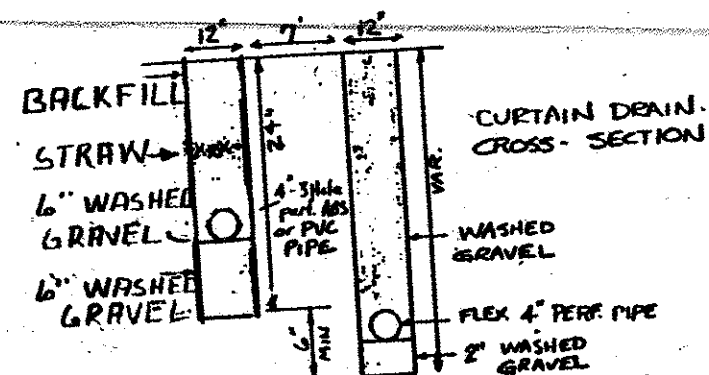

- A. To be brought to finished grade
1. Septic tank manhole covers
 2. Splitter box cover
 3. Distribution box cover
- B. No footer drains or downspouts to be discharged into septic tanks
- C. All waste water to be discharged into septic tanks

Reviewed and Accepted
LAKE COUNTY GENERAL HEALTH DISTRICT
Date 12/9/92
JOEL LUCIA, R. S., M. P. H. Health Commissioner
By Nancy Nielsen

REGISTERED SURVEYOR No 7431



LOW YIELD WATER
FIXTURES REQUIRED
ON ALL:
— Shower Head
— Toilet

SEWAGE DISPOSAL PERMIT MUST BE
OBTAINED BY A LAKE COUNTY LICENSED
INSTALLER BEFORE INSTALLATION IS
STARTED.

NOTE: DITCH TO BE CLEANED WITH A FINISH SLOPE

Grading Plan Approved
as shown and/or noted
THOMAS P. GROMLEY, P.E.
Lake County, Ohio

By GJH 12/6/92