

Grading Plan Approved
as shown and/or noted
THOMAS P. GILLES, P.E.
Lake County Engineer

By TRM Date 4/2/99
SCALE: 1"=20'

SITE PLAN FOR GLENN GNAGY

BEING KNOWN AS SUBLOTS No. 71 & 72 IN THE
MADISON LAKELANDS SUBDIVISION, IN
MADISON TOWNSHIP, LAKE COUNTY, OHIO.


1440 Hubbard Rd

NOTE: BEARINGS PER RECORD DEED
& MONUMENTATION FOUND


APPROVED
MADISON TOWNSHIP ZONING

DATE 3/31/99

BY 16115

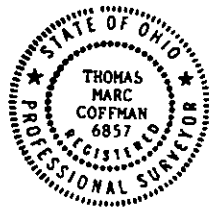


VILLAGE SURVEYING CO.
P.O. BOX 1096, FAIRPORT HARBOR, OH 44077
(440) 357-1359

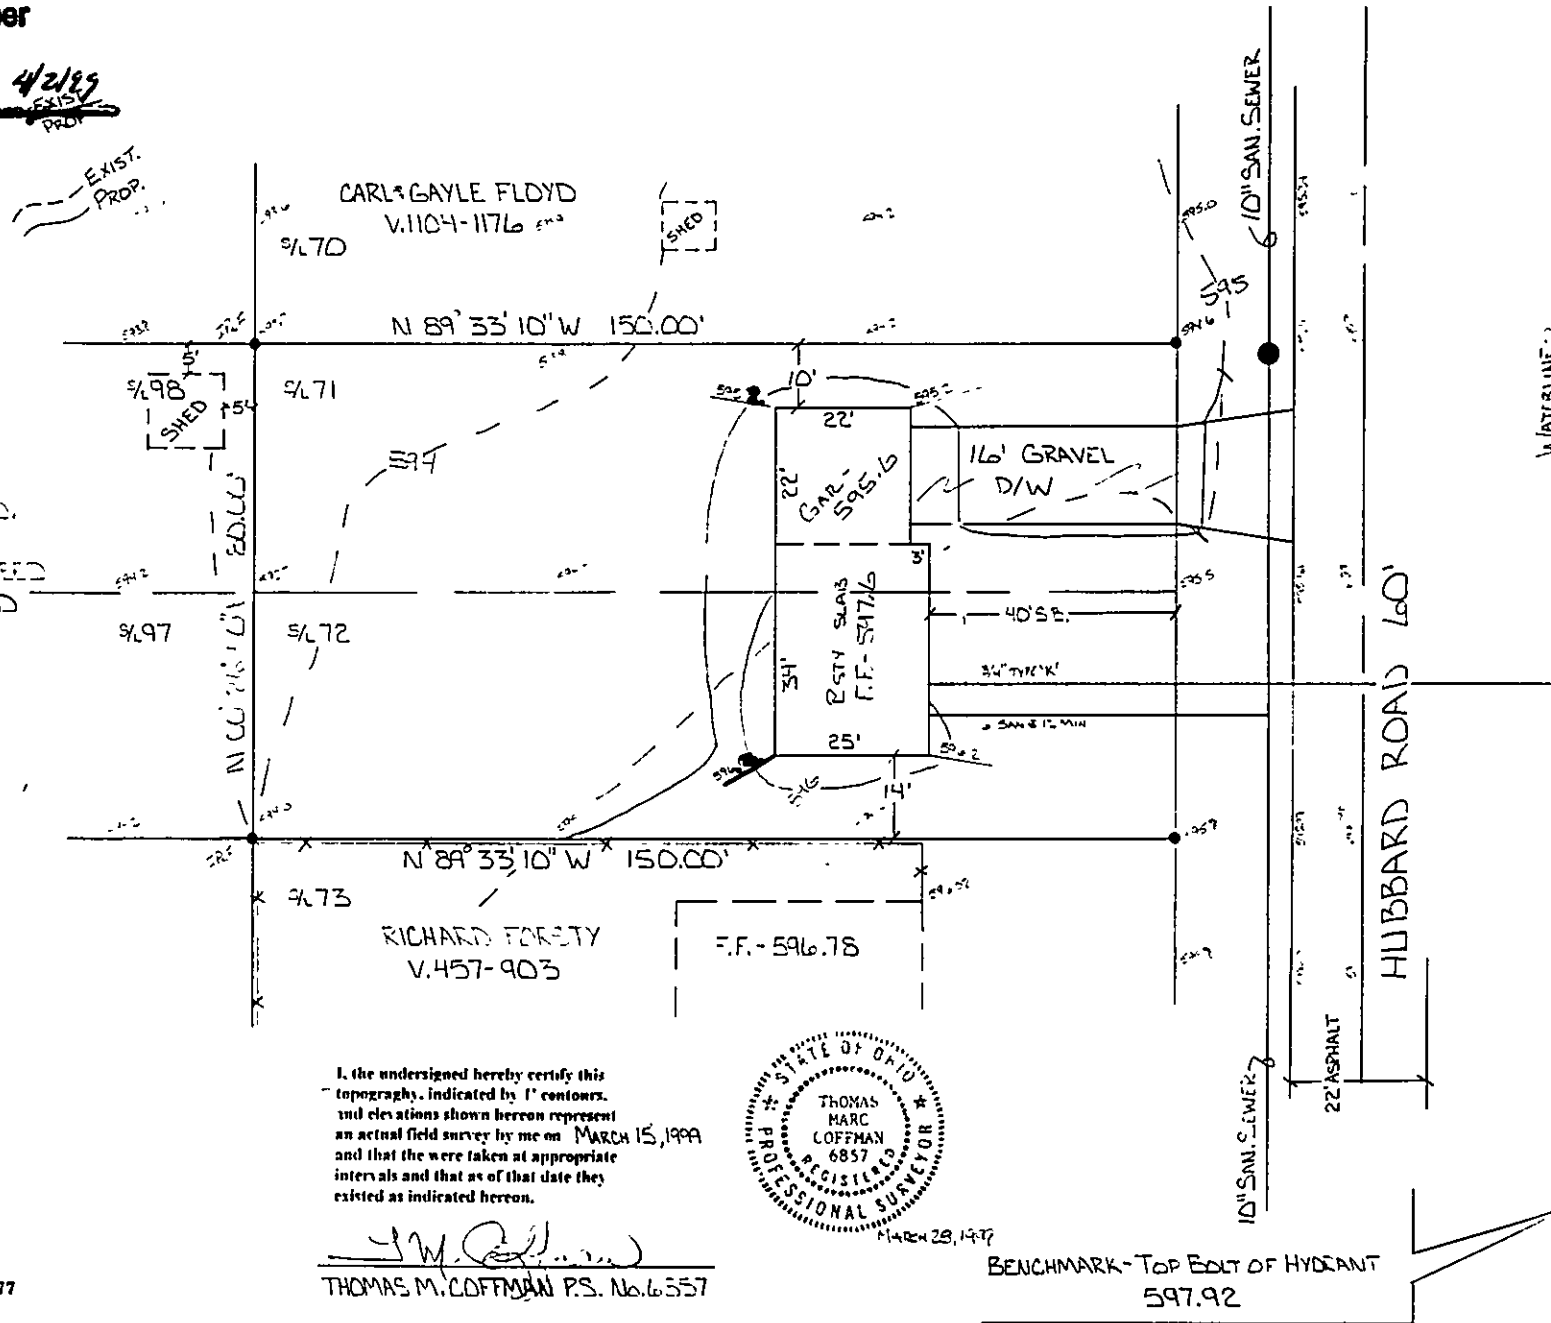

I, the undersigned hereby certify this
topography, indicated by 1' contours,
and elevations shown hereon represent
an actual field survey by me on MARCH 15, 1999
and that the were taken at appropriate
intervals and that as of that date they
existed as indicated hereon.

THOMAS M. COFFMAN
THOMAS M. COFFMAN P.S. No. 6357

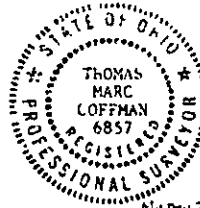

BENCHMARK - TOP BOLT OF HYDRANT
597.92