



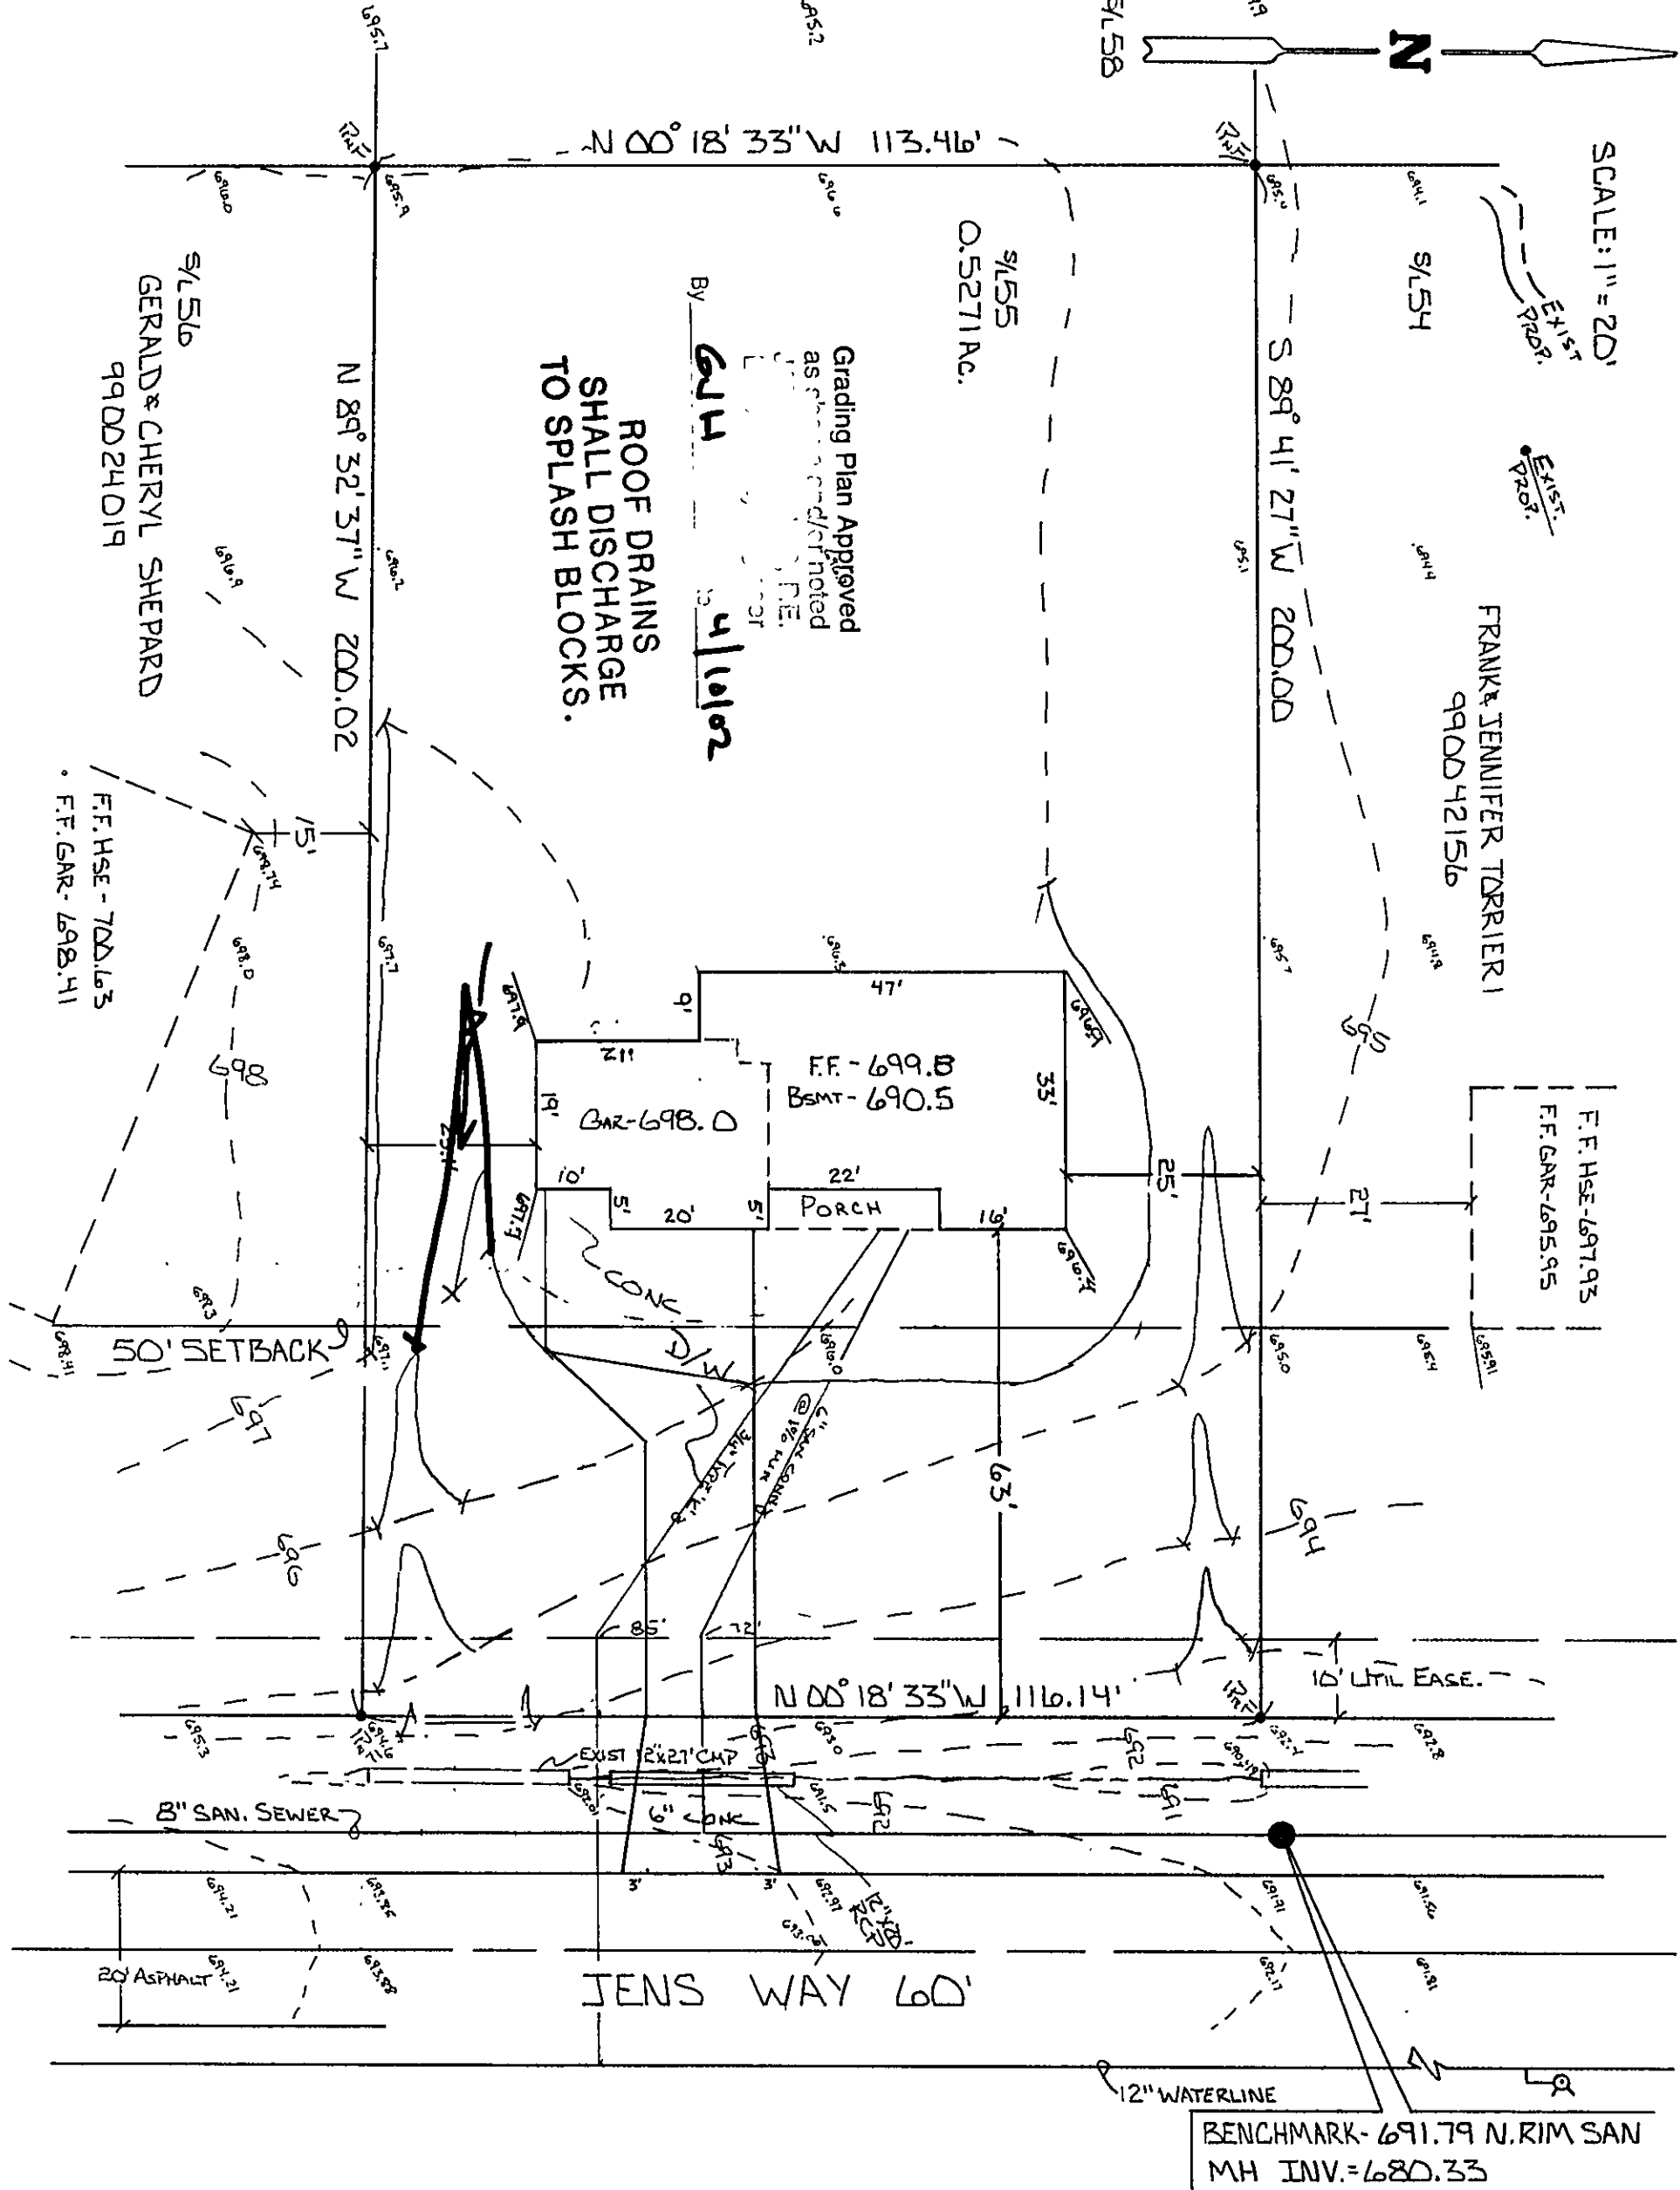

SITE PLAN
FOR
JAMES COWAN
BEING KNOWN AS S/L 55 IN RED MILL RUN SUBD.
No. 2, PHASE 1 IN PERRY TOWNSHIP, LAKE COUNTY,
OHIO.

I, the undersigned hereby certify this
topography, indicated by 1' contours,
and elevations shown hereon represent
an actual field survey by me on 8-3-01
and that the were taken at appropriate
intervals and that as of that date they
existed as indicated hereon.

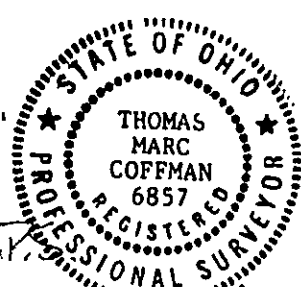

J.M. Coffman

Aug 14, 2001
REV 4-B-02