



SITE PLAN FOR MIKE PREZIOSA

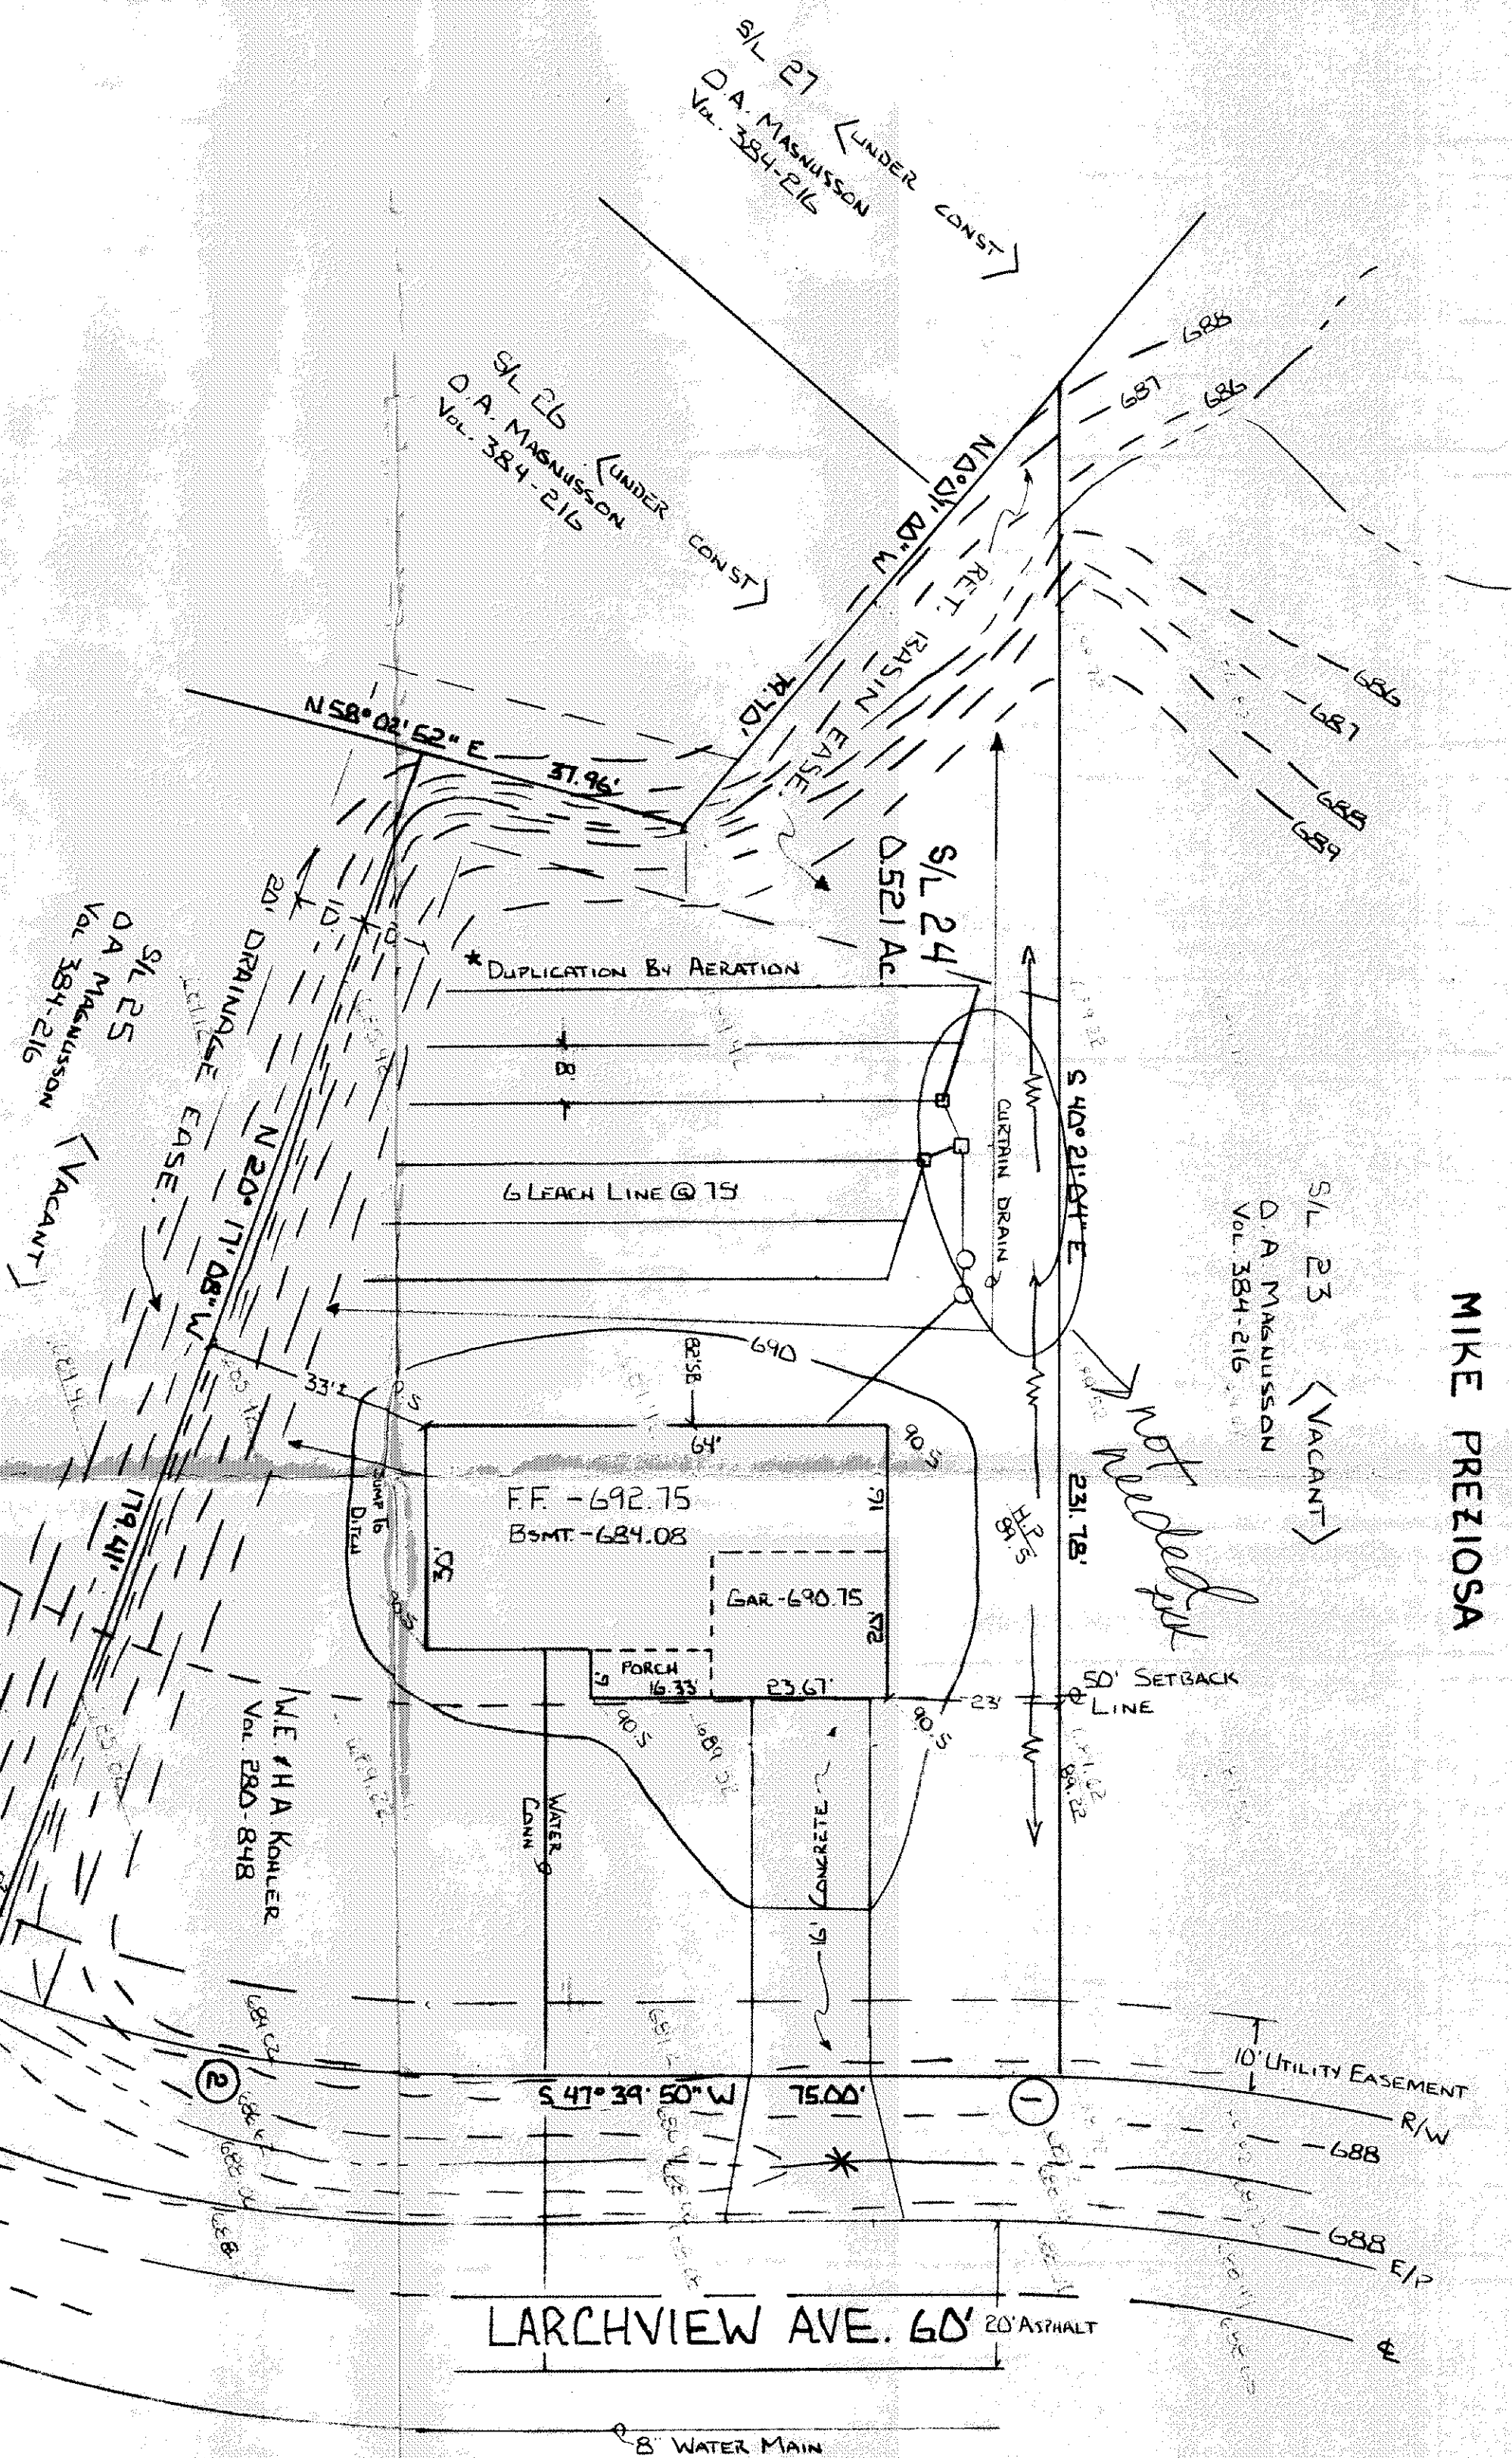

HYDRAULIC PROFILE

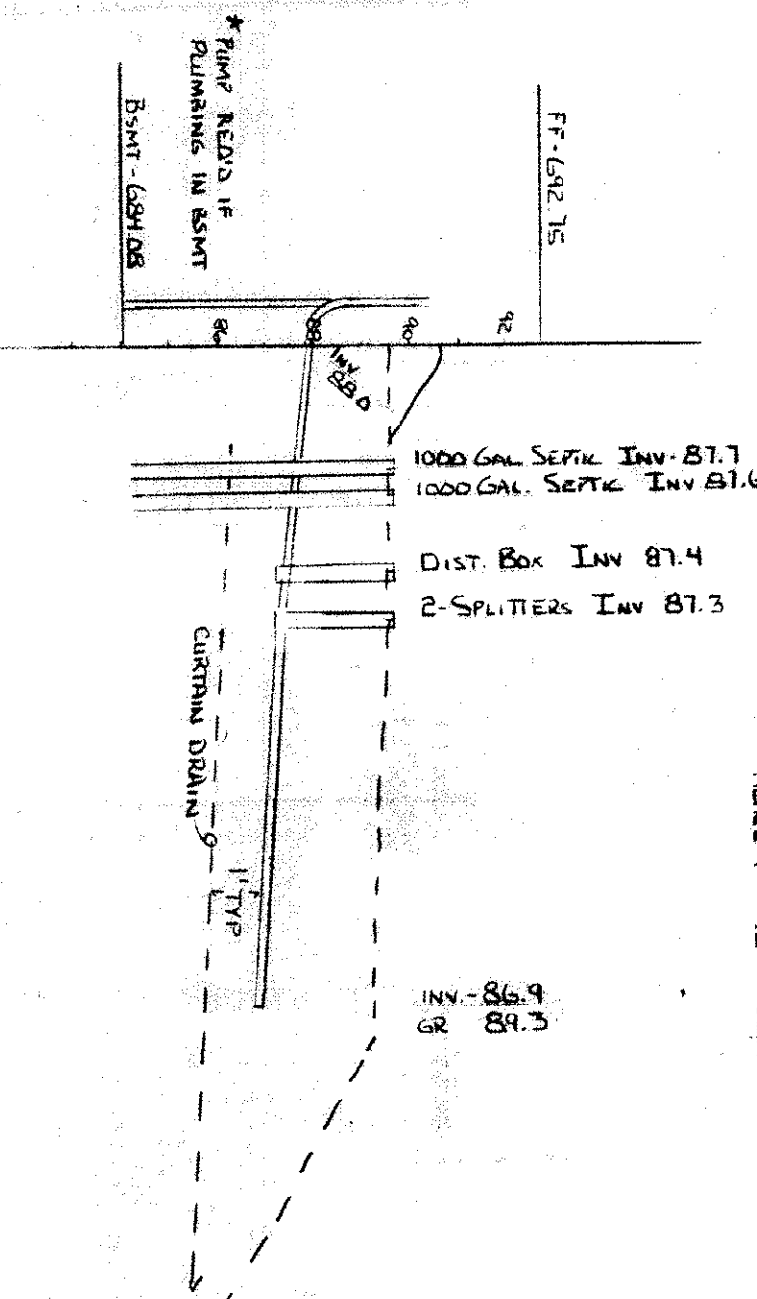

VILLAGE SURVEYING CO.
THOMAS M. COTTMAN, P.S.
202 THIRD STREET, FAIRPORT HARBOR, OHIO 44077
(416) 351-1359

JUN 1988

THIS PLAN WAS PREPARED BY ME AND IS TRUE AND ACCURATE TO THE BEST OF MY KNOWLEDGE AND BELIEF

Thomas M. Cottman
THOMAS M. COTTMAN, P.S.

BENCHMARK - 690.46
TOP BOLT HYDRANT S/L 18
SIDE LINES & SET BACK
PERRY TOWNSHIP ZONING
PERMIT NO. 4162
ZONING INSPECTOR: *John K...*

APPROVED

A. To be brought to finished grade
1. Septic tank manhole covers
2. Splitter box cover
3. Distribution box cover

B. No footer drains or down-sinks
to be discharged into septic tanks

C. All waste water to be discharged into
septic tanks

SEWAGE DISPOSAL PERMIT MUST BE
OBTAINED BY A LAWYER LICENSED
INSTALLER BEFORE INSTALLATION
STARTED.

THOMAS M. COTTMAN, P.S.
REGISTERED SURVEYOR

7.9' Reviewed and Accepted.
DATE 7-2-88
BY *Joel Lucia*
JOEL LUCIA, R.S., M.P.H.
Health Commissioner

LOW YIELD WATER
FIXTURES REQUIRED
ON ALL:
Shower Head
Toilet

Grading Plan Approved
as shown and/or noted
THOMAS P. GILLES, P.E.
Lake County Engineer

By *Thomas P. Gilles*
* checked 12 x 20 office
paper of measuring.