


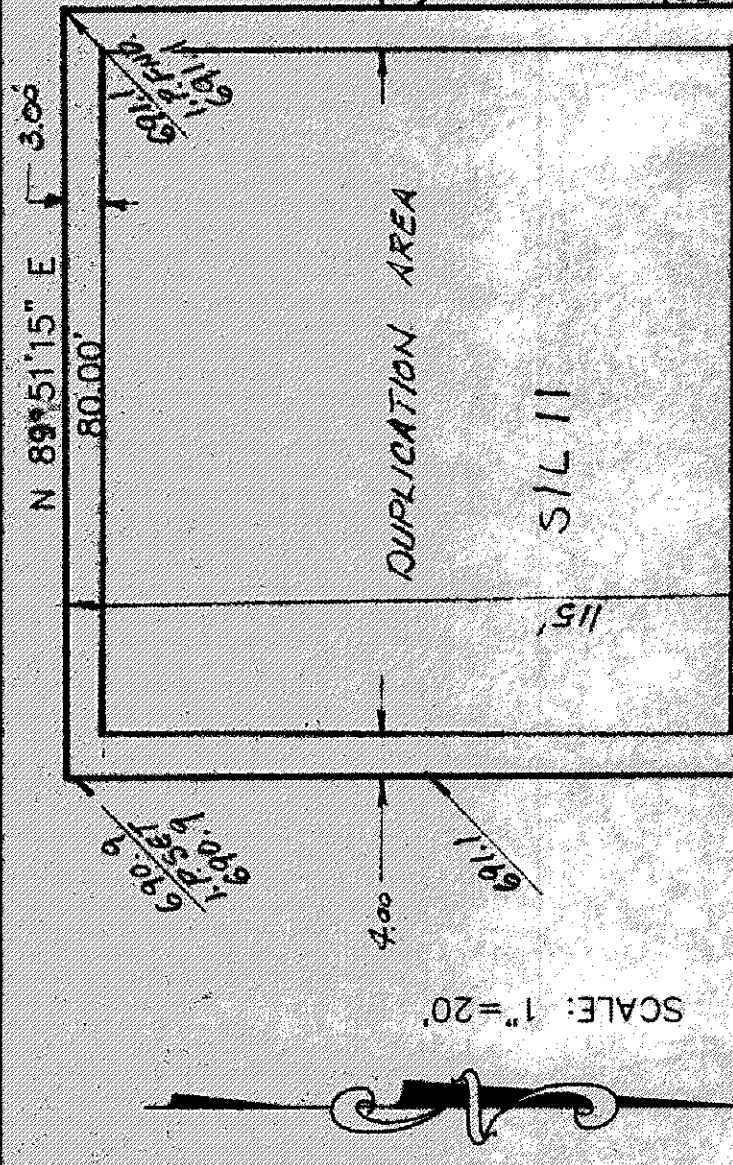

SEWAGE DISPOSAL PERMIT MUST BE OBTAINED BY A LAKE COUNTY LICENSED INSTALLER BEFORE INSTALLATION IS STARTED.


LOW YIELD WATER FIXTURES REQUIRED ON ALL:
Shower Head
Toilet

- A. To be brought to finished grade
1. Septic tank manhole covers
 2. Splitter box cover
 3. Distribution box cover
- B. No footer drains or downspouts to be discharged into septic tanks
- C. All waste water to be discharged into septic tanks


Reviewed and Accepted
LAKE COUNTY GENERAL HEALTH DISTRICT
Date May 13, 1993
JOEL LUCHA, R.S.M.P.H.
Health Commissioner
By Nancy Mahan

HYDRAULIC PROFILE


SCALE: HOR 1"=20' VERT 1"=5'

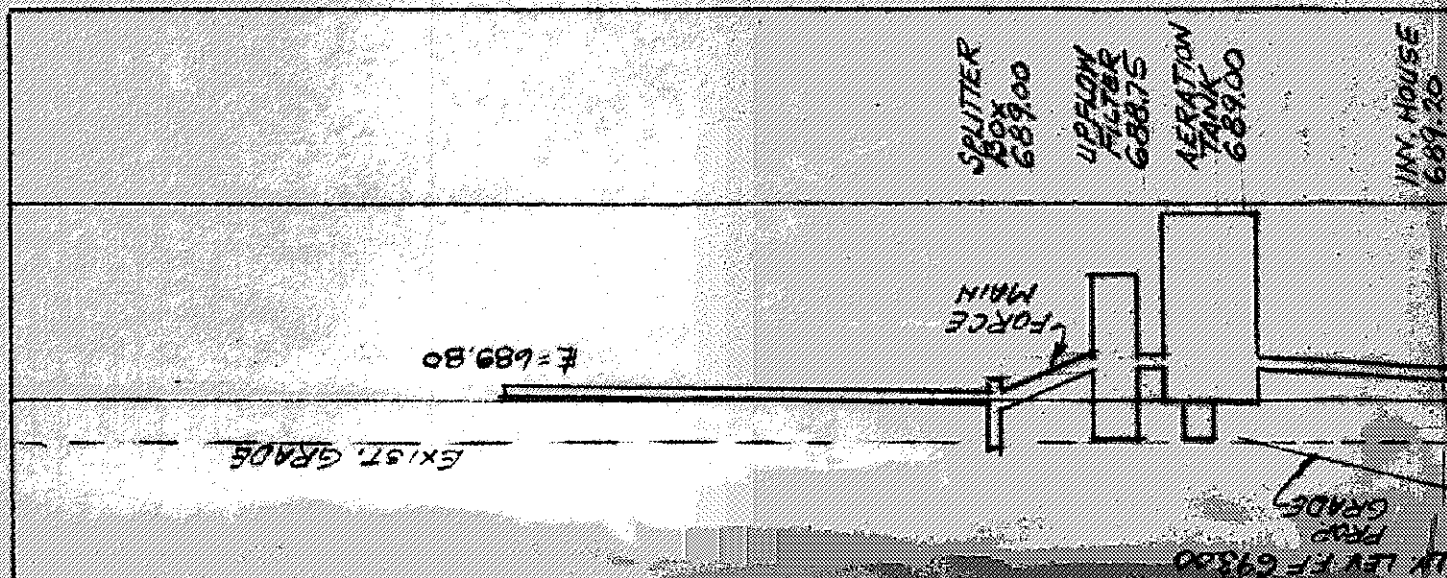

1. THE UNDERSIGNED HEREBY CERTIFY THAT THIS TOPOGRAPHY, INDICATED BY 6" 1" OR 2" CONTOURS, AND ELEVATIONS SHOWN HEREON REPRESENT AN ACTUAL FIELD SURVEY MADE BY ME ON THE 14th DAY OF DECEMBER 1992 AND THAT THE ELEVATIONS WERE TAKEN AT APPROPRIATE INTERVALS AND THAT AS OF THAT DATE THEY EXISTED AS INDICATED HEREON.

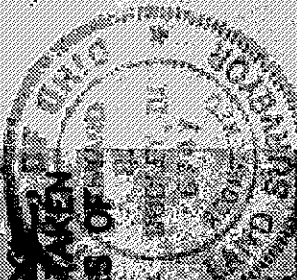

PROJECT NO. 92-380

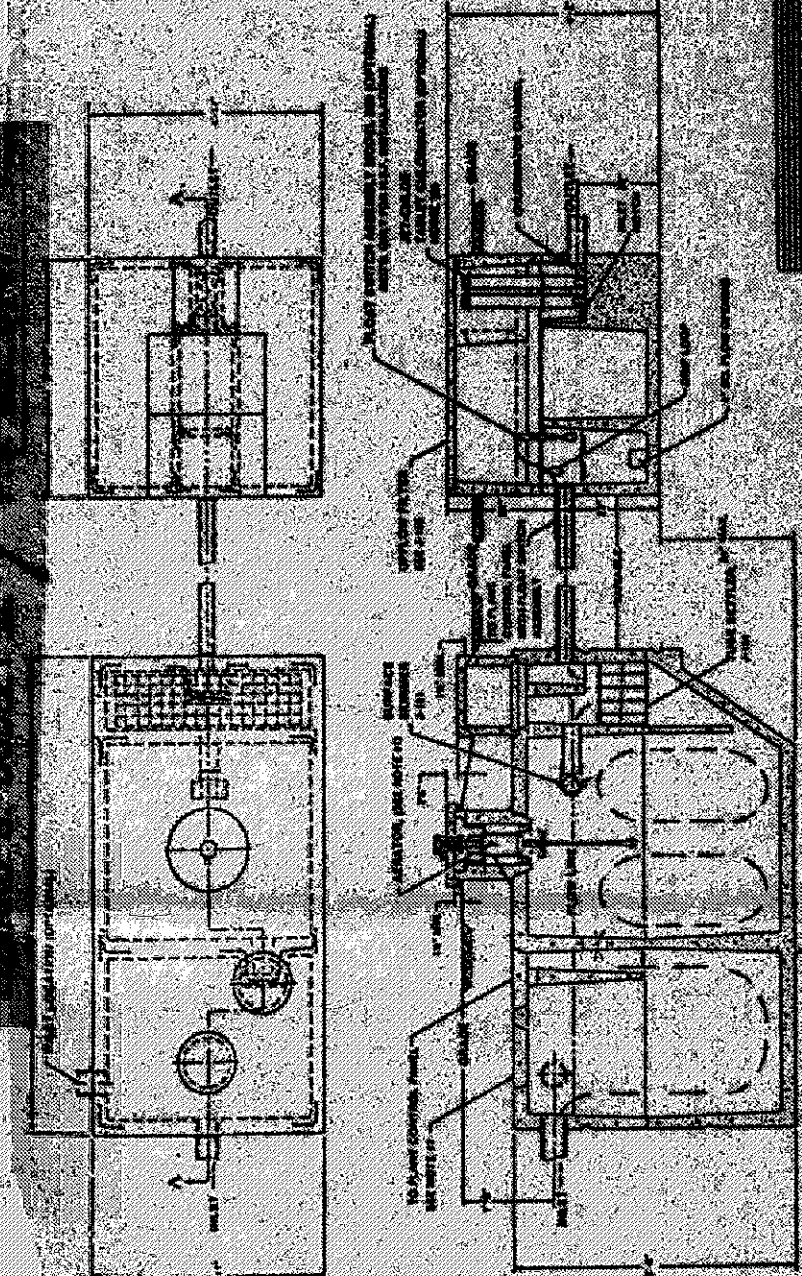


LARCHVIEW DRIVE 60'

Grading Plan Approved as shown and/or noted
THOMAS P. GILLES, P.E.
Lake County Engineer
Date 5/1/93

SITE PLAN

for: ANGELORO CONSTRUCTION
ADDRESS: 4304 MAPLE
CITY: PERRY
SUBLOT No. 10.11
W.A. & J.A. BROWN
SUBDIVISION NAME
VOL. 61
PAGE
50
PERRY
OHIO
LOT. TRACT
TOWNSHIP
THE NORTH COAST ENGINEERING AND SURVEYING CO., INC.
2570 SUPERIOR AVE., SUITE 501
CLEVELAND, OHIO 44114
TEL. (216) 241-7070 FAX (216) 241-7071

CHECK LIST
LOT DIMENSIONS & BEARINGS TO NEAREST STREET
SUBLOT NO. (PARCEL NO.)
SURROUNDING OWNERS
BUILDING DIMENSIONS
SETBACK, SIDEYARD, REARYARD
FINISHED GRADES
DRIVE & APRON TYPE, WIDTH, THICKNESS
CULVERT TYPE, DIA., LENGTH
WATER MAIN SIZE, LOCATION
SAN. M.H. CAST. ELEV., INV. ELEV.
SAN. CONN. SIZE, GRADE, LOCATION
STORM SEWER SIZE, GRADE, LOCATION
STORM M.H. CAST. ELEV., INV. ELEV.
PUMP TYPE, GRADE, CURBS
GAS LINE LOC. SIZE, APPLICATION
WELL LOCATION & ISOLATION RADIUS

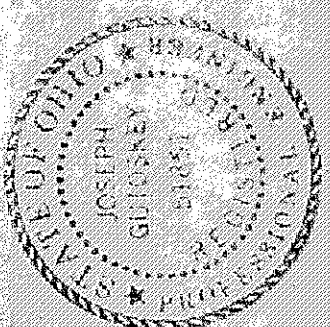


DESIGN CERTIFICATION
THIS PLAN WAS PREPARED BY ME AND IS CORRECT TO THE BEST OF MY KNOWLEDGE

"AS-BUILT" CERTIFICATION
I HEREBY CERTIFY THAT THE CIRCLED INFORMATION IS EXISTING AS OBTAINED ON THE SITE 19 AND IS CORRECT TO THE BEST OF MY KNOWLEDGE AND BELIEF

NAME	SCALE	DRAWN BY	DATE
LEGEND	1"=20'	NRH	
STORM MANHOLE		CHK'D BY	DEC. '92
SANITARY MANHOLE		JG	
EXISTING CONTOURS		REV. GABAGE	16/11/92
PROPOSED CONTOURS		REV. 4-26-93	NRH
EXIST. ELEV.		100.0	
DIRECTION OF SURFACE DRAINAGE		100.0 PROP. ELEV.	

BENCHMARK: INVERT OF INLET BASIN
STA. 12+45.15' RT.
ELEVATION: 686.80

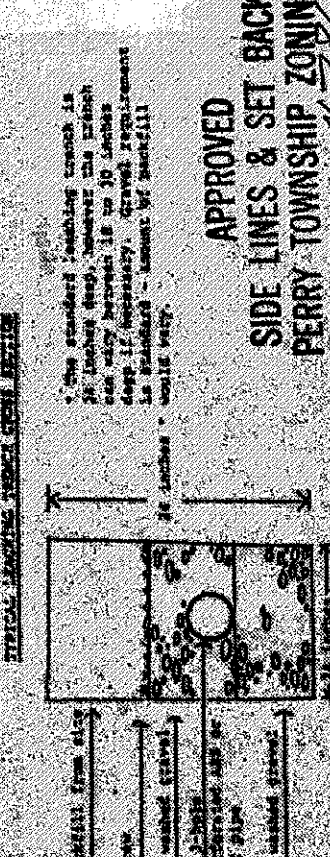

APPROVED
SIDE LINES & SET BACK
PERRY TOWNSHIP ZONING
PERMIT NO. 4426

APR 26 1993

2 WORKING DAYS BEFORE YOU DIG
CALL TOLL FREE 800-362-2764

CONTRACT NO. 92-380