

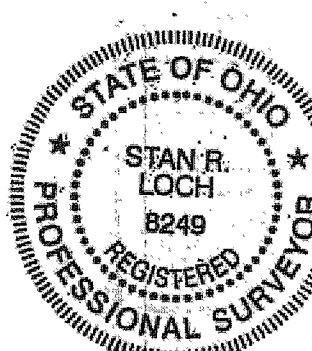



Rev. L.S. 7-17-14

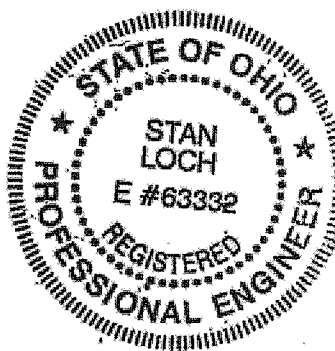

ALL CONCRETE TO BE A MINIMUM
4,000 PSI/ 28 DAYS
PUBLIC WALKS WILL BE 4" THICK (6" AT DRIVE CROSSING)
6.5 SACK MIX CONCRETE WITH 7%
AIR ENTRAINMENT
DRIVEWAYS MUST BE 4" THICK (6" AT APRON) 6.5 SACK
MIX CONCRETE WITH 7% AIR
ENTRAINMENT, AND SHALL BE REINFORCED
WITH 6"x6" #10 WELDED WIRE MESH
INSTALLED APPROXIMATELY 1" TO 2"
FROM BOTTOM OF SLAB

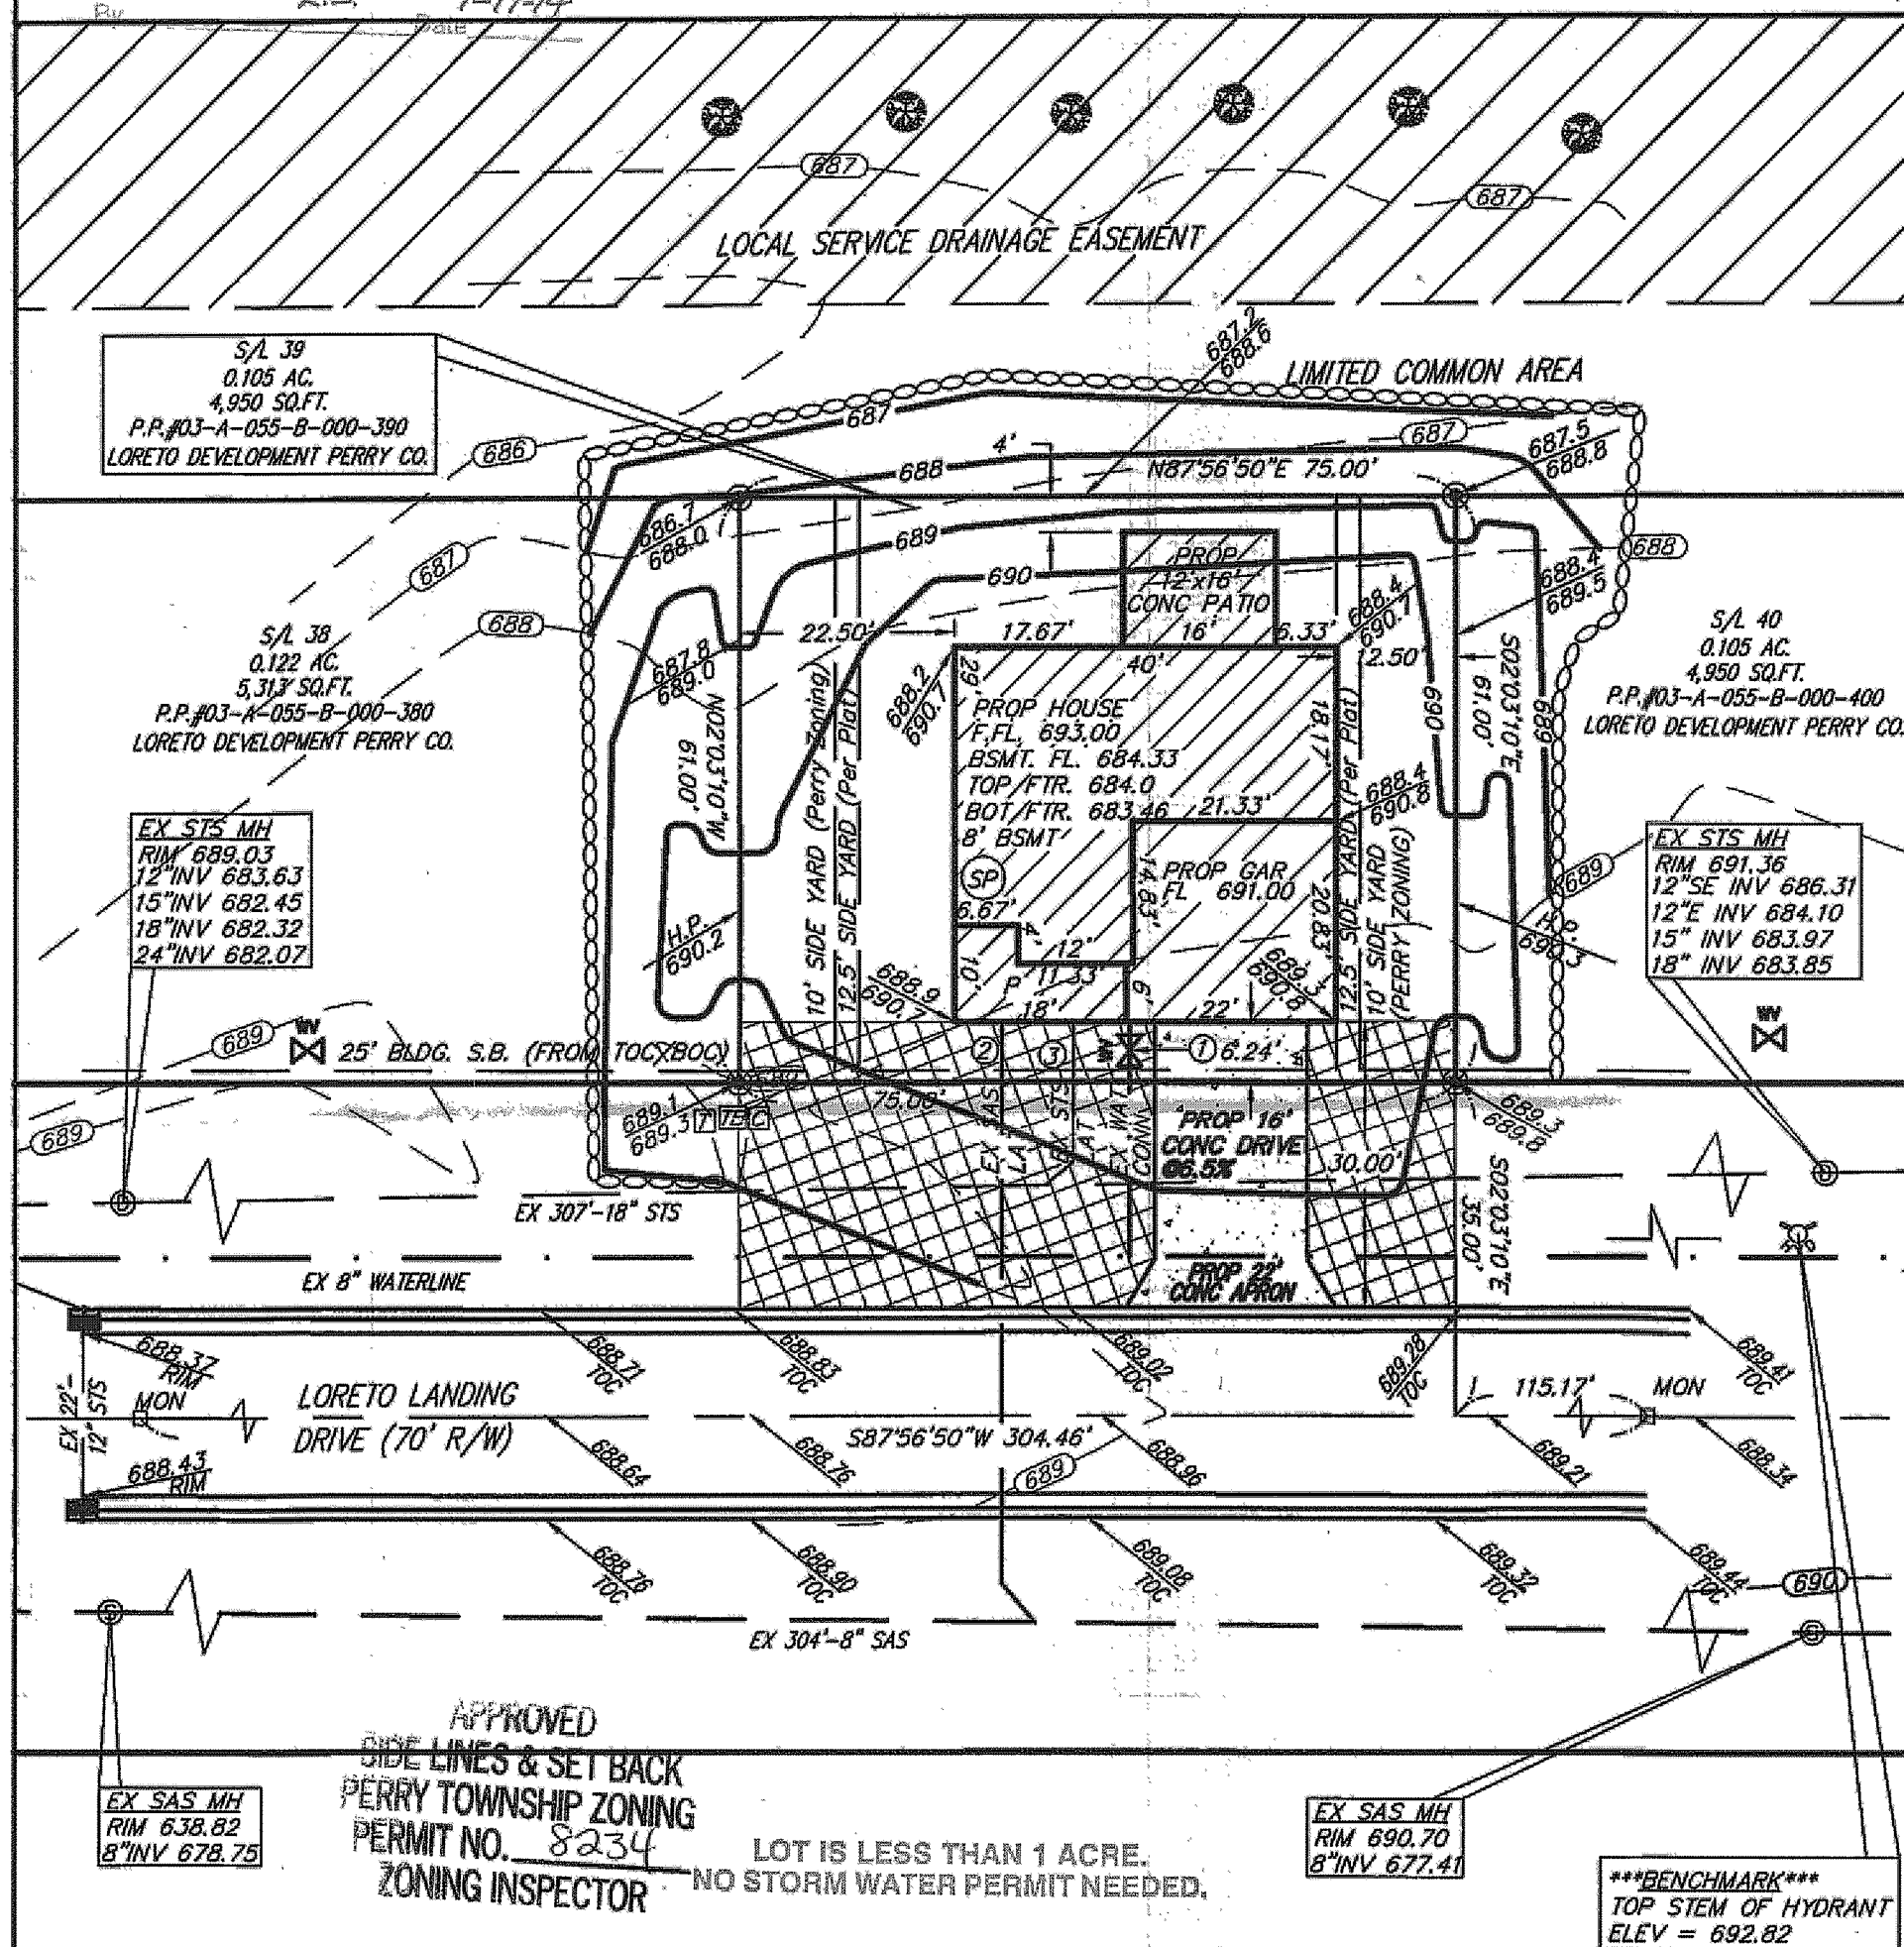

- = IRON PIN SET
- = MONUMENT BOX
- ⊙ = SANITARY MANHOLE
- Ⓢ = STORM MANHOLE
- 7 = TELEPHONE PEDEST.
- Ⓢ = TRANSFORMER BOX
- Ⓢ = CABLE PEDESTAL
- WV = WATER VALVE
- Ⓢ = FIRE HYDRANT
- Ⓢ = CURB INLET

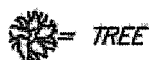


EXISTING GRADE
PROPOSED GRADE

**BUILDER: B.R. KNEZ
CONSTRUCTION
7555 FREDLE DRIVE-SUITE 210
CONCORD TWP, OHIO 44077
PHONE: (440) 710-0711**

BENCHMARK
TOP STEM OF HYDRANT
IN FRONT OF S/L 41
ELEV = 692.82

NOTE:
BEARINGS ARE TO
AN ASSUMED MERIDIAN
AND ARE USED TO
DENOTE ANGLES ONLY

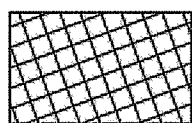

= 30' TEMPORARY
SEEDING/MULCHING

① = PROP WAT CONN
② = PROP SAS CONN
③ = PROP STS CONN

*****THE CONTRACTOR MUST CHECK THE BENCHMARK WITH THE CURB GRADES PRIOR TO DIGGING THE FOUNDATION.*****

"I, THE UNDERSIGNED HEREBY CERTIFY THAT THIS TOPOGRAPHY, INDICATED BY 6", ① OR 2" CONTOURS, AND ELEVATIONS SHOWN HEREON REPRESENT AN ACTUAL FIELD SURVEY MADE BY ME ON THE 29TH DAY OF MAY, 2014 AND THAT THE ELEVATIONS WERE TAKEN AT APPROPRIATE INTERVALS AND THAT AS OF THAT DATE THEY EXISTED AS INDICATED HEREON."

NAME 0 h 6-26-14 REG.#

HORIZ. SCALE: 1"=20'

VERT. SCALE:

DRAWN BY: AJR

DATE: 6/23/2014

CHECKED BY: SRL

DRAWING NO.: 20142932

JOB NO.: 20142932

SHEET: 1 OF 3

5428 WARNER ROAD - SUITE 12
VALLEY VIEW, OHIO 44125

440-602-9071

FAX 216-369-0259

AZTECH

ENGINEERING + SURVEYING
Civil Engineering + Land Surveying

**SITE PLAN FOR
B.R. KNEZ
CONSTRUCTION, INC.**

#TBD LORETO LANDING DRIVE
BEING SUBLOT 39 IN THE
LORETO LANDINGS SUBDIVISION
PLAT VOLUME 44, PAGE 26
P.P.#03-A-055-B-000-390
TOWNSHIP OF PERRY, COUNTY OF LAKE
STATE OF OHIO

NO.	DATE	DESCRIPTION	BY	