


Grading Plan Approved
as shown and/or noted
THOMAS P. GILLES, P.E.
Lake County Engineer


by *JWK* Date *26 July 73*

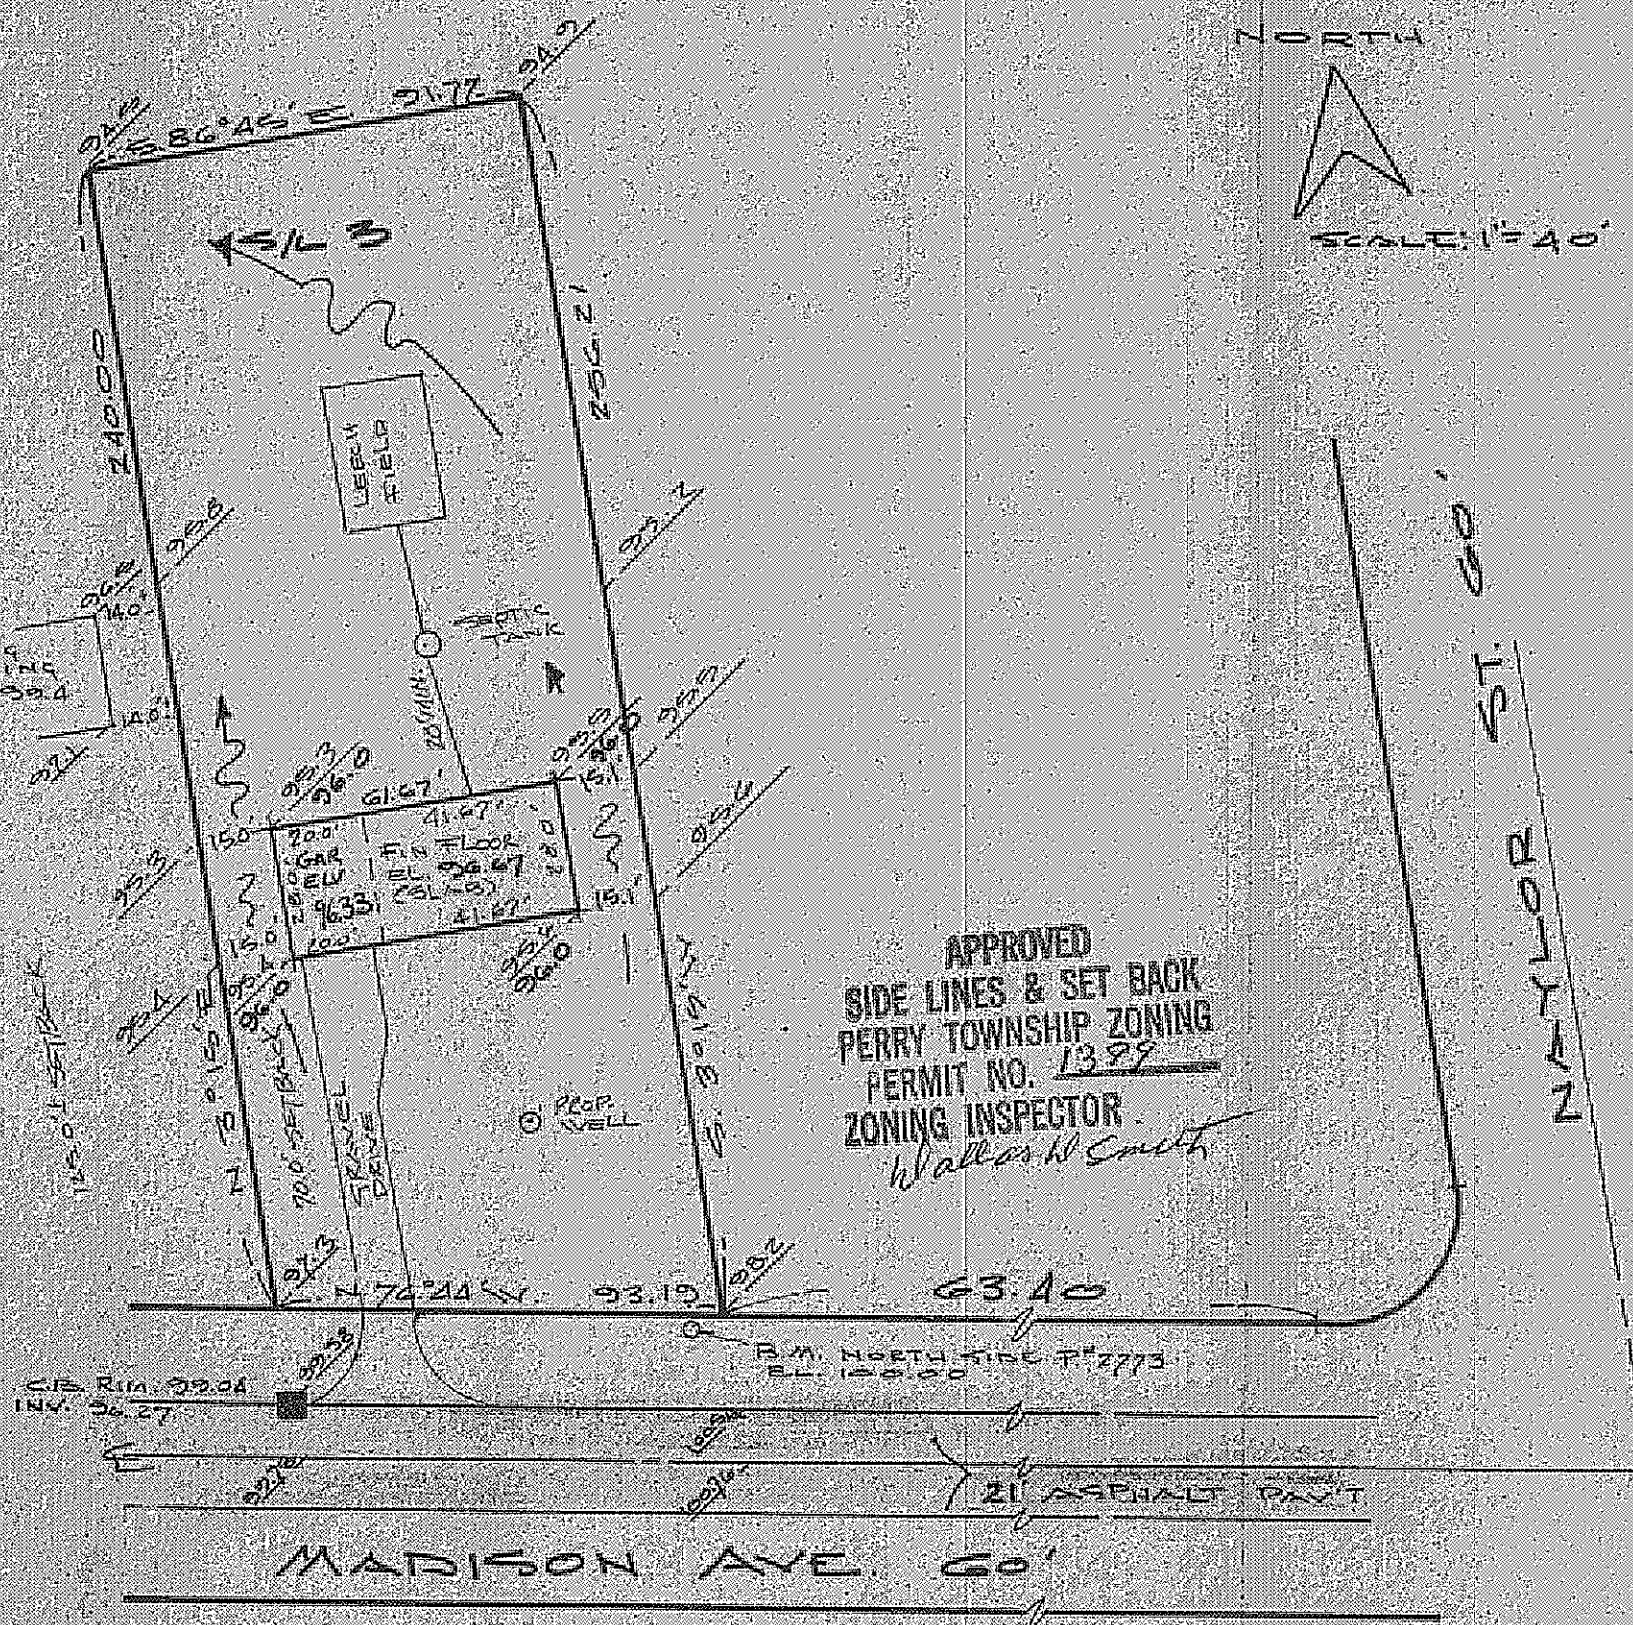

APPROVED
SIDE LINES & SET BACK
PERRY TOWNSHIP ZONING
PERMIT NO. 1399
ZONING INSPECTOR
Wallace W. Smith

"AS BUILT" CERTIFICATION
I HEREBY CERTIFY THAT THE CIRCLED GRADES ARE EXISTING FINISH
GRADES CHECKED IN FIELD ON 19 73 BY
SURVEYING AND ARE CORRECT TO THE BEST OF MY KNOWLEDGE AND BELIEF

REGISTERED SURVEYOR NO.

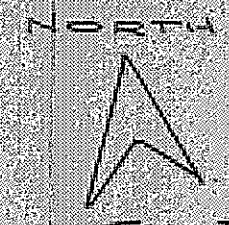

SITE PLAN

PERRY TOWNSHIP LAKE COUNTY, OHIO

for CHARLES RHODES
CLIENT OWNER

ADDRESS		STREET	CITY	ZIP
<u>MADISON AVE EXT.</u>		<u>ST.</u>	<u>PAINESVILLE</u>	<u>44069</u>
SUBDIVISION	LOT	TRACT		
<u>S/L 3</u>	<u>K</u>	<u>NO</u>		
SUBLOT NO.	VOLUME	PAGE		
<u>NO</u>	<u>MADISON AVE</u>	<u>NO</u>		
TERM		PARCEL #	STREET	

LEGEND

- | | | | |
|----------------------|-------|---|-----|
| SANITARY MANHOLE | --- | WATER VALVE (GAS) | --- |
| STORM MANHOLE | --- | WATER METER (GAS) | --- |
| INLET OR CATCH BASIN | --- | AS BUILT ELEVATION | --- |
| HYDRANT | --- | INDICATES DIRECTION OF SURFACE DRAINAGE | --- |
| EXISTING CONTOURS | --- | | |
| PROPOSED CONTOURS | --- | | |
| EXIST. ELEV. | --- | | |
| | 100.0 | PROP. ELEV. | --- |

REMARKS

ALL BOUNDARY DATA SHOWN WAS OBTAINED FROM IDEEDS RECORDED
SUBDIVISION PLAT, OR OTHER PUBLIC RECORDS

DESIGN CERTIFICATION

THIS PLAN WAS PREPARED BY ME, AND IS CORRECT
TO THE BEST OF MY KNOWLEDGE AND BELIEF
Richard J. Salo
NAME SURVEYOR REGISTRATION NO. PS# 5244

CHECK LIST

- | | |
|------------------------------|---------------------------------|
| DIMENSIONS | WATER MAIN SIZE LOCATION |
| BEARINGS | SAN SEWER SIZE 24" GR LOC |
| TIE TO NEAREST STREET | SAN MH CAST ELEV. INV. ELEV. |
| SUBLOT NO. PARCEL NO. | SAN CONN. SIZE LOC. DEPTH |
| SURROUNDING OWNERS | STORM SEWER SIZE 24" GR LOC |
| BLOO DIMENSIONS FIN GR | STORM MH. CAST ELEV. INV. ELEV. |
| BLOO TIES FLR GRADES | PAYT TYPE GRADE CURBS |
| APRON TYPE WIDTH THICKNESS | GAS LINE LOC. SIZE PRESSURE |
| ST WALK TYPE WIDTH THICKNESS | SEPTIC TANK SIZE LOC. |
| CULVERT TYPE DIA. LENGTH | WELL LOCATION |

REVISIONS			PLAN PREPARED BY		
NO.	DATE	BY	DEBEVEC-SALO & ASSOC., INC.		
1			NAME		
2			<u>130 E. JACKSON ST. PAINESVILLE, O.</u>		
3			ADDRESS		
4			DRAWN BY	SCALE	DRAWING NO.
5			CHKD	1"=40'	
			CREW CHIEF	DATE	
				<u>6/12/73</u>	<u>3956-3</u>