

Milford Dr
Perry Twp.



June 2068

SITE PLAN FOR:
WM. S. BRYAN
LOT 12 HAWAIIAN DR.
MILFORD, OHIO
BRING S/L 14 IN THE HOWARD FRYE
ALLOTMENT IN PERRY TOWNSHIP, LAKE
COUNTY, OHIO.

PREPARED BY:
WM. R. GRAY ASSOC INC
7547 MENTOR AVE
MENTOR, OHIO
SCALE: 1"=20'
DATE: MAY 8, 1978

CERTIFICATION:
I HEREBY CERTIFY THAT THIS PLAT
IS CORRECT TO THE BEST OF MY
KNOWLEDGE
By: Wm. R. Gray
WM. R. GRAY REG. SURV. #2752

Grading Plan Approved
as shown and/or noted
THOMAS P. GILLES, P.E.
Lake County Engineer
By: [Signature] Date: 10 MAY 78

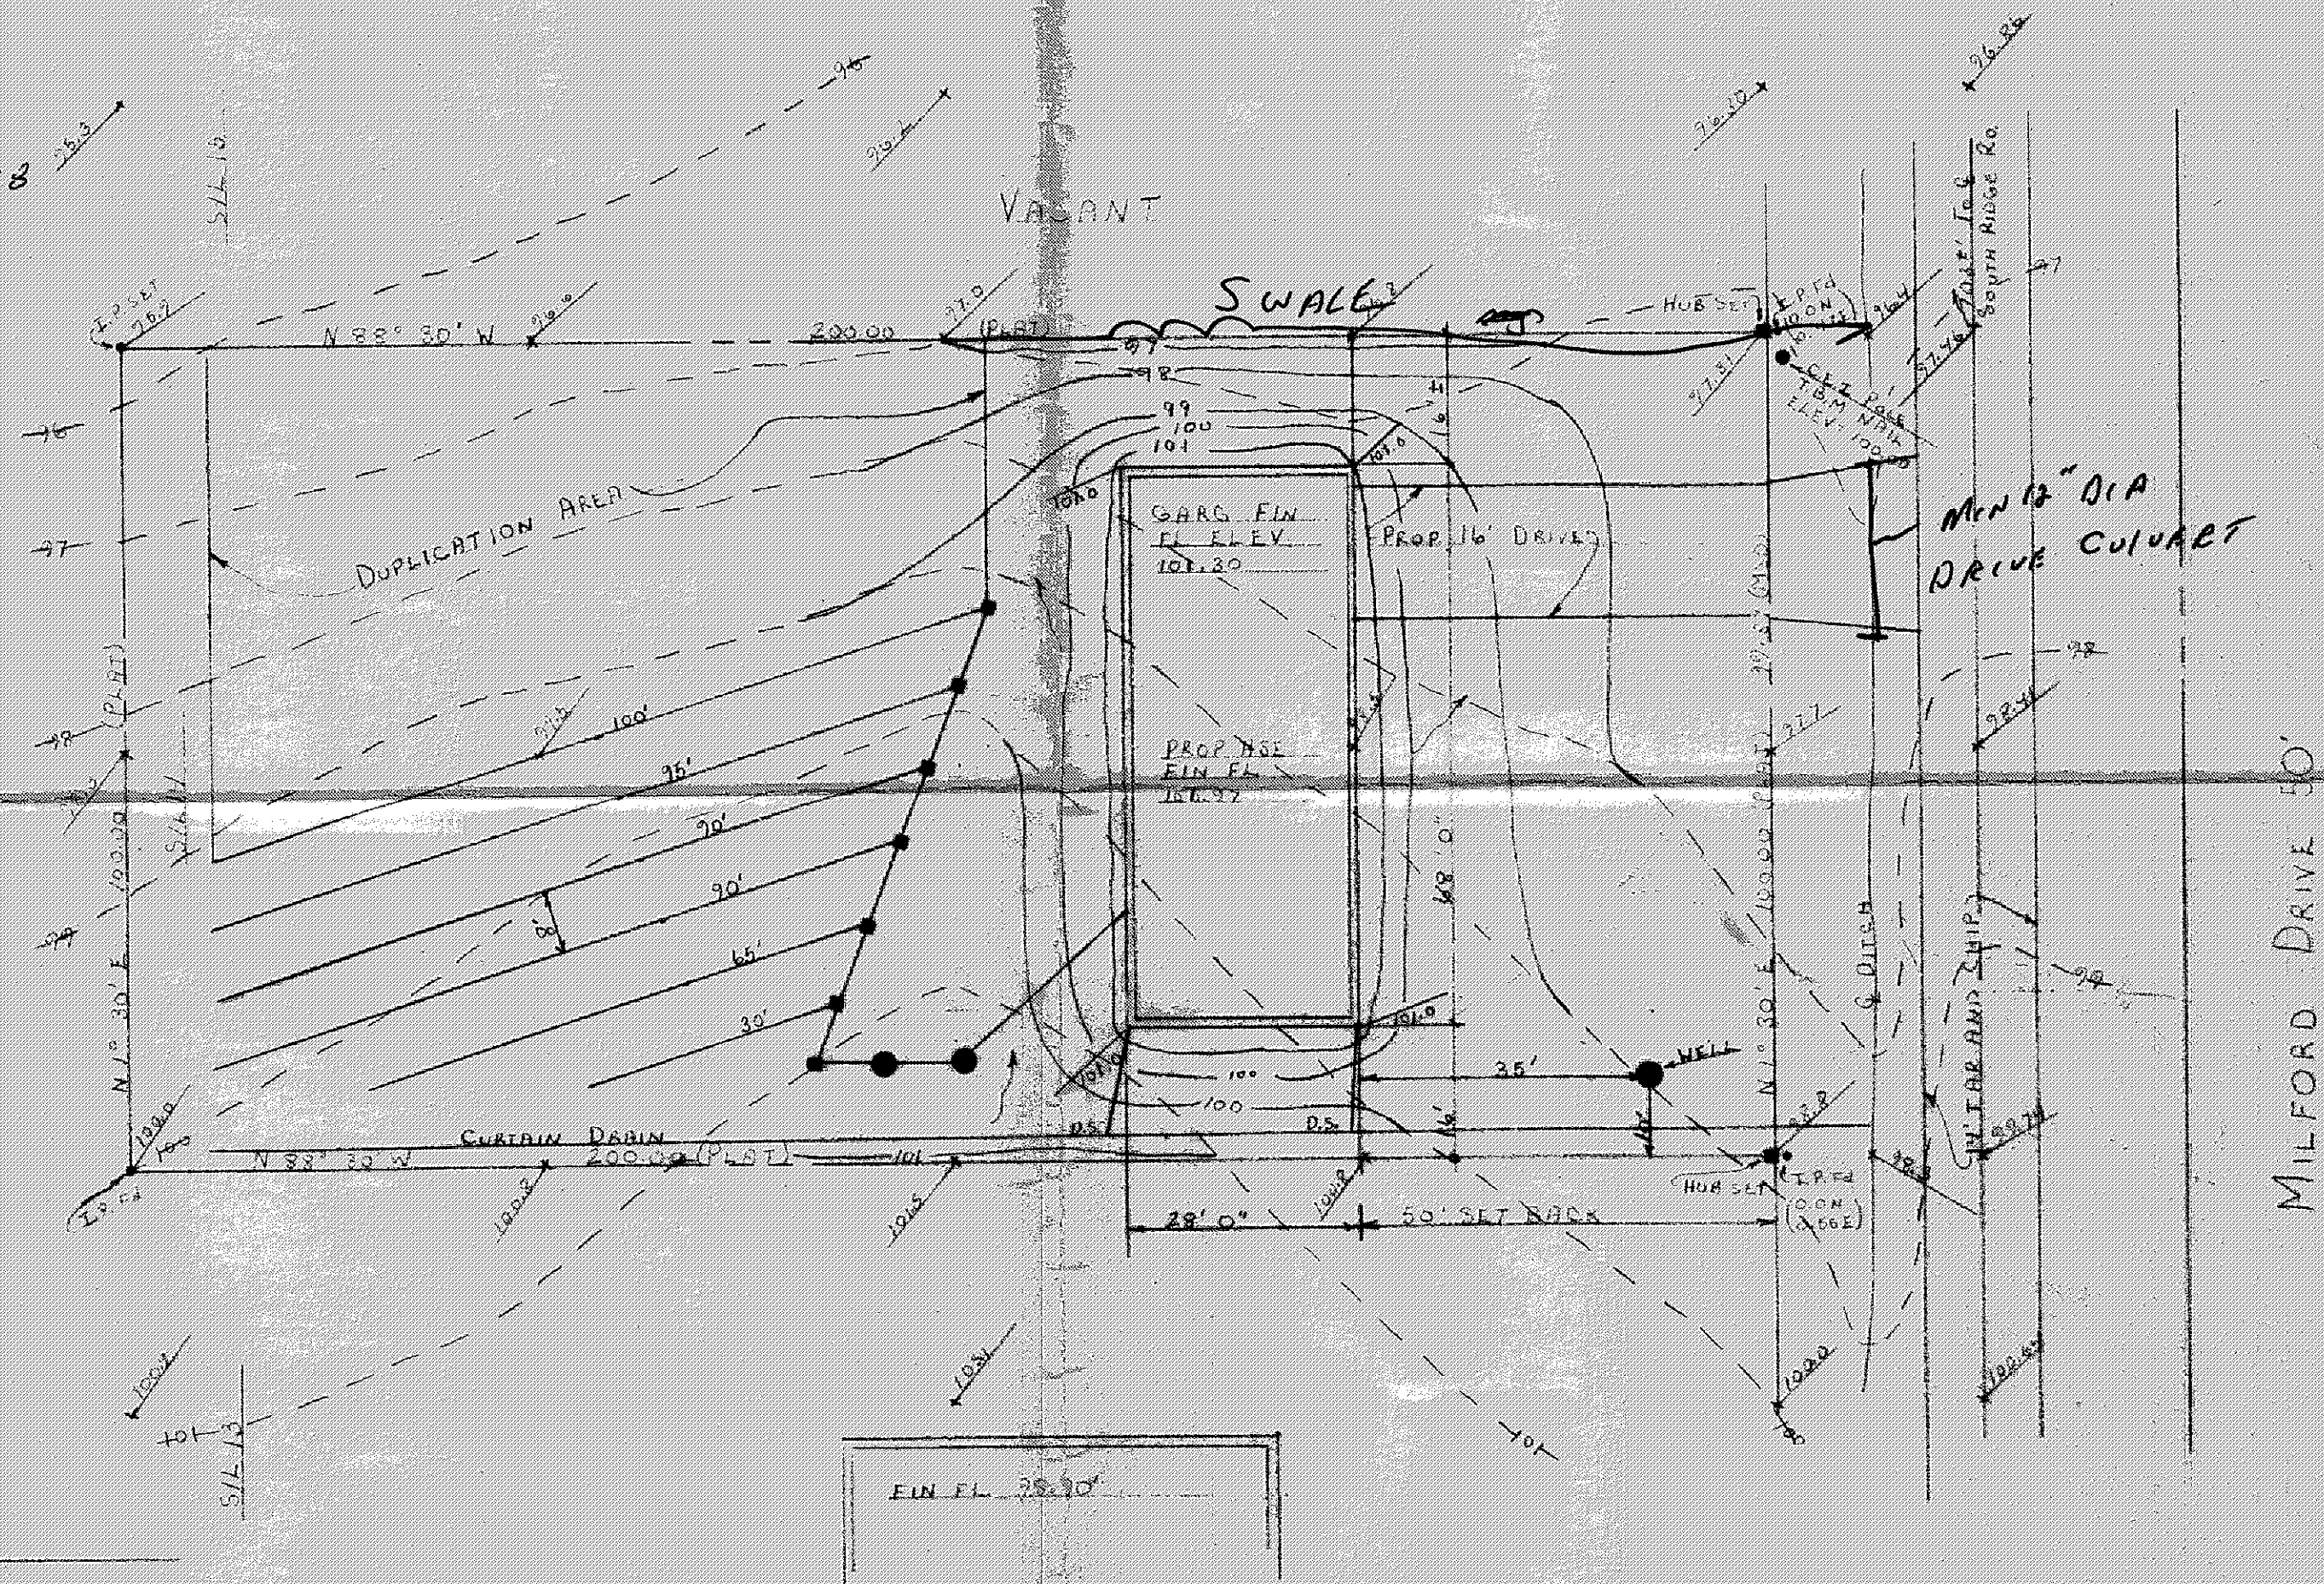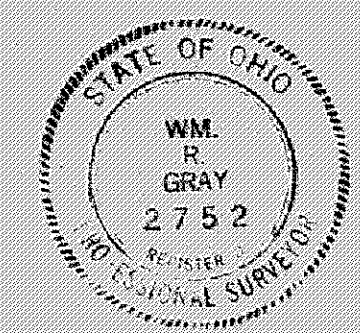

SEPTIC PROFILE
SCALE: HORIZ-1"=20' VERT-1"=5'

