


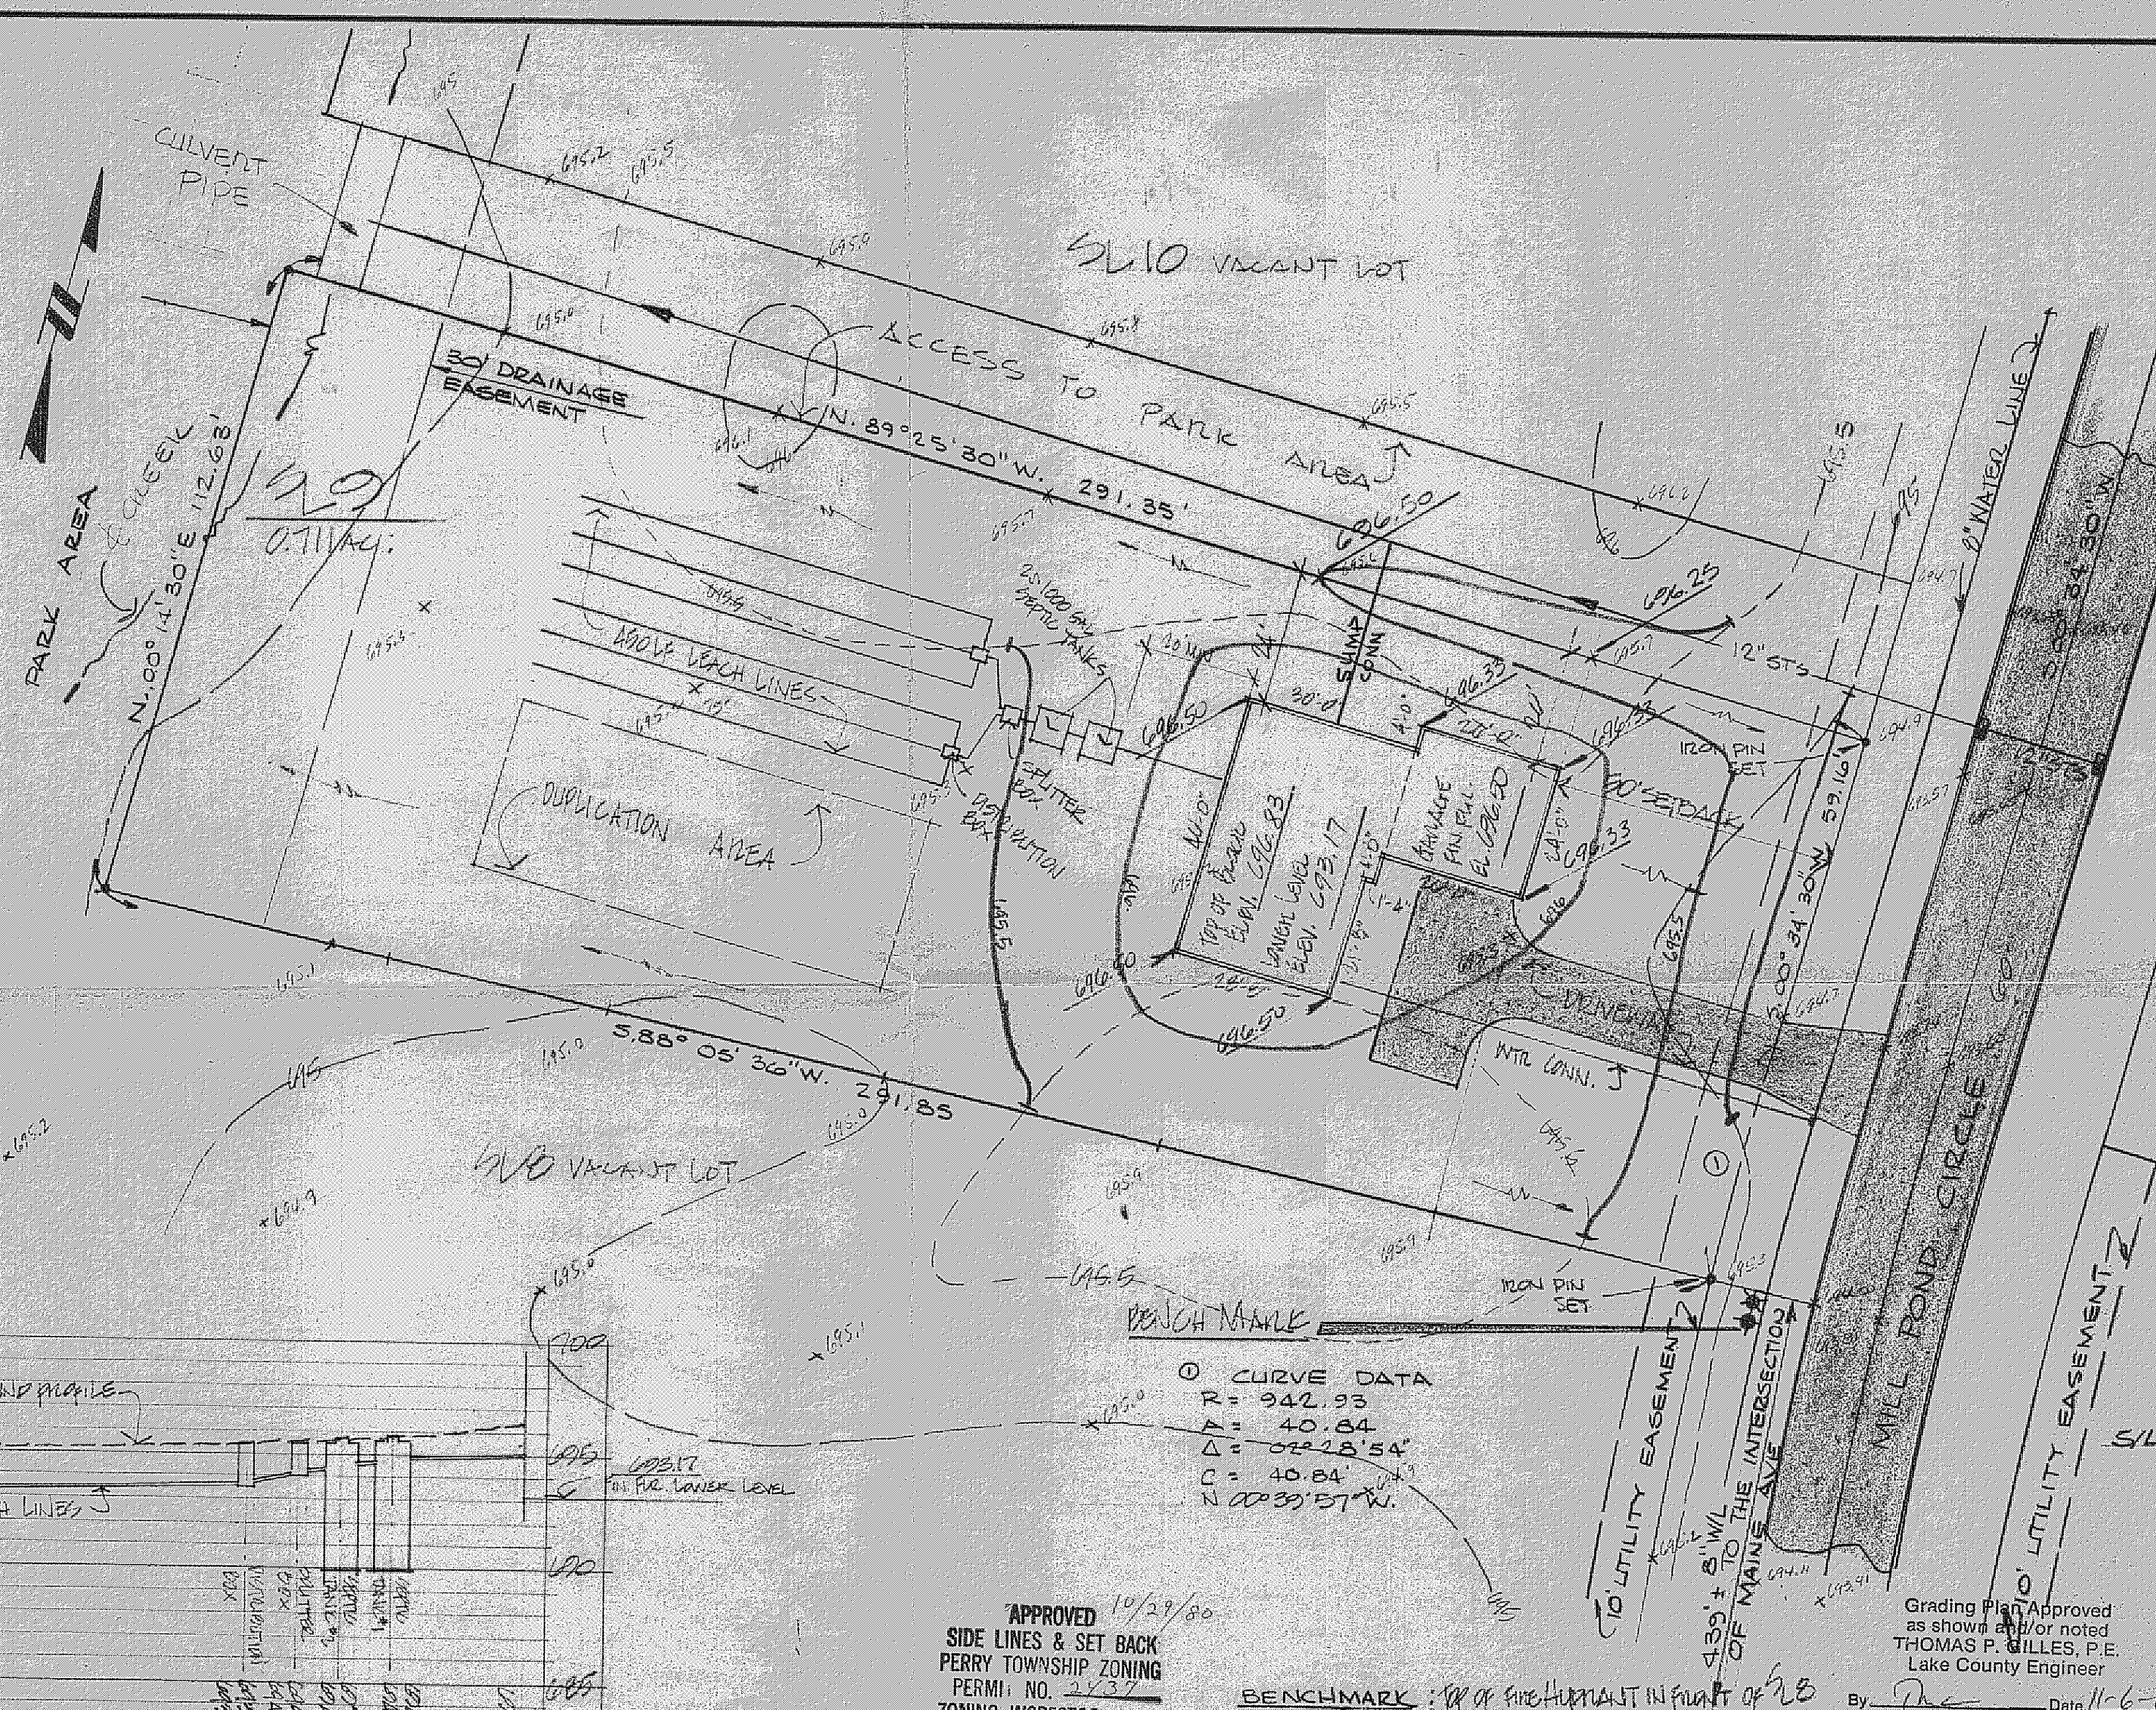


① CURVE DATA
 R = 942.93
 A = 40.84
 Δ = 0°28'54"
 C = 40.84
 N 00°39'57"W.

APPROVED 10/29/80
 SIDE LINES & SET BACK
 PERRY TOWNSHIP ZONING
 PERMIT NO. 2437
 ZONING INSPECTOR
Rw. Retention

BENCHMARK: TOP OF FIRE HYDRANT IN FRONT OF 528
 ELEV. 696.63

Grading Plan Approved
 as shown and/or noted
 THOMAS P. GILLES, P.E.
 Lake County Engineer

By *Tom* Date 11-6-80

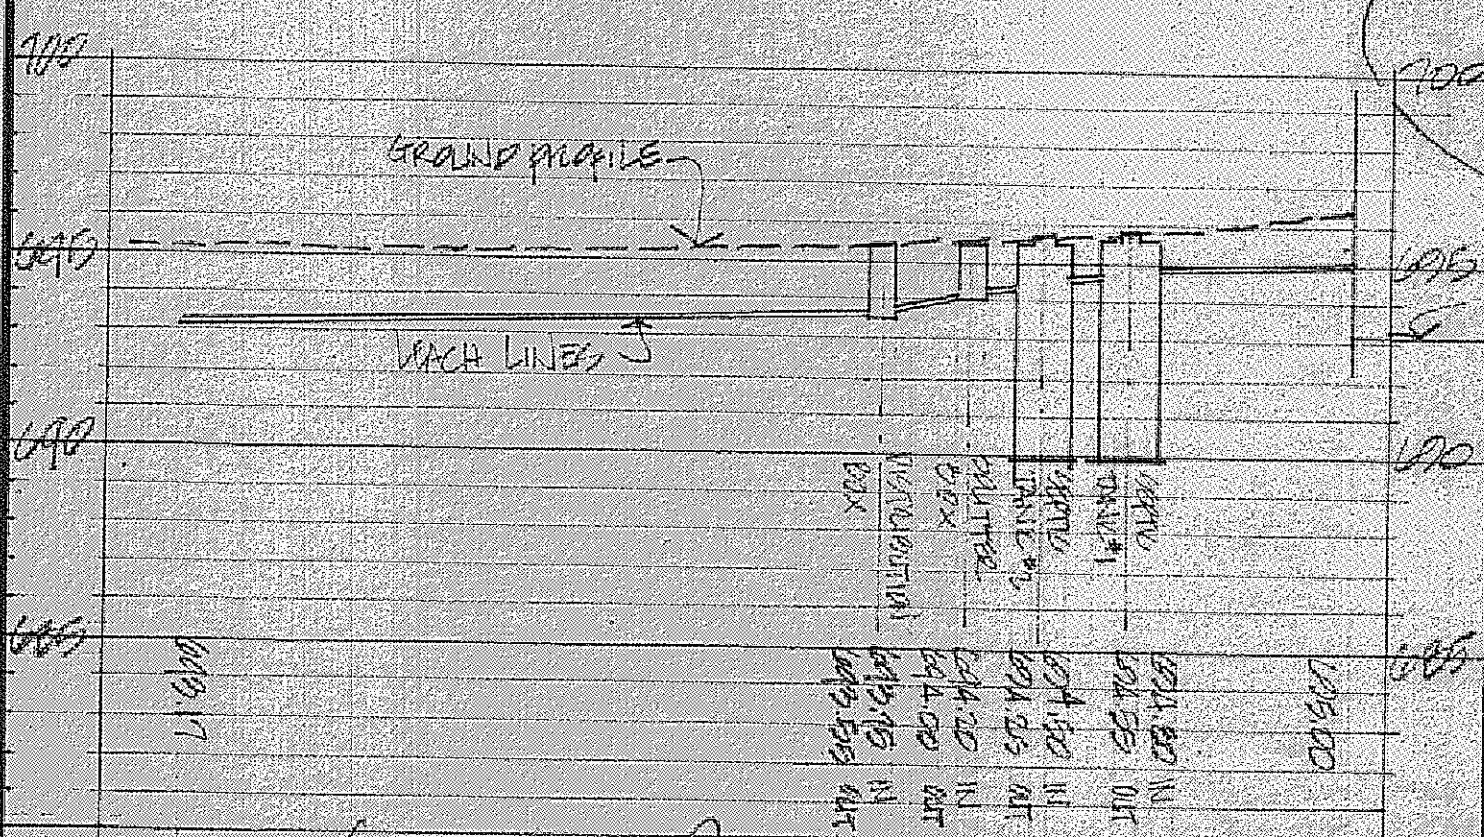

VERTICAL SYSTEM PROFILE
 SCALE: HORIZ. 1"=20'
 VERT. 1"=5'

DESIGN CERTIFICATION
 THIS PLAN WAS PREPARED BY ME
 AND IS CORRECT TO THE BEST OF
 MY KNOWLEDGE AND BELIEF.
Chris J. J. J.
 REG. SURVEYOR NO. 4785

AS BUILT CERTIFICATION
 I HEREBY CERTIFY THAT THE CIRCLED GRADES
 ARE EXISTING FINISH GRADES CHECKED IN THE
 FIELD ON 10/29/80 AND THAT
 SURVEY IS CORRECT TO THE BEST OF MY
 KNOWLEDGE AND BELIEF.
 REG. SURVEYOR NO.

SITE PLAN FOR
CASEMENT HOMES
 BEING S/L No. 9, OAKBROOK VILLAGE SUBDIVISION
 TOWNSHIP OF PERRY, LAKE COUNTY, OHIO

DATE 10/9/80
 SCALE 1"=20'
 DRAWN BY *CP*
 CHECKED BY *W*
 P.L. 11/4

COLPETZER · WOODS
 CONSULTANTS, INC.
 MENTOR, OHIO 44060

SHEET
 1
 CONTRACT NO.
 43-2