

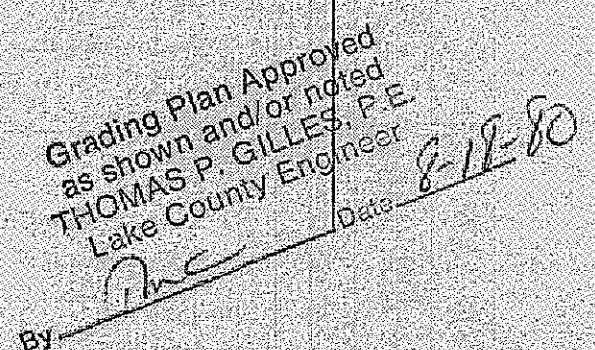


R. W. Pittler

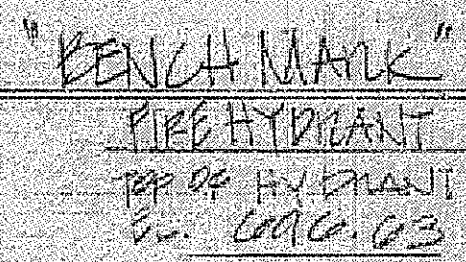

DESIGN CERTIFICATION THIS PLAN WAS PREPARED BY ME, AND IS CORRECT TO THE BEST OF MY KNOWLEDGE AND BELIEF. <i>W. J. H. H. H. H. H.</i> REG. SURVEYOR NO. <u>576</u>	AS-BUILT CERTIFICATION I HEREBY CERTIFY THAT THE CIRCLED GRADES ARE EXISTING FINISH GRADES CHECKED IN FIELD ON _____ AND THIS SURVEY IS CORRECT TO THE BEST OF MY KNOWLEDGE AND BELIEF. REG. SURVEYOR NO. _____
---	---

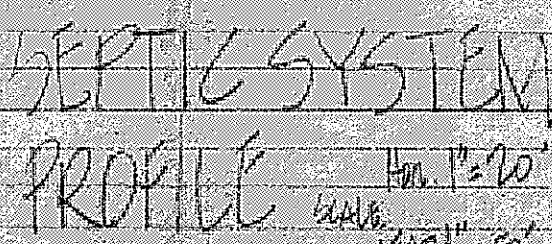

DATE <u>Aug. 7, 1983</u>		COLPETZER · WOODS CONSULTANTS, INC. MENTOR, OHIO 44060	SHEET <u>1</u>
SCALE <u>"1" = 20'</u>			CONTRACT NO. <u>79-26</u>
DRAWN BY <u>C. J. T. T.</u>			
CHK'D BY <u>W. J. T. T.</u>			
P.B.F. <u>304</u> PG.			



COLPETZER · WOODS
CONSULTANTS, INC.
MENTOR, OHIO 44060