

July 1985 1"=30'

TYPICAL SECTIONS N.T.S.


TYPICAL SECTIONS N.T.S.

CURTAIN DRAIN TRENCH
T.S.
APPROVED


**SIDE LINES & SET BACK
PERRY TOWNSHIP ZONING**

ERMIT NO. 2715


ZONING INSPECTOR
R.W. Pattenbome

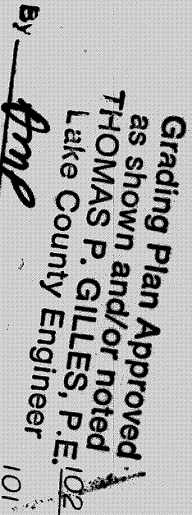

Bernard D. Westfall, P.S.
Bernard D. Westfall, P.S.
A'TERRA SURVEY CO.
Jefferson, Ohio

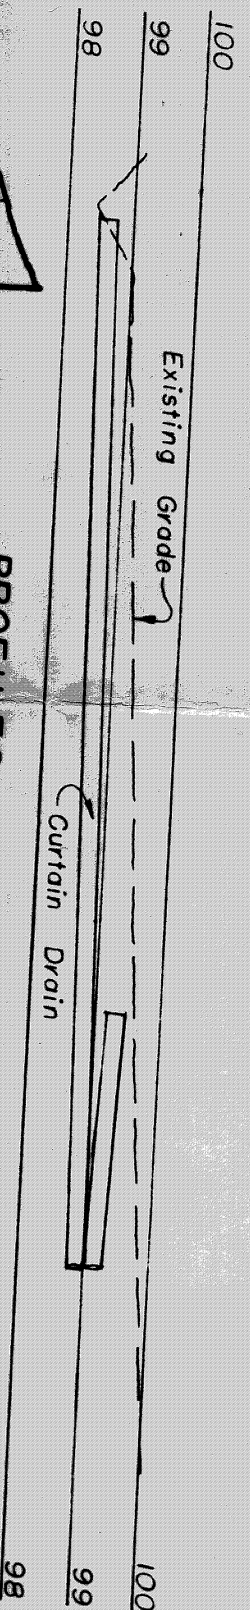


$1'' = 3'$ Vert. $1'' = 30'$ Horiz

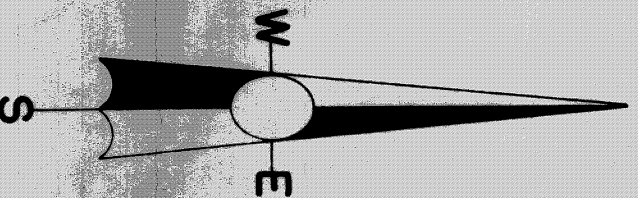

All Iron Pins Set are identified by _____

by a plastic cap, (A'TERRA 6634).

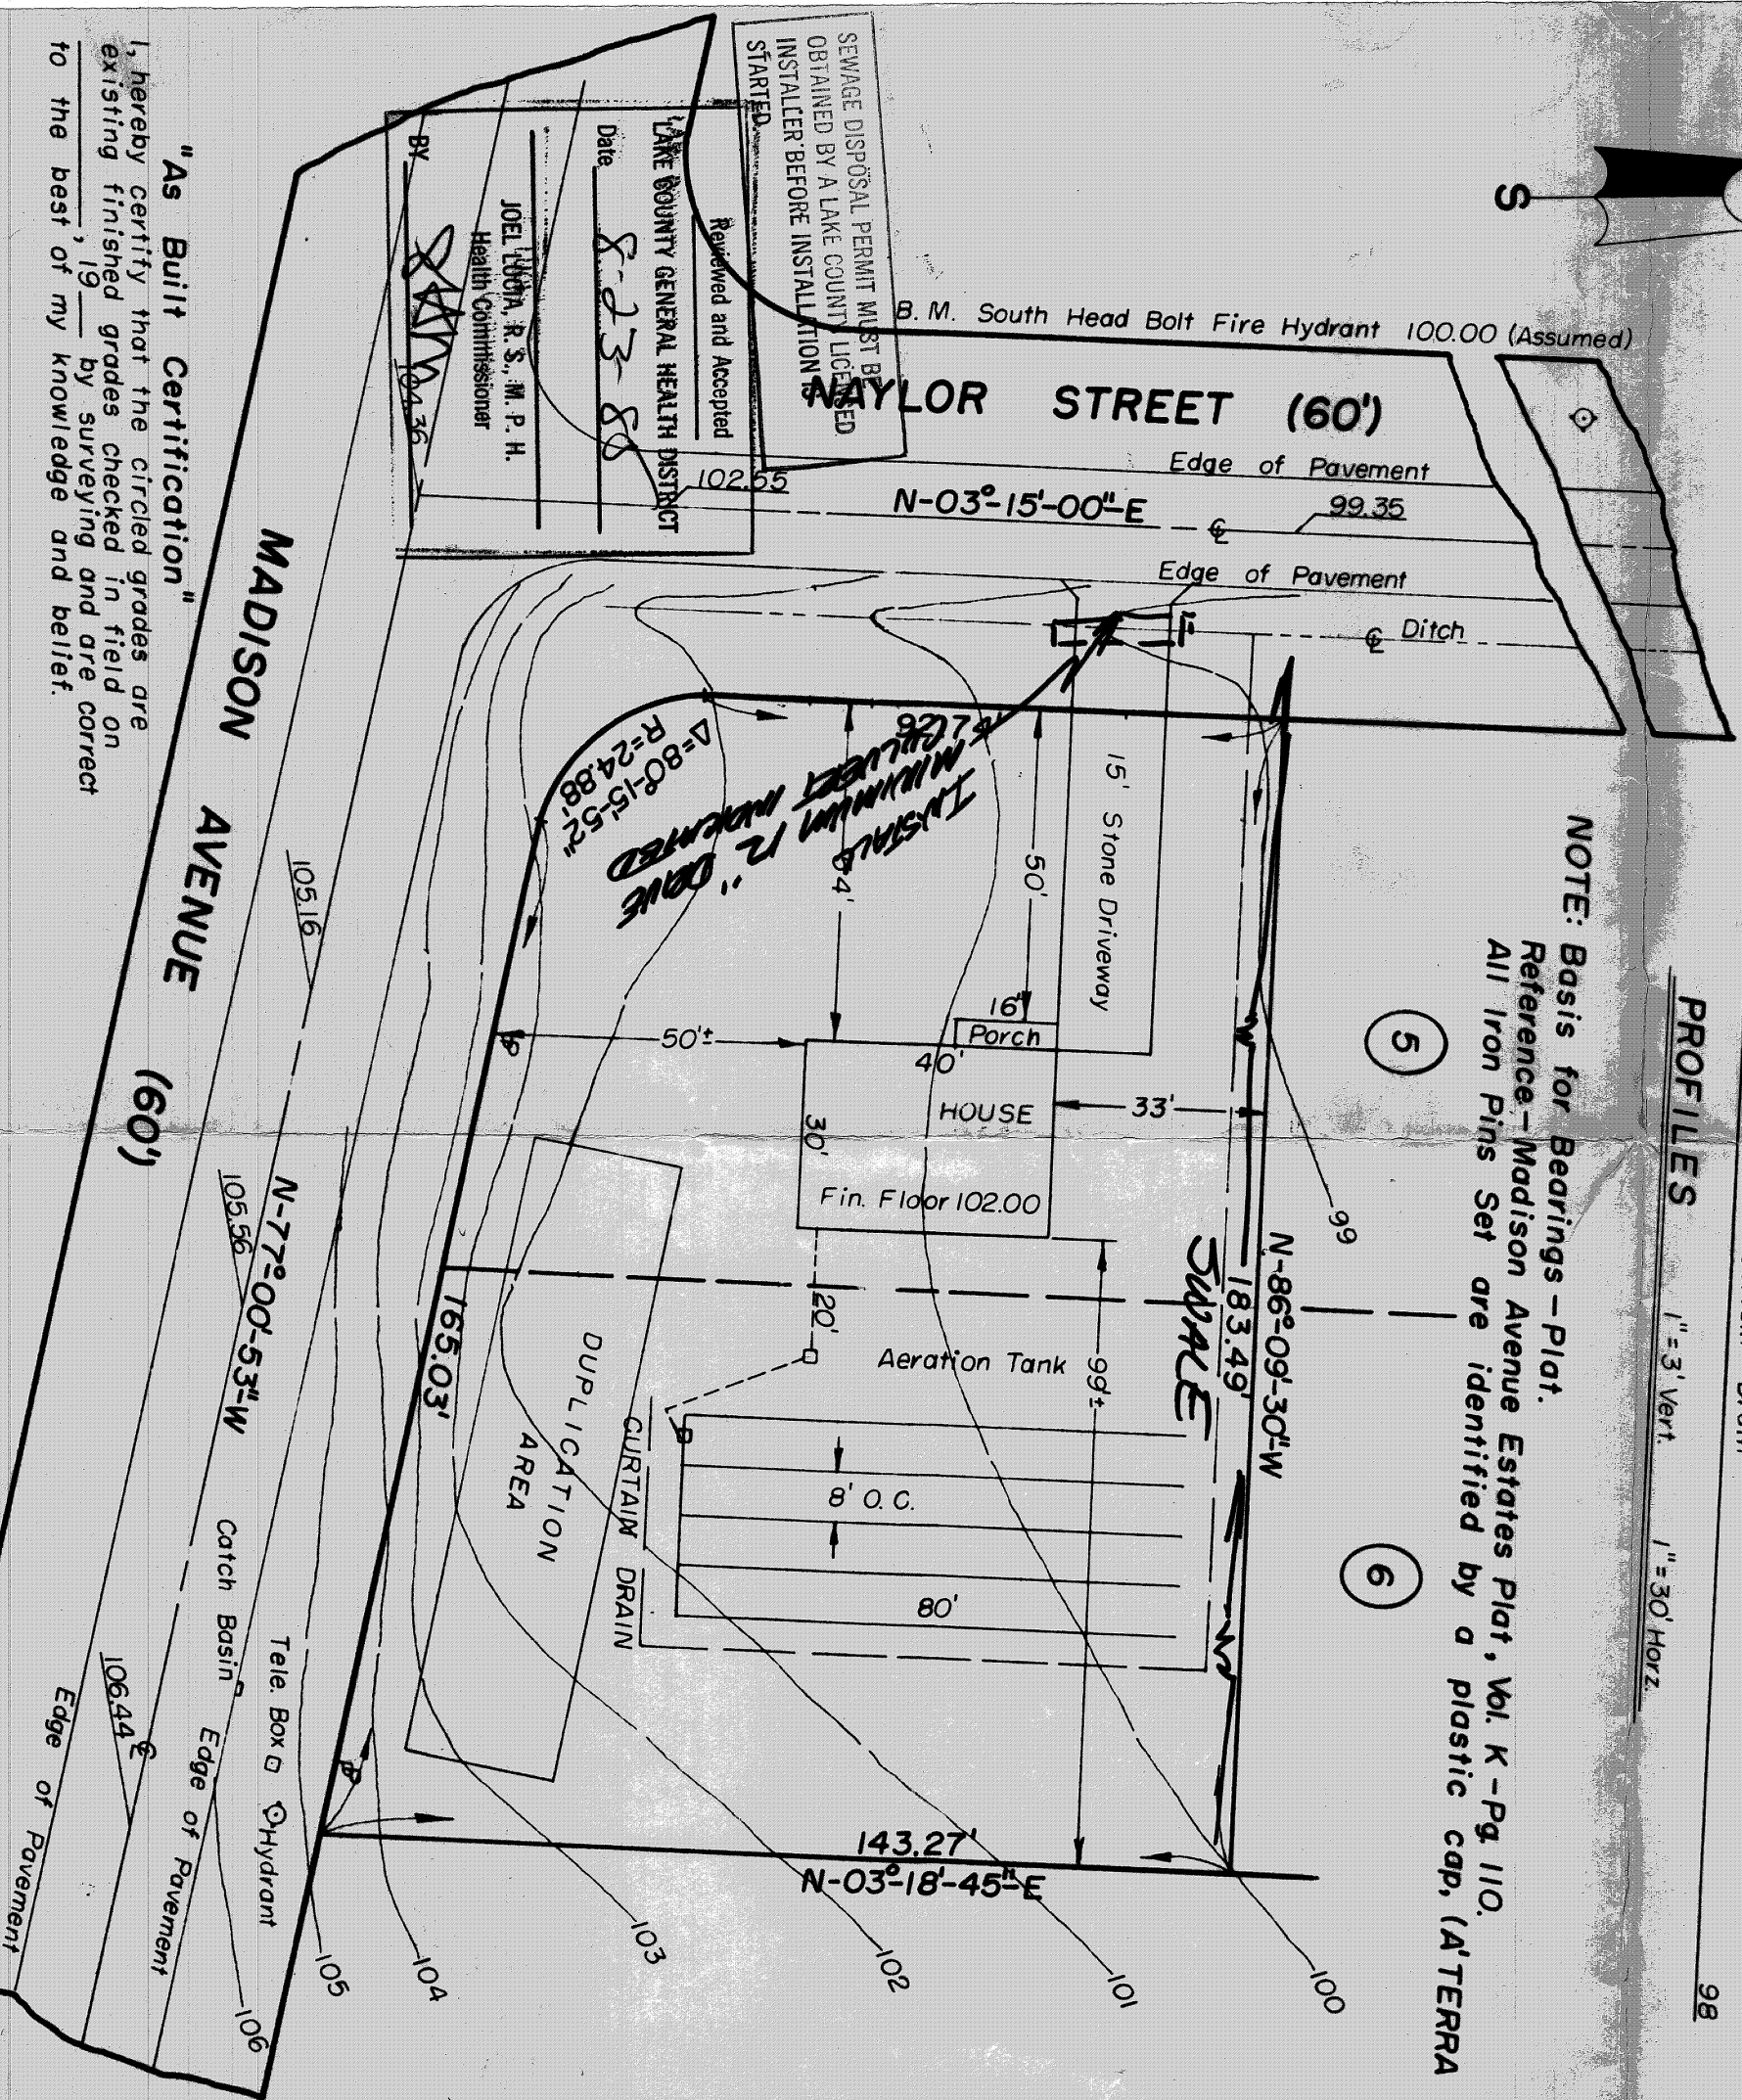

"As Built Certification"
I, hereby certify that the circled grades are
existing finished grades checked in field on
_____, 19____, by surveying and are correct
to the best of my knowledge and belief.

Bernard D. Westfall P.S. 6634