



REVIEWED AND ACCEPTED
LAKE COUNTY GENERAL
HEALTH DISTRICT

Date 4-2-97 BY J. Lindsay
4 Bedroom


SEWAGE DISPOSAL PERMIT MUST BE
OBTAINED BY A LAKE COUNTY LICENSED
INSTALLER BEFORE INSTALLATION IS
STARTED.

STATE LINES & SET BACK
PERRY TOWNSHIP ZONING
PERMIT NO. 4632
ZONING INSPECTOR

Typical Leaching Trench
Cross Section

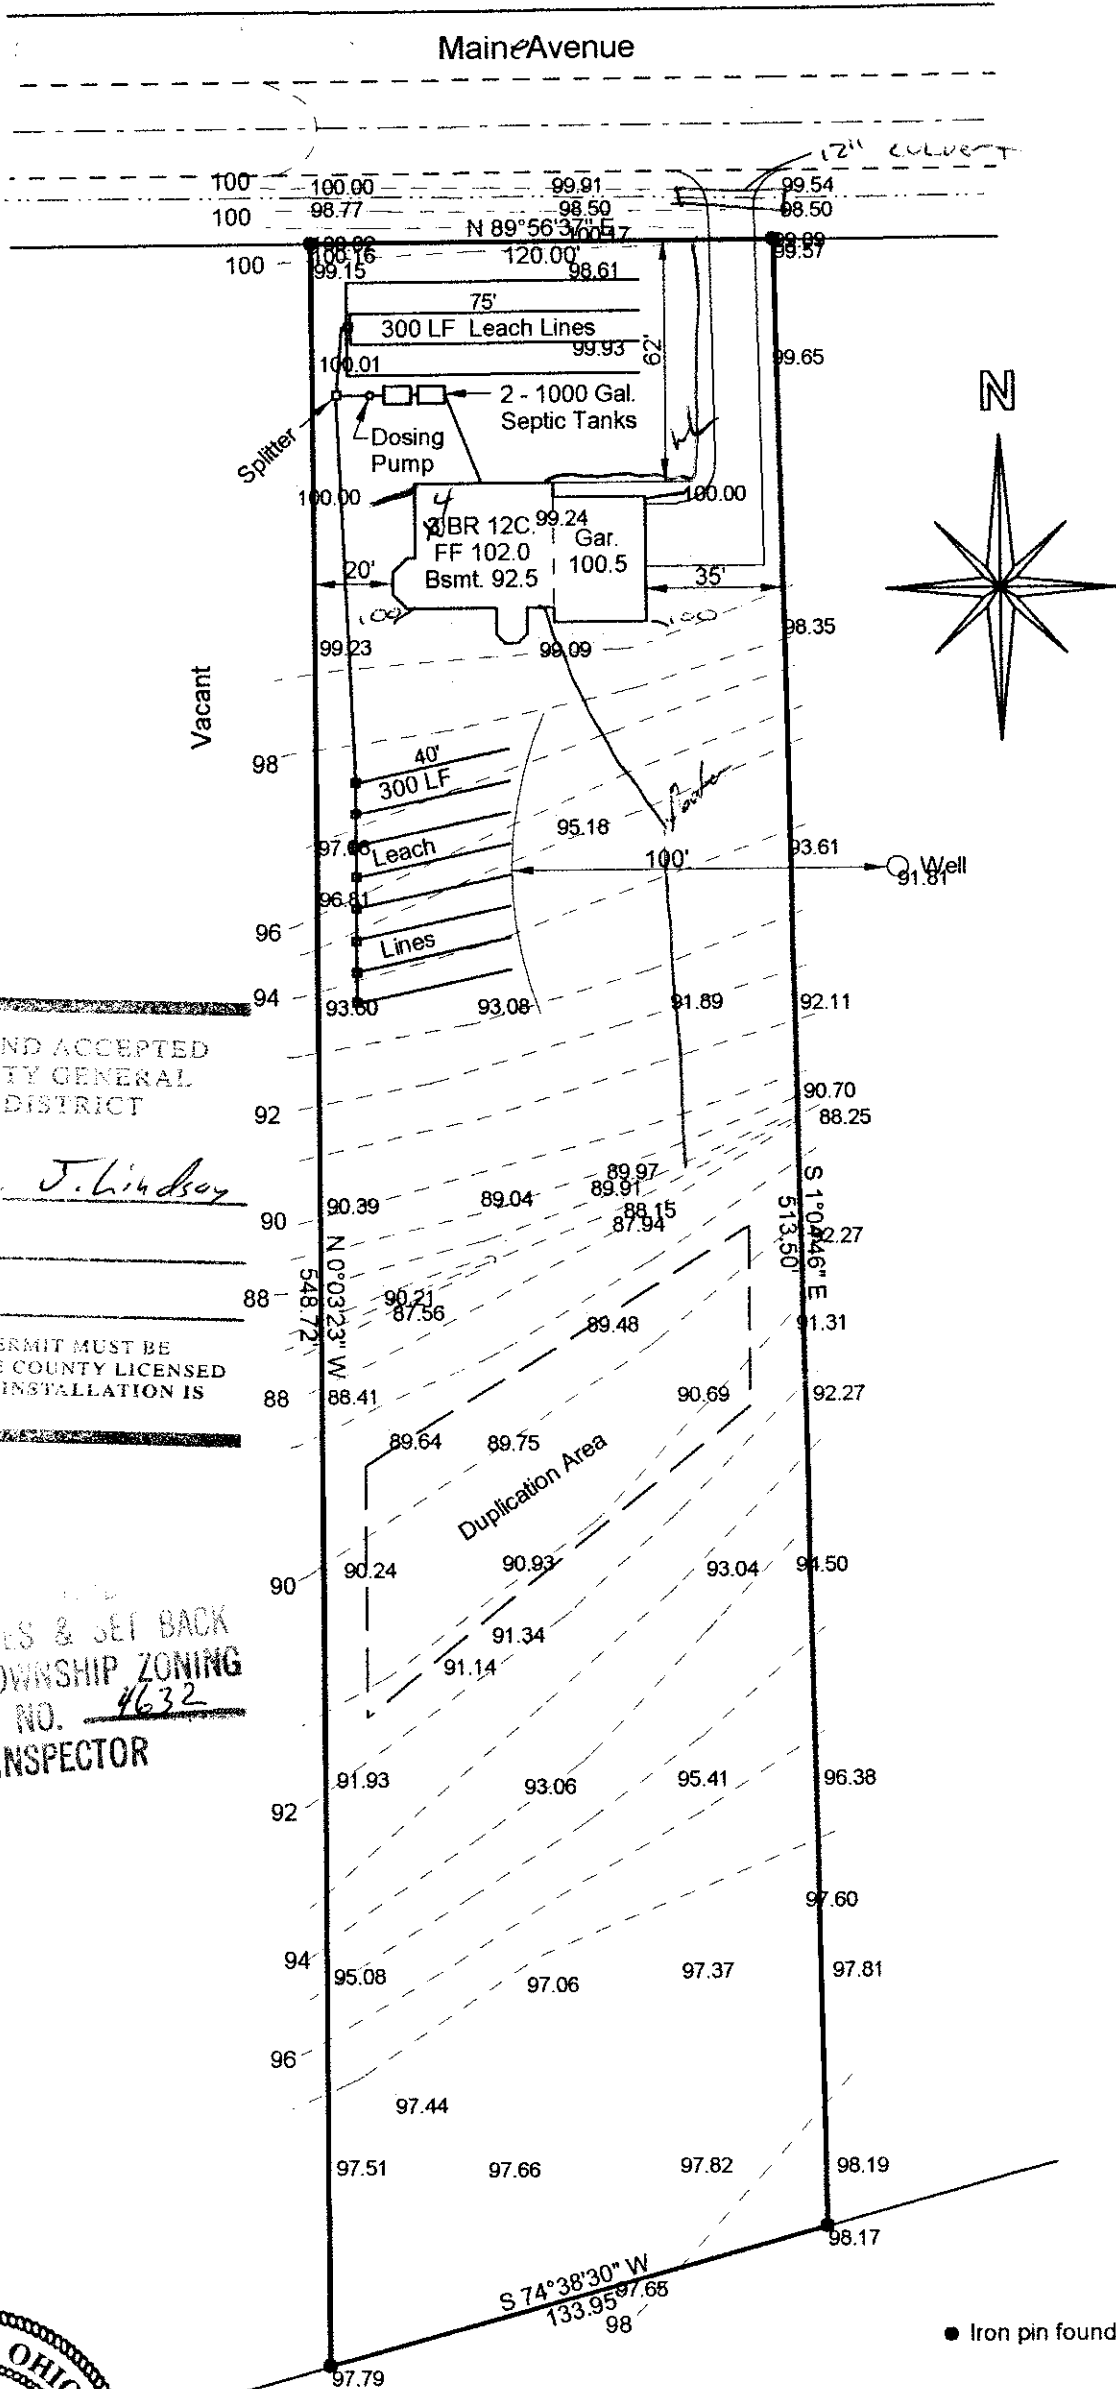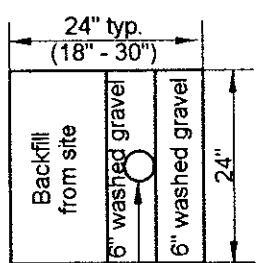

Grading Plan Approved
as shown and/or noted
THOMAS P. GILES, P.E.
Lake County Engineer

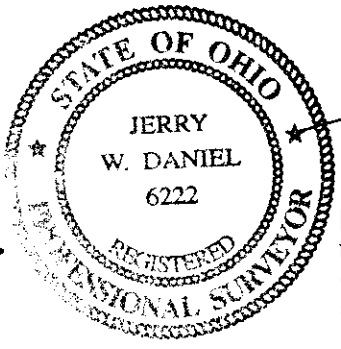


I, the undersigned hereby certify that the topography shown hereon, indicated by one foot contours and elevations represents an actual field topographic survey made by me on the 4th day of March, 1997 and that the elevations were taken at appropriate intervals and that as of that date they existed as indicated hereon.

Jerry W. Daniel
Jerry W. Daniel, P.S. #6222

Plot Plan
for
United Custom Homes
Owner: D. and K. Kahoun
Lot 49 Perry Township
Lake County, Ohio

J W Daniel & Associates, Inc.
101 North Center Street
Newton Falls, Ohio 44444
February, 1997 Job No. 9760

Graphic Scale

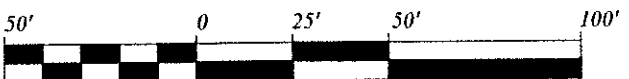

ROOF DRAINS
SHALL DISCHARGE
TO SPLASH BLOCKS.