



SCALE: 1" = 20'

BEARINGS SHOWN HEREON ARE TO AN ASSUMED MERIDIAN AND ARE USED TO DEFINE ANGLES ONLY

SITE PLAN


— FOR —

JOE KOWSLOWSKI

KNOWN AS BEING A PART OF LOTS 48 & 49, AND BEING SUBLOT NO. 2 IN THE OAKBROOK VILLAGE SUBDIVISION (RECORDED 1-29-80, VOLUME 2, PG. 121) AND SITUATED IN THE TOWNSHIP OF PERRY, COUNTY OF LAKE, AND STATE OF OHIO.

Rich Chapman

Plan Approved
own and/or noted
AS P. GILLES, P.E.
County Engineer
Date *4/13/88*

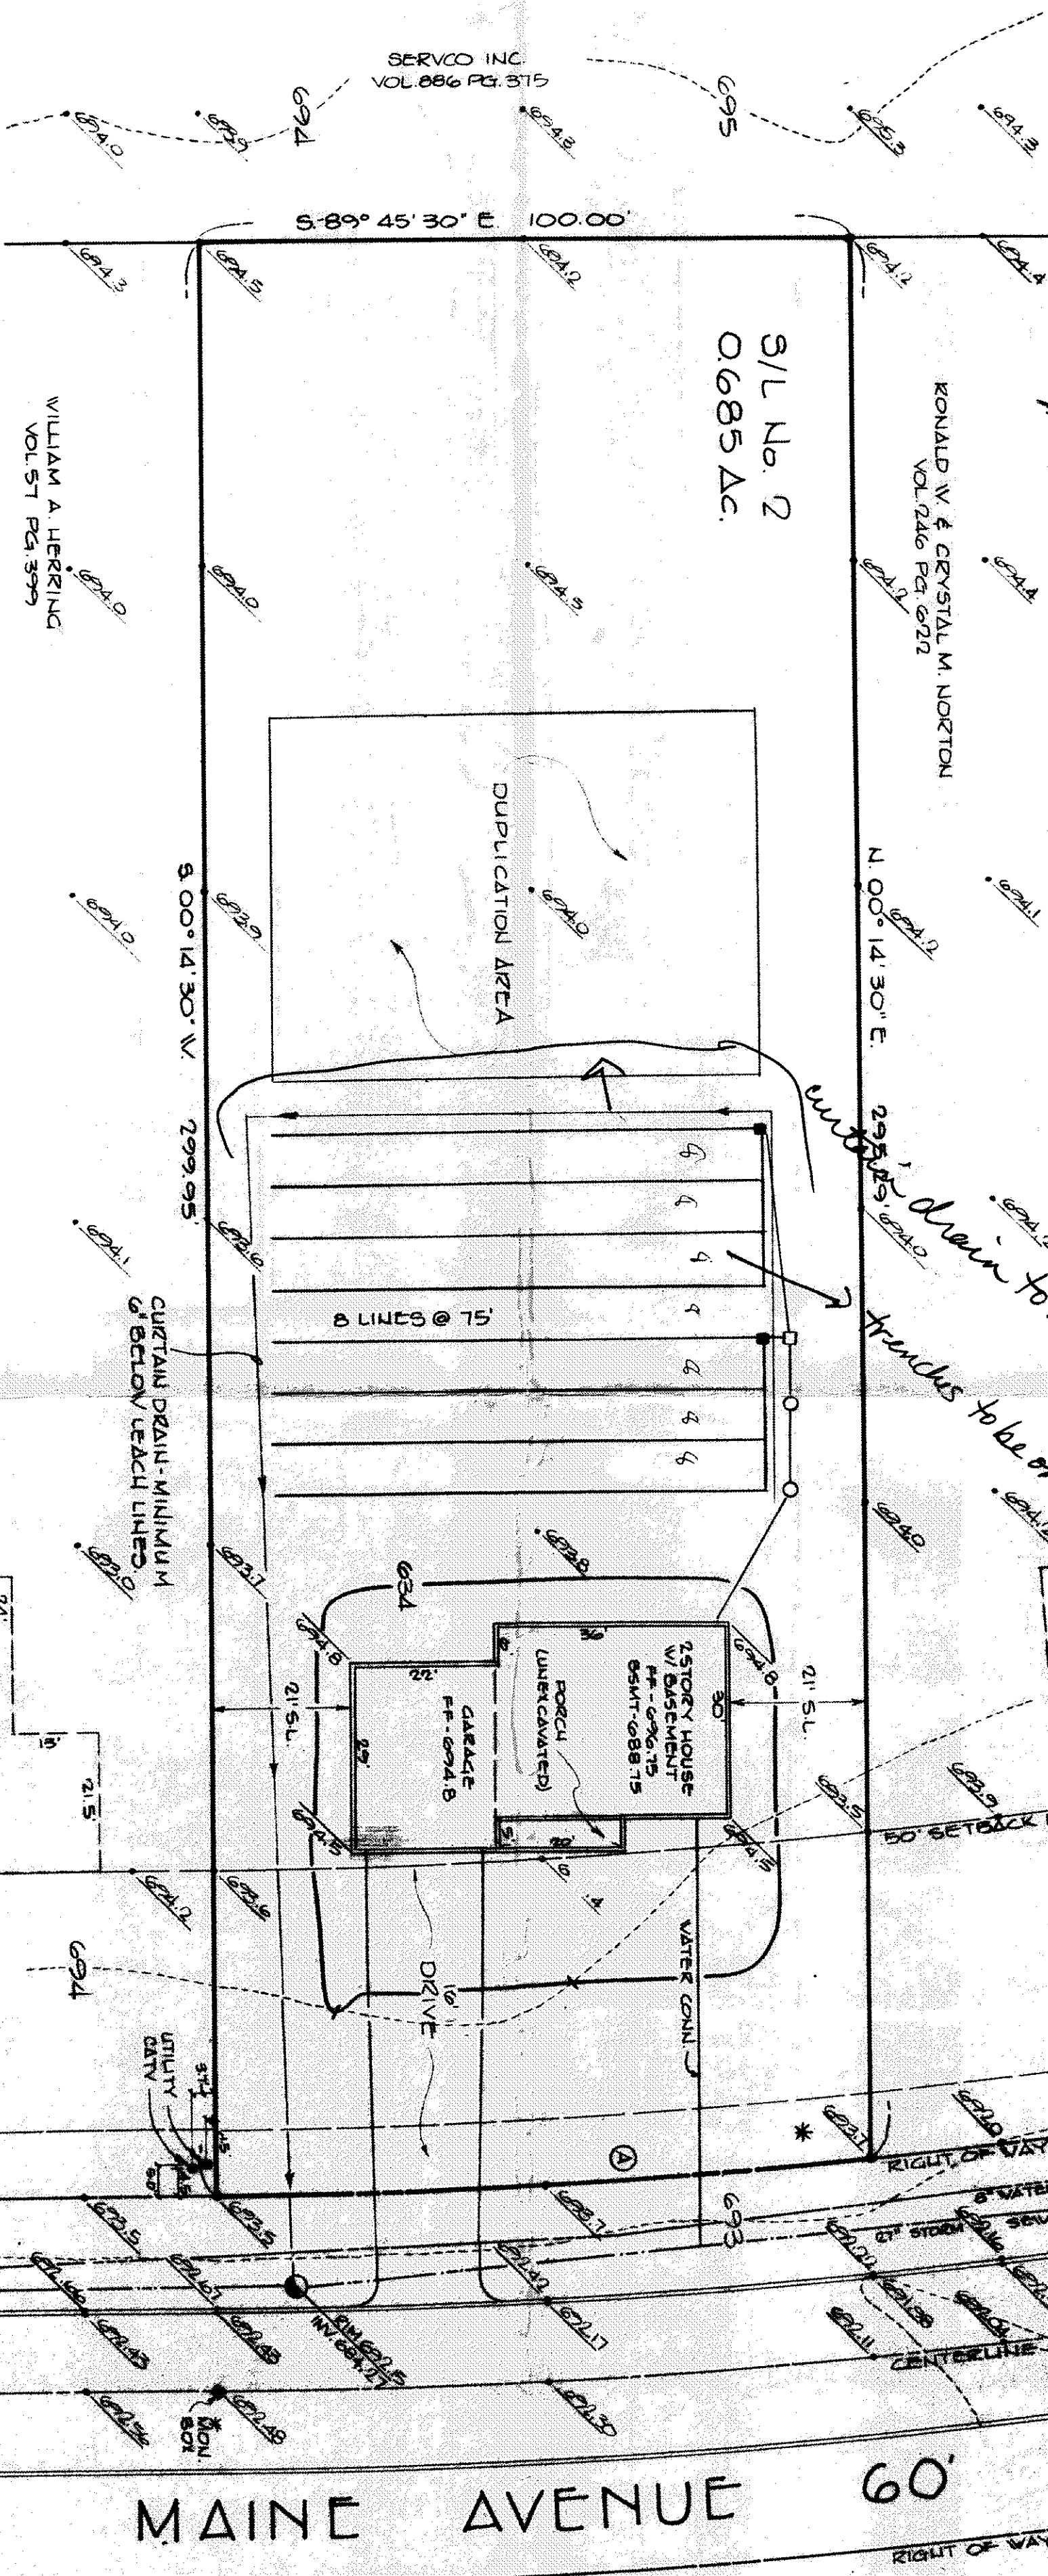

CURVE DATA

RADIUS.....	1074.84
ARC.....	60.00
DELTA.....	03° 11' 54"
TANGENT.....	30.01
CHORD.....	60.00
CURVING.....	576° 32' 12" V

VILLAGE SURVEYING CO.
THOMAS M. COFFMAN, P.S.
202 THIRD STREET, FAIRPORT HARBOR, OH. 44077
(216) 357-1359

HYDRAULIC PROFILE

SCALE: 1/4" = 1'-0" VERT.
1/4" = 10'-0" HORIZ.

FIXTURES REQUIRED
ON ALL:

Shower Head
Toilet

- 1000 GAL. TANK INV. 695.74
- 1000 GAL. TANK INV. 695.00
- SPLUTTER BOX F/L 692.60
- DIST. BOX F/L 692.10


- To be brought to finished grade
 - Septic tank manhole
 - Splitter box cover
 - Distribution box cover
- B. No footer drains or downspouts to be discharged into septic tanks
- C. All waste water to be discharged into

Reviewed and Accepted

LAKE COUNTY GENERAL HEALTH DISTRICT
Date *4-13-88*

JOEL LUDIA, R.S., M.P.H.
Health Commissioner

BY *Thomas M. Coffman*

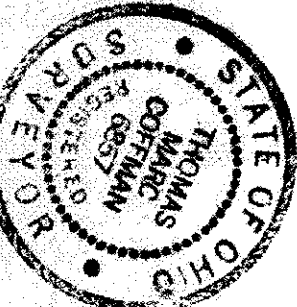

APPROVED
SIDE LINES & SET BACK
PERRY TOWNSHIP ZONING
PERMIT NO. *1112*
ZONING INSPECTOR *John*

THIS PLAN WAS PREPARED BY ME AND IS TRUE AND ACCURATE TO THE BEST OF MY KNOWLEDGE AND BELIEF.

Thomas M. Coffman
THOMAS M. COFFMAN, P.S.
No. 6857

* BENCHMARK - 692.48
CENTER MONUMENT BOX