

SITE PLAN

FOR



BOB & BETH PERUSEK

BEING A PART OF LOT No. 4, TRACT No. 4, IN THE TOWNSHIP OF
MADISON, COUNTY OF LAKE STATE OF OHIO

*NOTE: BEARINGS PER RECORD DEED
& MONUMENTATION FOUND

9:30 AM

EXIST DUG WELL

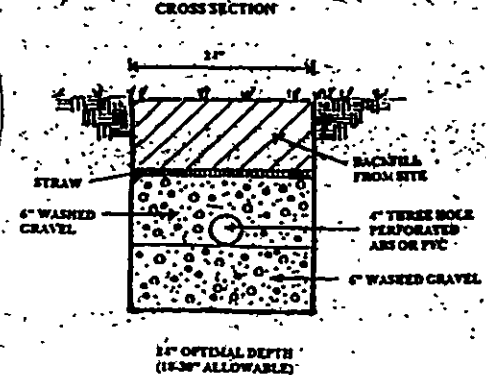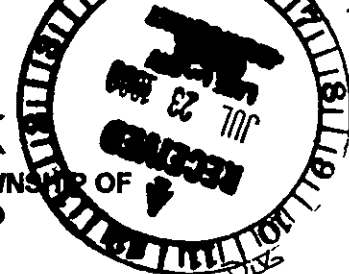

FF-103.5
GRINDER PUMP
READ IF PUMPING
IN BSMENT
BSMT-94.83

Grading Plan Approved
as shown and/or
THOMAS P. GILLESPIE
Lake County Engineer

SCALE: 1"=30'



BENCHMARK - 100.00 (ASSUMED)
NAIL IN PIONEER POLE

ROAD 50'

FRANK PANZANI
980024762 (ALL 3 PARCELS)

GRAVEL D/W

FF HSE. 101.93

FF GAR. 99.83

HYDRAULIC PROFILE
4 BEDROOM HOME
VERT - 1"=5' HORIZ - 1"=30'

S87°10'00"E 412.28'

REVIEWED AND ACCEPTED
LAKE COUNTY GENERAL
HEALTH DISTRICT

8-4-99
[Signature]

SEWAGE DISPOSAL PERMIT MUST BE
OBTAINED BY A LAKE COUNTY LICENSED AC.
INSTALLER BEFORE INSTALLATION IS
STARTED.

N87°10'00"W 412.21'

J + M MEINDL
98/031522


CALL
when
STAMPED

BILL -
FADP BLOC,
429-1112

VILLAGE SURVEYING CO.
P.O. BOX 1096, FAIRPORT HARBOR, OHIO 44077
(419) 357-1359

APPROVED
MADISON TOWNSHIP ZONING
DATE 7/20/99
BY 163/4 JAL

I, the undersigned hereby certify that
this topography, indicated by 1' contours
and elevations shown hereon represent an
actual field survey made by me on July 15, 1999
and that the elevations were taken at
appropriate intervals and that as of that
date they existed as indicated hereon.

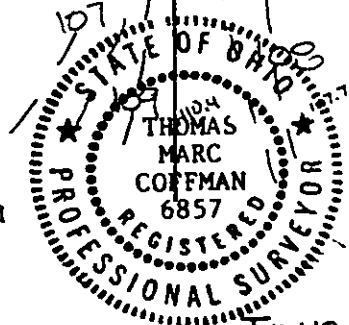

[Signature]