

SCALE: 1" = 20'

SITE PLAN

— FOR —

DOMINIC & WANDA DAVIRO

KNOWN AS BEING SUBJECT NO. 11 IN SECOR'S SUBDIVISION LOT NO. 81, AND SITUATED IN THE TOWNSHIP OF PERRY, COUNTY OF LAKE AND STATE OF OHIO.


Z.P.# 4151

Grading Plan Approved as shown and/or noted THOMAS P. GILLES, P.E. Lake County Engineer

By *Thomas P. Gilles* Date *9/5/88*


NOTE: ALL BEARINGS SHOWN HEREON ARE TO AN ASSUMED MERIDIAN AND ARE USED TO DENOTE ANGLES ONLY.

BENCHMARK - 698.96' TOP BOLT ON HYDRANT (ELEV. DEVELOPED FROM LAKE CO. TOPO MAP)

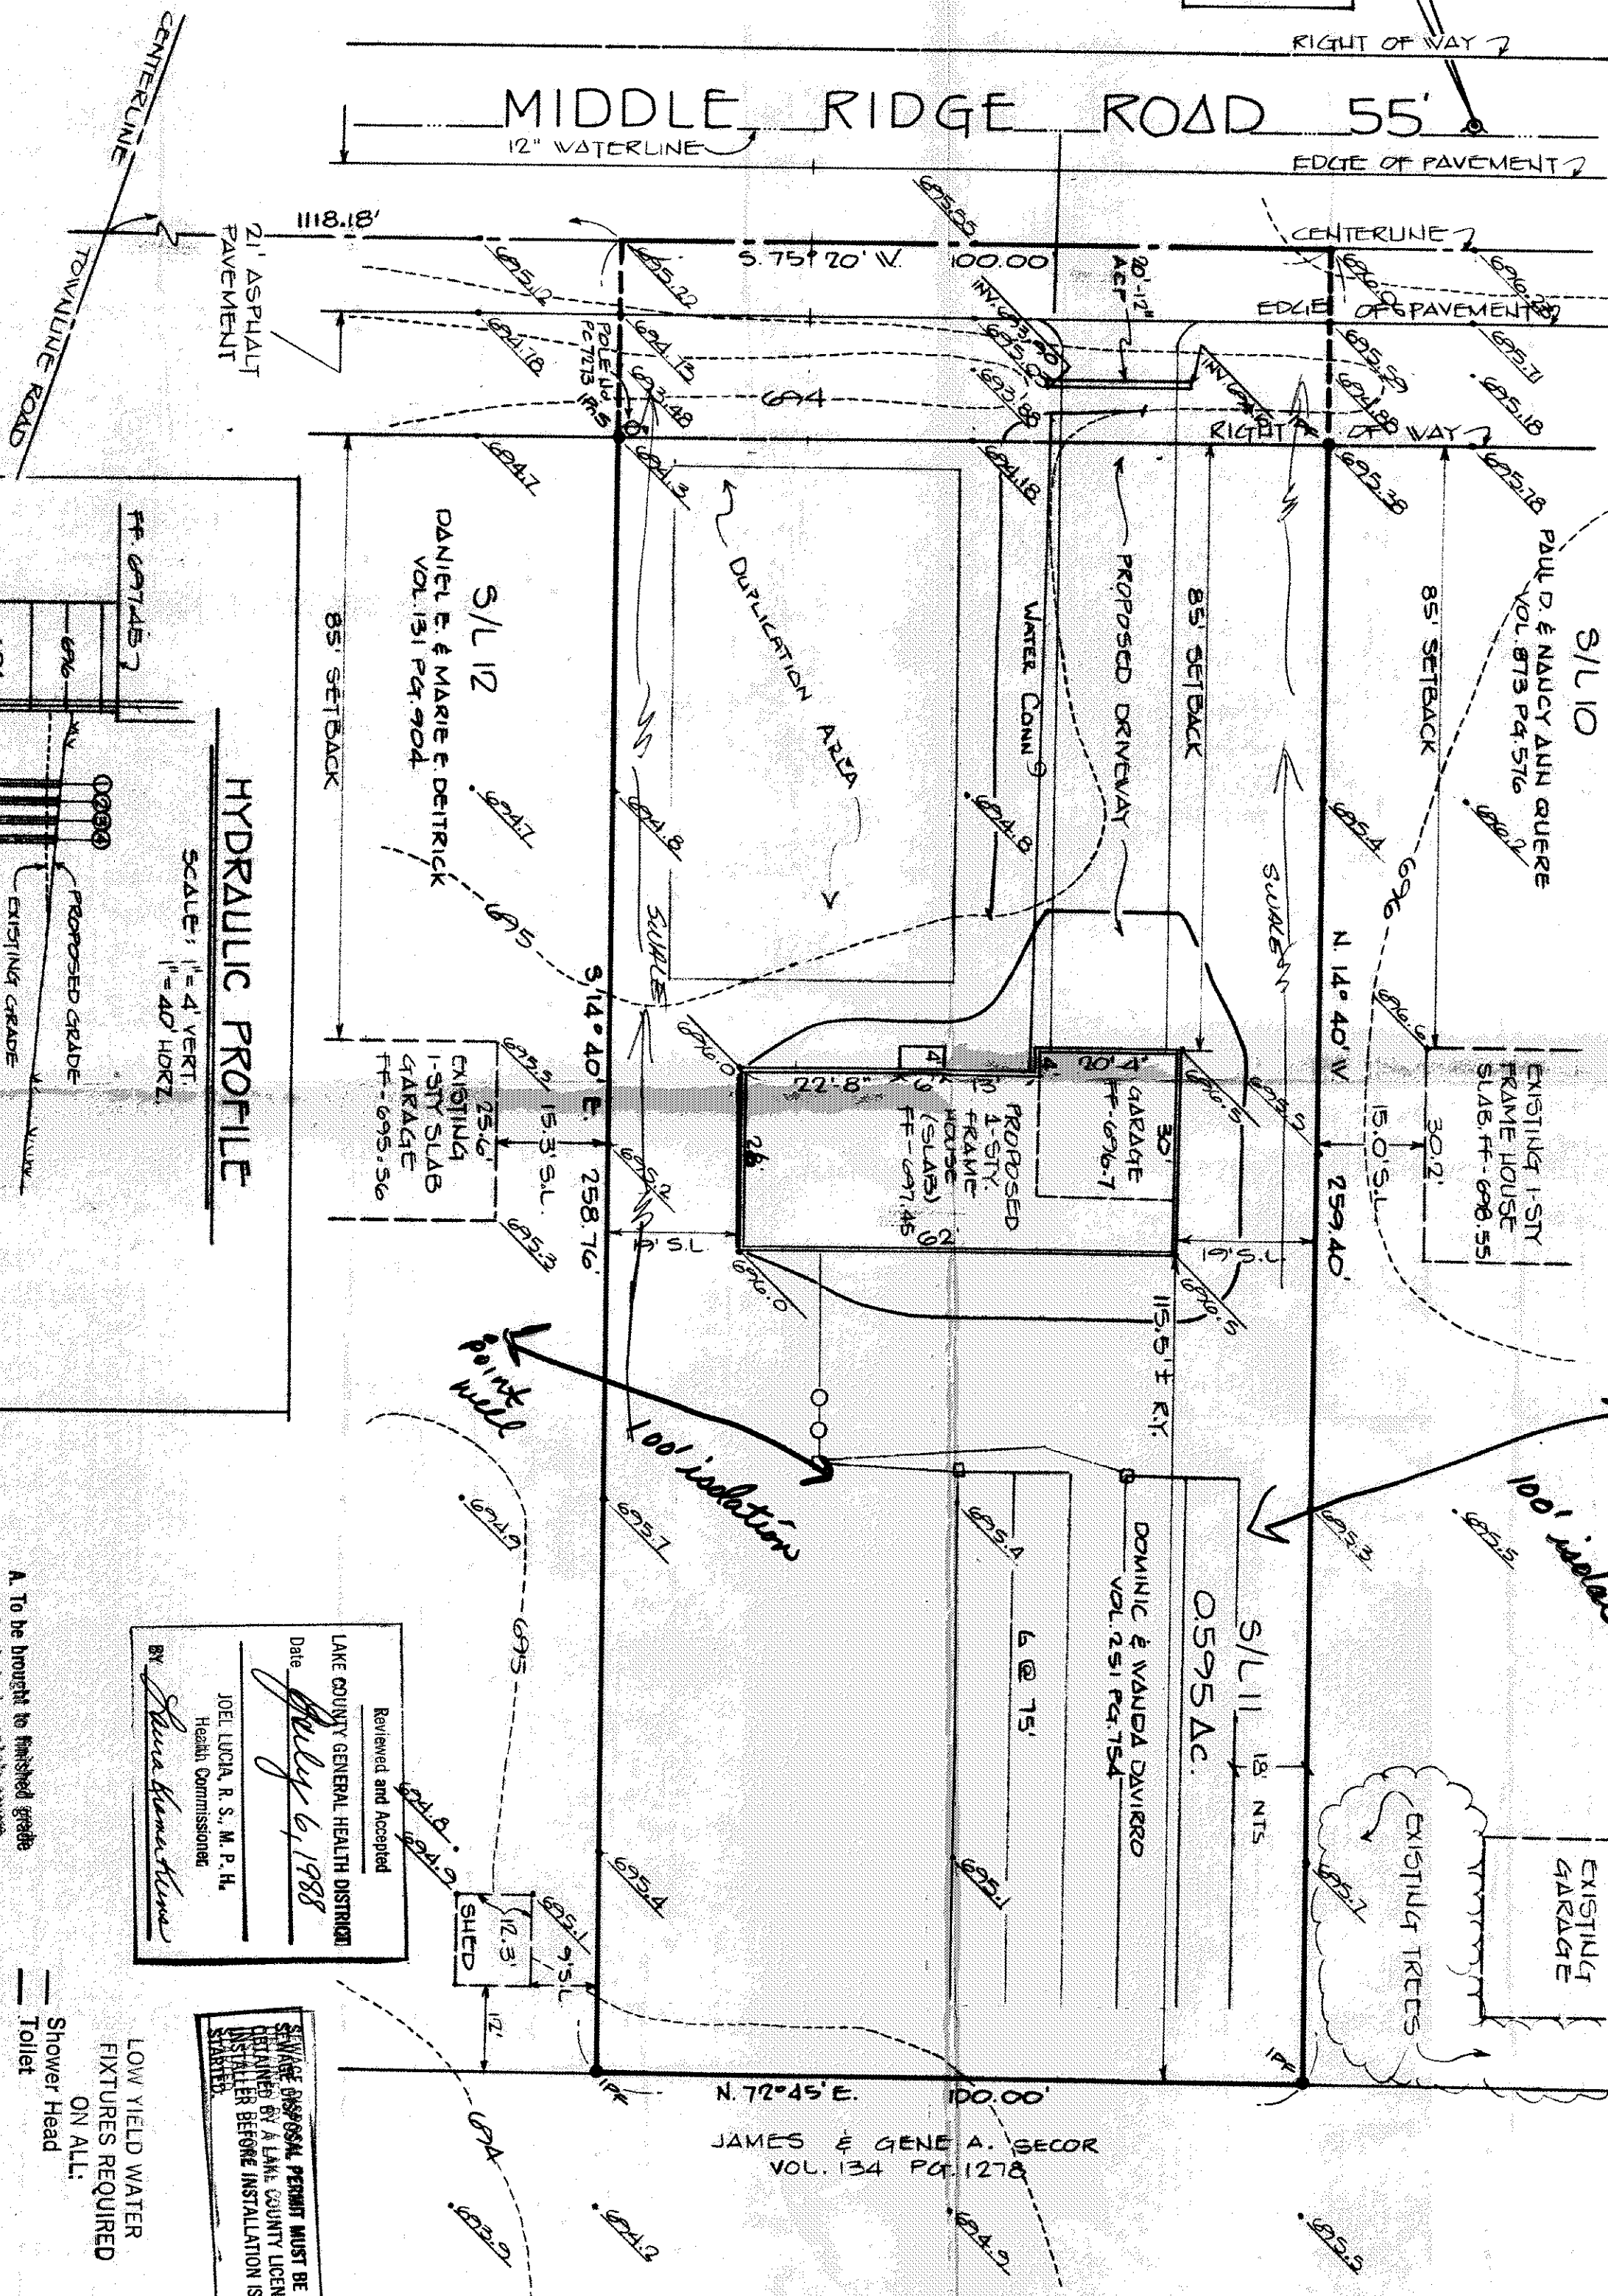


HYDRAULIC PROFILE

SCALE: 1" = 4' VERT. 1" = 40' HORIZ.

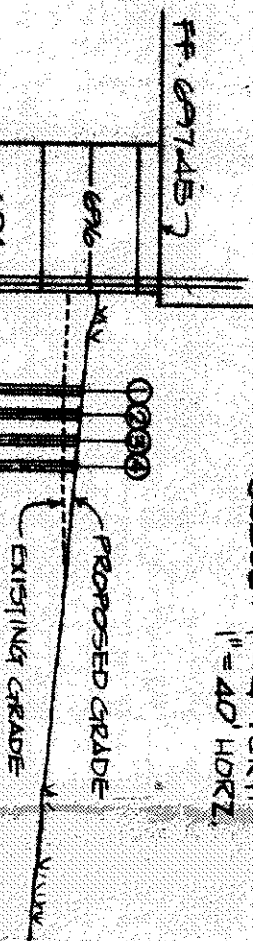

Reviewed and Accepted
LANE COUNTY GENERAL HEALTH DISTRICT
Date *July 6, 1988*
JOEL LUCIA, R.S., M.P.H.
Health Commissioner
By *Thomas P. Gilles*

SEWERAGE PERMIT MUST BE OBTAINED BY A LAKE COUNTY LICENSED INSTALLER BEFORE INSTALLATION IS STARTED.

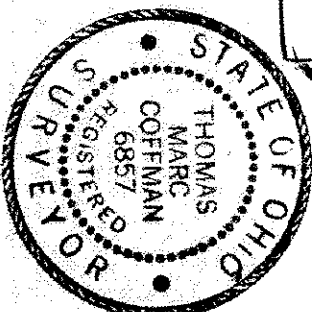

LOW YIELD WATER FIXTURES REQUIRED ON ALL: Shower Head Toilet

- A. To be brought to finished grade
1. Septic tank manhole covers
2. Splitter box cover
3. Distribution box cover
B. No footer drains or downspouts to be discharged into septic tanks
C. All waste water to be discharged into septic tanks

THIS PLAN WAS PREPARED BY ME AND IS TRUE AND ACCURATE TO THE BEST OF MY KNOWLEDGE AND BELIEF.

VILLAGE SURVEYING CO.
THOMAS M. COFFMAN, P.S.
202 THIRD STREET, FAIRPORT HARBOR, OH. 44077
(216) 357-1359