


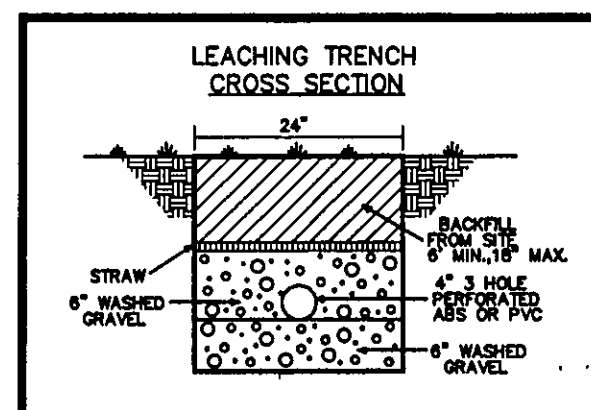

VIEWED AND ACCEPTED
THE COUNTY OF ...
... 19...

4-3-01
Dated: 4-3-01 By: Linda B. Morris

SEWAGE DISPOSAL PERMIT MUST BE
OBTAINED BY A LAKE COUNTY LICENSED
INSTALLER BEFORE INSTALLATION IS
STARTED

Grading Plan Approved
as shown and/or noted
JAMES R. GILLS, P.E.
Lake County Engineer

MILE TANK Date 5-1-01
Swale as shown

ROOF DRAINS
SHALL DISCHARGE
TO SPLASH BLOCKS.

PROV. ES & S. J. WINSHIP NO. _____
APPROVED SIDE LINES & SET BACK PERRY TOWNSHIP ZONING PERMIT NO. 7077
ZONING INSPECTOR

APPROVED
E LINES & SET BACK
RY TOWNSHIP ZONING
MIT NO. 7077
ONING INSPECTOR

SOUTH RIDGE ROAD - 60'

MILE TANK Date 5-1-01
Swale as shown

ROOF DRAINS
SHALL DISCHARGE
TO SPLASH BLOCKS.

TROPHY WORLD INC
V.797-PG.949
3A-42A-22

TOTAL ACREAGE
0.4553 AC.

S/L 19
(102.5' BY)

S/L 18
JOSEPH SUTCH
V.875-PG.675
3A-42A-18

NOTE: TEMPORARY SEEDING REQUIRED
IN DISTURBED AREAS.

PERRY TOWNSHIP.LAKE COUNTY, OHIO

for: RANDY MERKOSKY

701. RANDY MERRICK CLIENT OWNER

ADDRESS	STREET	CITY	ZIP
---------	--------	------	-----

HOWARD FRYE ALLOTMENT

SUBDIVISION		NAME		TRACT	SECTION
K-66				35	15

LOT 35-43 STREET

19.20.21 VOL-FC MILFORD DR. 101 101 101

SUBLOT NO.	STREET	VOL-PG.	PERM. PARCEL NO.

LEGEND

SANITARY MANHOLE ----- 
 STORM MANHOLE ----- 
 INLET OR CATCH BASIN ----- 
 HYDRANT ----- 
 EXISTING CONTOURS ----- 
 PROPOSED CONTOURS ----- 

DIST. ELEV. $\rightarrow$ 100.0 $\leftarrow$ PROP. ELEV.
 AS BUILT ELEVATION
 INDICATES
 DIRECTION OF
 SURFACE DRAINAGE 

REMARKS

ALL BOUNDARY DATA SHOWN WAS OBTAINED FROM (DEEDS, RECORDED
SUBDIVISION PLAT OR OTHER PUBLIC RECORDS)

LOCATIONS AS SHOWN OF ADJACENT WELLS AND SEPTIC TANKS OBTAINED FROM LAKE COUNTY HEALTH DEPARTMENT

DESIGN CERTIFICATION

THIS PLAT WAS PREPARED BY ME, AND IS CORRECT
TO THE BEST OF MY KNOWLEDGE AND BELIEF.

NAME Alley, Jr. SURVEYOR #6343 REGISTRATION NO. _____

CHECK LIST

NO. OF BEDROOMS	WATER MAIN SIZE, LOCATION
DIMENSIONS	SAN. SEWER SIZE & GR. LOC.
BEARINGS	SAN. MH. CAST. ELEV. INV. ELEV.
TIE TO NEAREST STREET	SAN. CONN. SIZE, LOC. DEPTH
SUBLOT NO. PARCEL NO.	STORM SEWER SIZE & GR. LOC.
SURROUNDING OWNERS	STORM MH. CAST ELEV. INV. ELEV.
BLDG. DIMENSIONS FIN GR.	PAV'T TYPE GRADE CURBS
BLDG. TIES FL-R. GRADES	GAS LINE LOC. SIZE PRESSURE
APRON TYPE WIDTH THICKNESS	SEPTIC TANK LOCATION & DUPLICATION AREA
SIDEWALK TYPE WIDTH THICKNESS	WELL LOCATION
CULVERT TYPE DIA. LENGTH	ISOLATION RADIUS FROM WELL
ROCK/CLAY TYPINGS	

REVISIONS			PLAN PREPARED BY:		
NO.	DATE	BY	 BABCOCK · JONES & ASSOCIATES, INC. PAINESVILLE, OHIO	SCALE	PHONE NO.
1	3/27/01	HJ		1" = 30'	440-357-181
2					
3				DRAWN BY T.R.	DRAWING NO.
4				CHK'D. H.J.	99-133
5				CHW CHET K.J.	
			APP'D H.J.		

"AS BUILT" CERTIFICATION
I, HEREBY CERTIFY THAT THE CIRCLED GRADES ARE EXISTING
FINISH GRADES CHECKED IN THE FIELD ON _____, 19____
AND ARE CORRECT TO THE BEST OF MY KNOWLEDGE AND BELIEF.

REGISTERED SURVEYOR _____ REG. NO. _____

TBM-TOP OF HYDRANT S/L 17
ELEV.=100.00

C1: R=213.73'
L=110.29'
T=56.40'
D=29°34'00"
C=109.07'
N13°17'00"W

"I, the undersigned hereby certify that this topography indicated by 6", 1' or 2' contours, and elevations shown hereon represent an actual field survey made by me on the 9th day of MARCH, 2001 and that the elevations were taken at appropriate intervals and that as of that date, they existed as indicated hereon."

Name Paul Jones #6343 Reg. No.

