

SITE AND GRADING PLAN

FOR RAY ZIRKLE
5865 SHORE DRIVE, PO Bx 25
MADISON, OH 44057
PH (216) 428-2058

BEING PARCEL NO 2 OF RESUBDIVISION OF S/Ls 1526.
THROUGH 1531 IN MADISON GOLF LAKELANDS
ALLOTMENT, VOLUME E, PAGE 83 OF LCMR
IN MADISON TOWNSHIP, LAKE COUNTY, OHIO

PPN 01B-112A-096
DEED 8980008850

DESIGN & SURVEYOR'S CERTIFICATION


I, the undersigned hereby certify that I have surveyed the plotted property shown hereon containing 0.2755 acres of land. Iron pin monuments were found or set at points indicated. All dimensions shown hereon are expressed in feet and decimal parts thereof. Bearings shown hereon are based upon an assumed meridian and are for the sole purpose of indicating the relative angle between lines.

I, the undersigned hereby certify that the topography shown hereon, indicated by one foot contours and elevations represents an actual field topographic survey made by me on the 14th day of July, 1998 and that the elevations were taken at appropriate intervals and that as of that date they existed as indicated hereon.

This Plat was prepared by me and is correct to the best of my knowledge and belief.

Surveyor's Signature: *Edward L. Debevec* Date: 2/11/99

Registration No: 4514

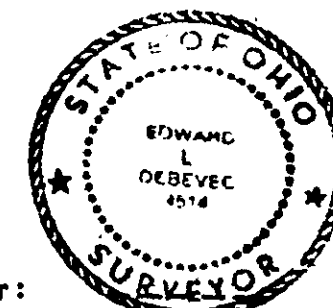

LEGEND

Existing Elevation:
Proposed Elevation:
As-Built Elevation:

Seal:

Existing Contour:
Proposed Contour:

Grading Plan Approved
as shown and/or noted
THOMAS P. GILLES, P.E.
Lake County Engineer


By: *Tom* Date: 2/22/99
LAWYER F.G. TO 108.5

APPROVED
MADISON TOWNSHIP ZONING
DATE: 2/17/99
BY: *Jim* 110074

DEBEVEC-SALO & ASSOCIATES, INC.
29483 SAYLE DRIVE
WILLOUGHBY HILLS, OHIO 44092
PH 944-2589

SCALE: 1"=30'
FEB 15, 1999

WO 6650B

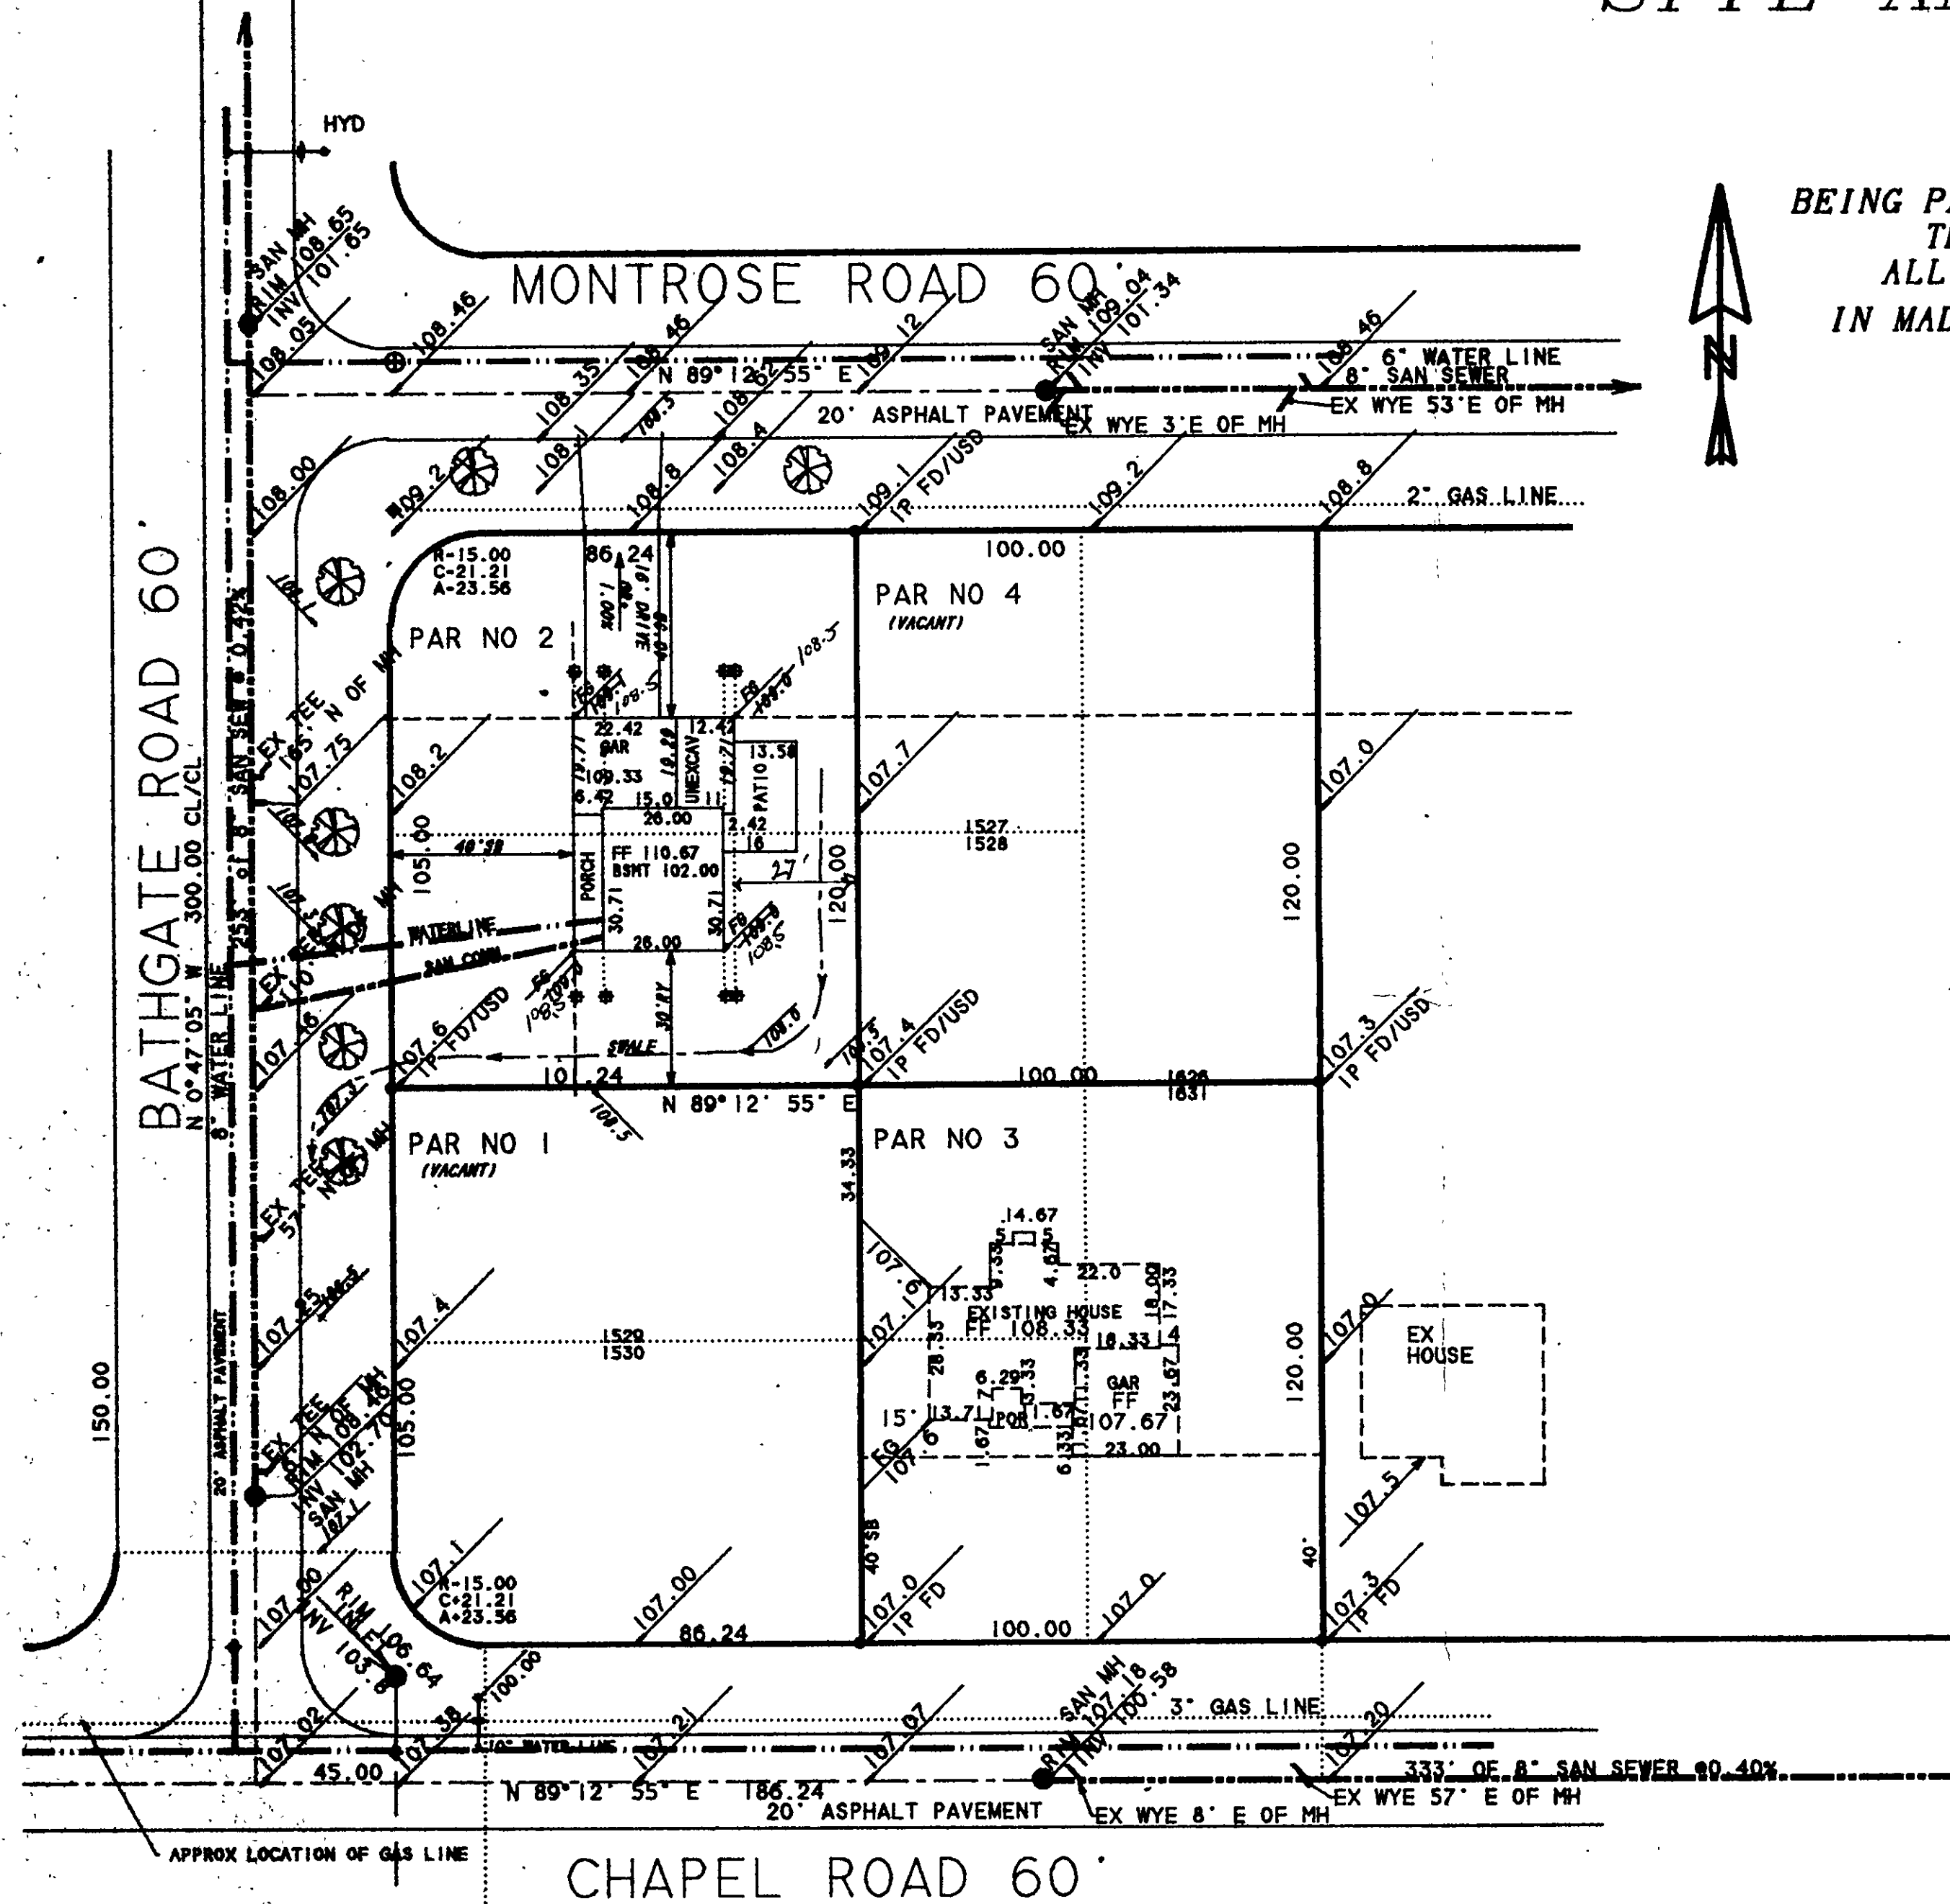

NOTE:
BEFORE EXCAVATION THE CONTRACTOR
IS RESPONSIBLE FOR NOTIFYING ALL
AFFECTED UTILITY COMPANIES OR THE
UTILITIES PROTECTION SERVICE
(PHONE 1-800-362-2764).

NOTES:
FOOTER DRAINS NOT REQUIRED BY BUILDING DEPARTMENT.
DOWNSPOUTS DISCHARGE INTO SPLASH BLOCKS.
NO STORM DRAINS TO BE PROVIDED.