



BILL STORKEL, ET AL
Vol. 1005-Pg. 216
13-94-4

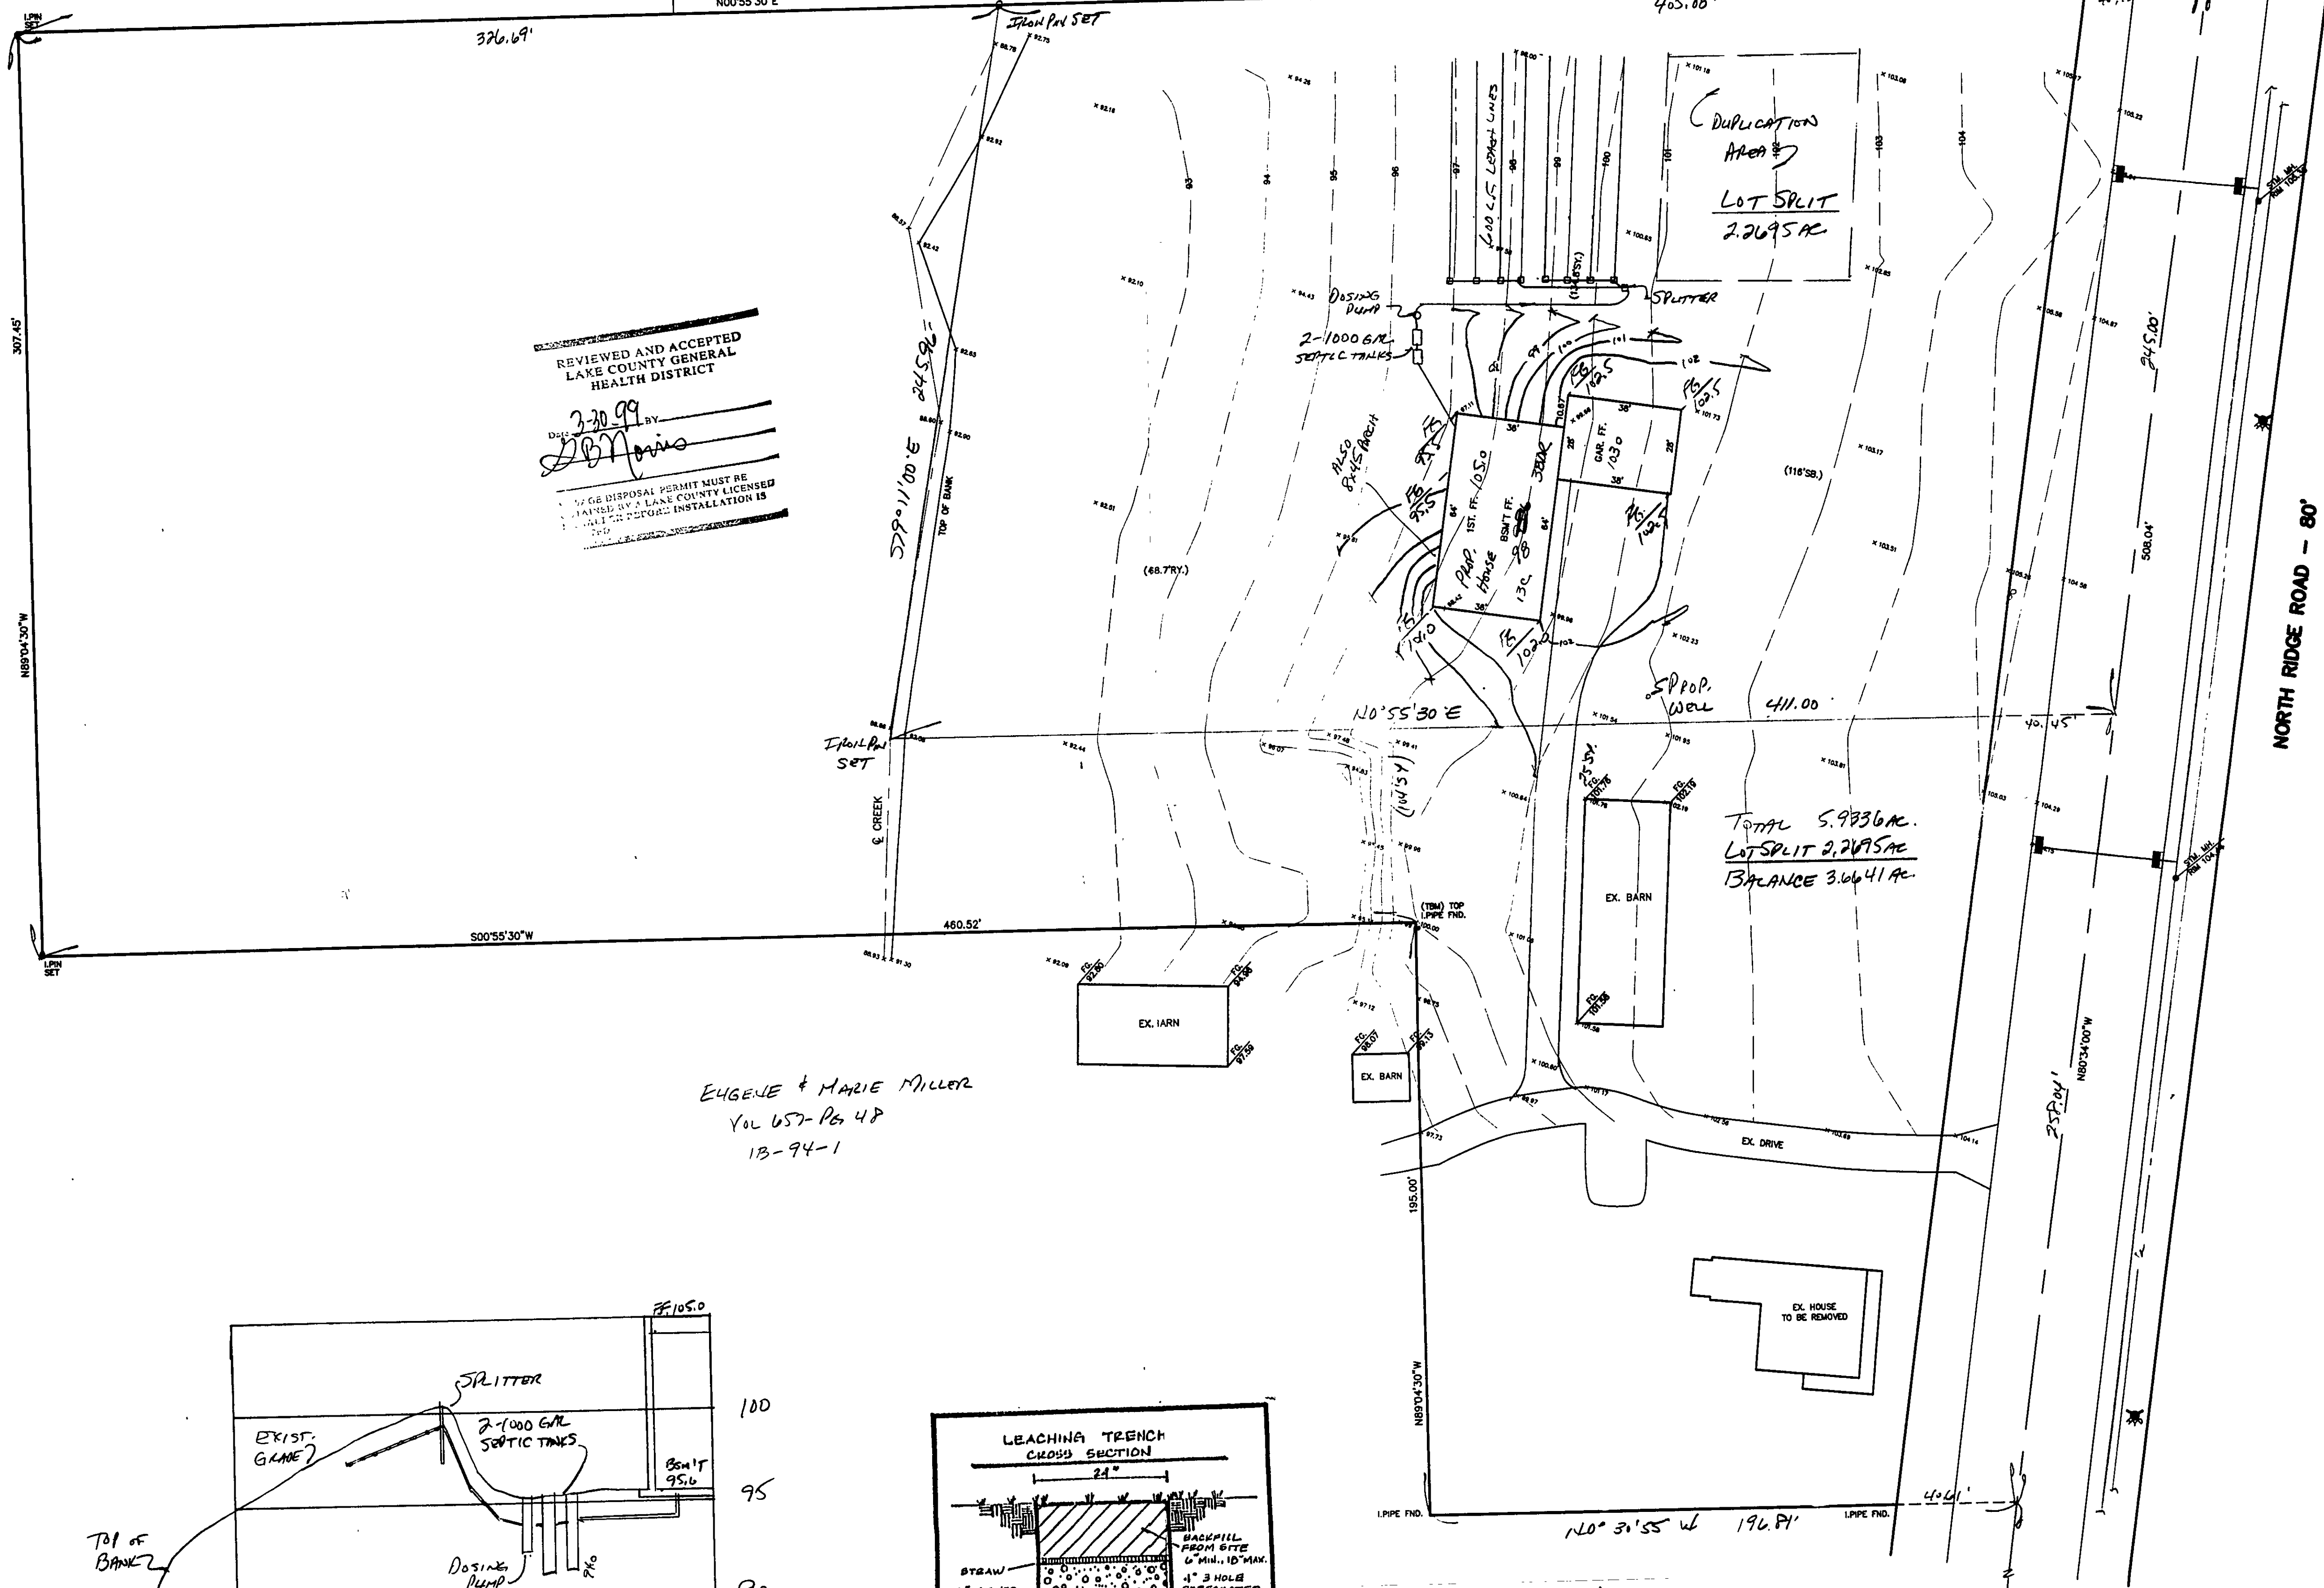


REVIEWED AND ACCEPTED
LAKE COUNTY GENERAL
HEALTH DISTRICT
2-20-99 BY
[Signature]
WASTE DISPOSAL PERMIT MUST BE
OBTAINED BY A LAKE COUNTY LICENSED
INSTALLER BEFORE INSTALLATION IS
BEGUN

EUGENE & MARIE MILLER
Vol. 657-Pg. 48
13-94-1

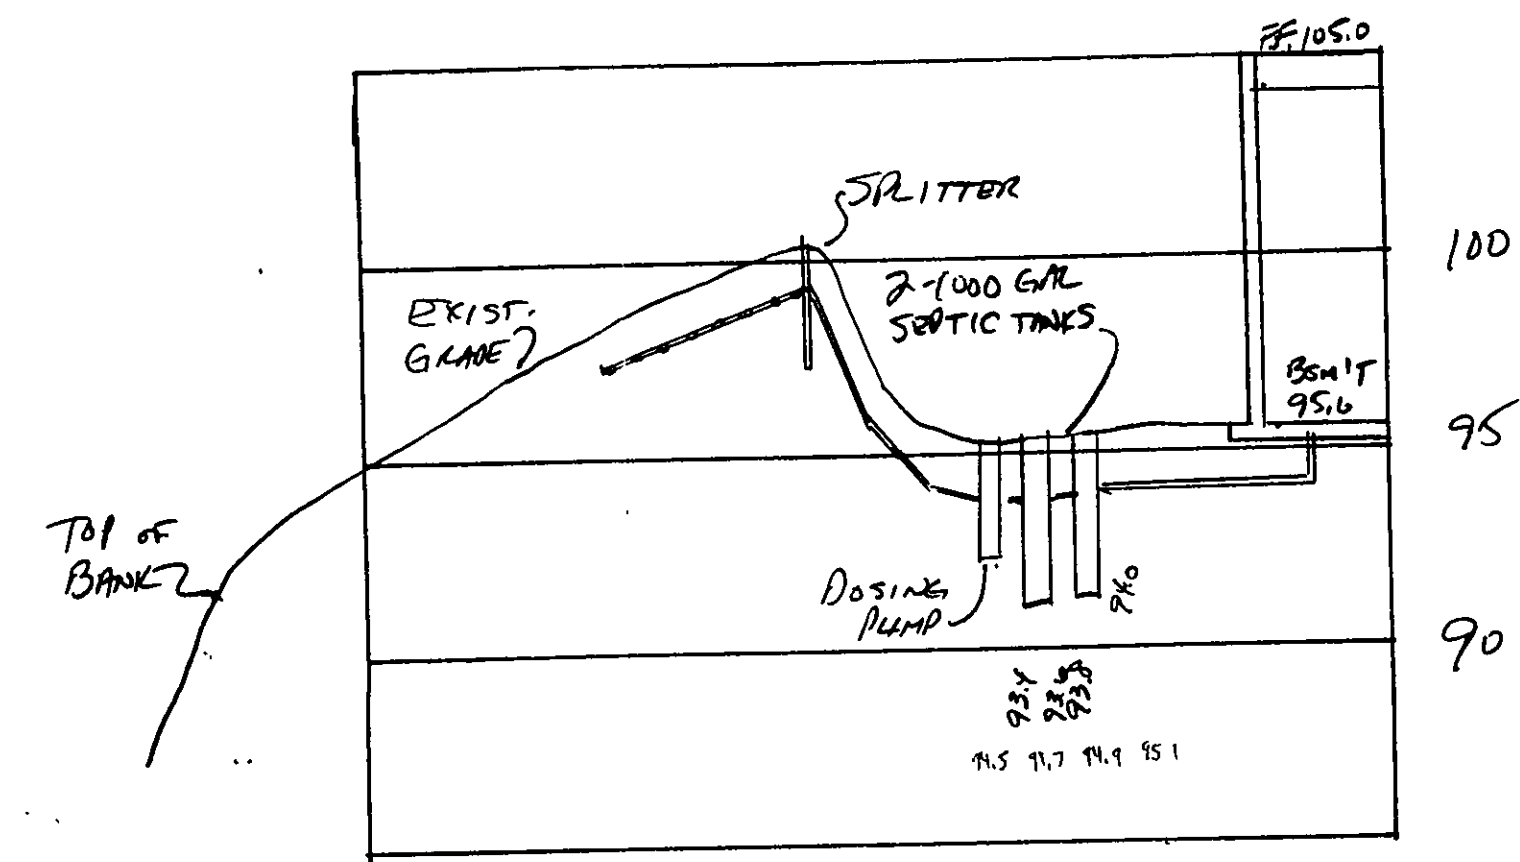


HYDRAULIC PROFILE
HORIZ. 1"=30' VERT. 1"=5'

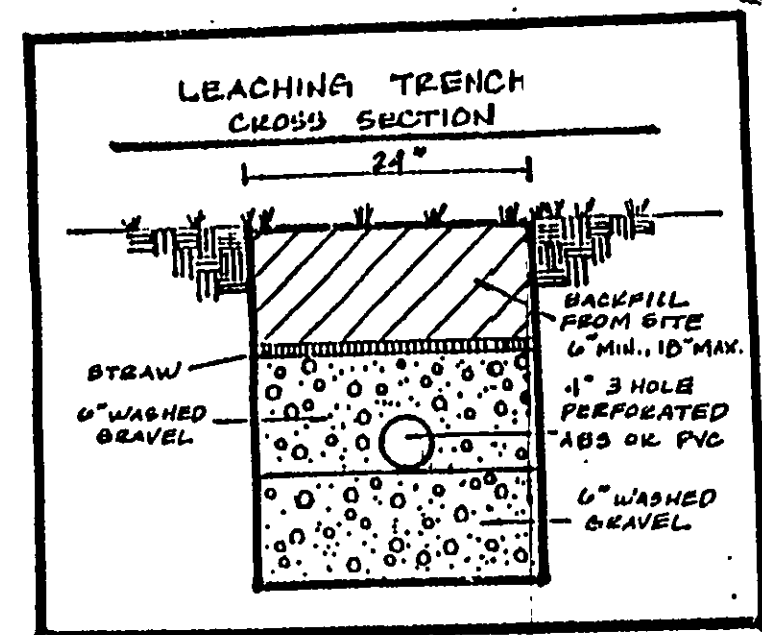

11982 GIRDLED ROAD • PAINESVILLE, OH 44077

"I, the undersigned hereby certify that this topographic map, showing contours, and elevations shown hereon, represent an actual field survey made by me on the 23rd day of June, 1998, and that the elevations were taken at appropriate intervals and that as of that date they existed as indicated hereon."

Name [Signature] Reg. No. 6343

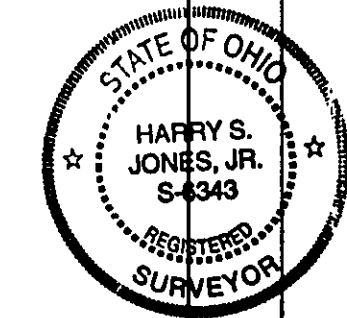

APPROVED
MADISON TOWNSHIP ZONING
DATE 4/6/99
BY UM 16127

REV. NO.	DESCRIPTION	DATE	BY	CHK'D
1	ADDED WELL	6-22-98	HT	HT
2	LOT SPLIT	12-21-98	HT	HT
3	REVISED SEPTIC	2-2-99	HT	HT

bj BABCOCK, JONES AND ASSOCIATES, INC.
CIVIL ENGINEERS - SURVEYORS - LAND PLANNERS
PAINESVILLE OHIO 44077

DATE 6/24/98
DESIGN BY H.J.
DRAWN BY T.R.
APPROVED BY H.J.

SITE PLAN
FOR
CEDARCRAFT LOG HOMES
CEDARCRAFT, INC.
11982 GIRDLED RD.
PAINESVILLE, OH 44077
(440) 384-8400
(440) 384-8188 FAX

SCALE 1"=30'
JOB NO. 98-187
SHEET 1 OF 1

TBM-TOP I.P.I.E
ELEV.=100.00