


Grading Plan Approved
as shown and/or noted
THOMAS P. GILLES, P.E.
Lake County Engineer

By: 7/8/79 Date: 6/11/79

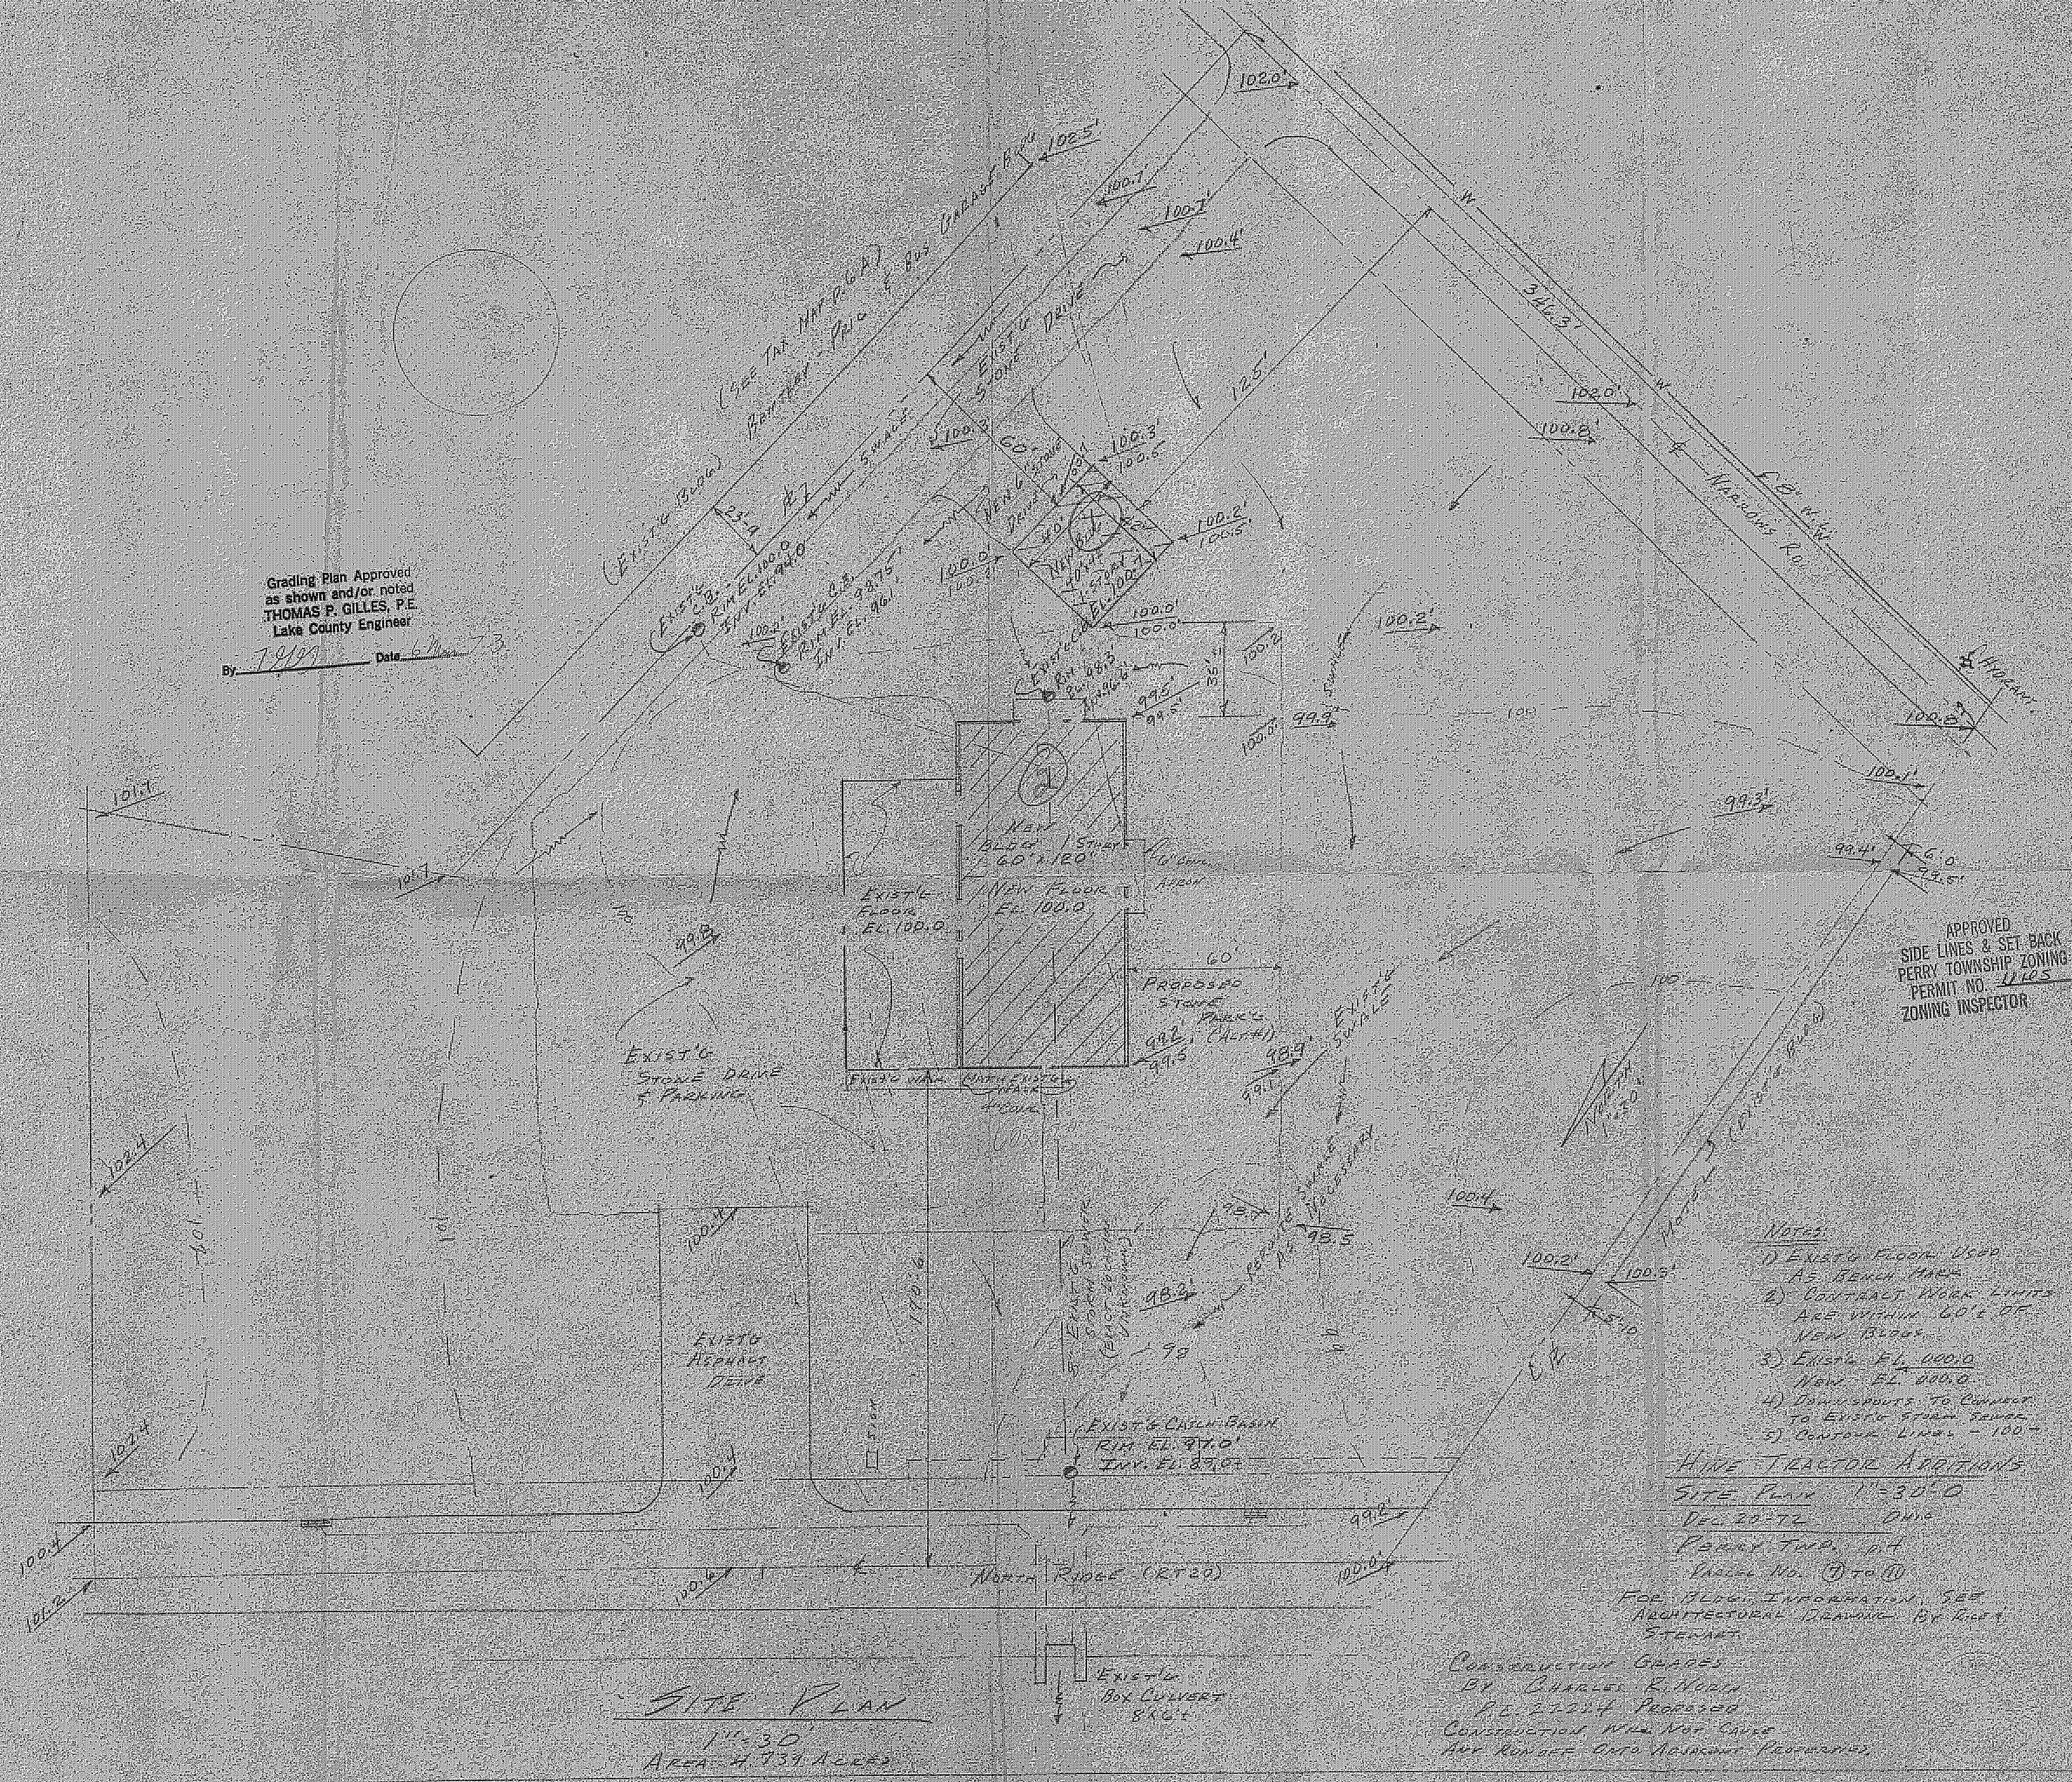

APPROVED
SIDE LINES & SET BACK
PERRY TOWNSHIP ZONING
PERMIT NO. 1165
ZONING INSPECTOR

- NOTES:
- 1) EXIST'G FLOOR USED AS BENCH MARK
 - 2) CONTRACT WORK LIMITS ARE WITHIN 60' OF NEW BLEND
 - 3) EXIST'G EL. 100.0 NEW EL. 100.0
 - 4) DRAINAGE TO CONNECT TO EXIST'G STORM SEWER
 - 5) CONTAIN LINES - 100'

HIVE TRACTOR ADDITIONS
SITE PLAN 1"=30' 0"
DEC 2007L DMC
PERRY TWP. 114
Parcel No. ⑦ to ⑩

FOR FLOOR INFORMATION SEE ARCHITECTURAL DRAWING BY GEO. STEWART

CONSTRUCTION GRADERS
BY CHARLES R. NORTH
P.E. 2224 PREFERRED
CONSTRUCTION WILL NOT CAUSE
ANY RUNOFF ONTO ADJACENT PROPERTIES

SITE PLAN
1"=30'
AREA - 1.30 ACRES