

SITE PLAN

Perry Township, Lake County, Ohio

for: STEVE JABORSKY

59 Hayes St. Painesville 44077

SUBDIVISION	NAME	VOL. NO.	SHEET
59	Hayes St.	100	100

LEGEND

SANITARY MANHOLE	○	WATER VALVE (GAS)	○
STORM MANHOLE	●	WATER METER (GAS)	○
INLET OR CATCH BASIN	□	AS BUILT ELEVATION	---
HYDRANT	⊕	INDICATES	---
EXISTING CONTOURS	---	DIRECTION OF	---
PROPOSED CONTOURS	---	SURFACE DRAINAGE	---
EXIST. ELEV.	---		
PROJ. ELEV.	---		

REMARKS

ALL BOUNDARY DATA SHOWN WAS OBTAINED FROM IDEAS, RECORDED SUBDIVISION PLAT OR OTHER PUBLIC RECORDS
LOCATIONS AS SHOWN OF ADJACENT WELLS AND SEPTIC TANKS OBTAINED FROM LAKE COUNTY HEALTH DEPARTMENT

DESIGN CERTIFICATION

THIS PLAN WAS PREPARED BY ME, AND IS CORRECT TO THE BEST OF MY KNOWLEDGE AND BELIEF.

NAME: *Thomas P. Gilles* REGISTRATION NO. 2907

CHECK LIST

NO. OF BEDROOMS	WATER MAIN SIZE, LOCATION
NO. OF BATHS	SAN. SEWER SIZE & OR. LOC.
NO. OF KITCHENS	SAN. IN. CAST. ELEV. INV. ELEV.
NO. OF LIVING ROOMS	SAN. IN. CAST. ELEV. INV. ELEV.
NO. OF DINING ROOMS	STORM SEWER SIZE & OR. LOC.
NO. OF PORCHES	STORM IN. CAST. ELEV. INV. ELEV.
NO. OF GARAGES	PAV'T TYPE GRADE CURVES
NO. OF DRIVEWAYS	PAV'T TYPE GRADE CURVES
NO. OF SIDEWALKS	SEPTIC TANK LOCATION & DUPLICATION AREA
NO. OF ROCK OUTCROPPINGS	WELL LOCATION
	ISOLATION RADIUS FROM WELL

PLAN PREPARED BY:

BABCOCK • JONES & ASSOCIATES, INC.
PAINESVILLE, OHIO


NO.	DATE	BY	SCALE	DATE	APPROVED
1	7-13-85	HR	1" = 20'	4/19/85	25-116
2					
3					
4					
5					

"AS BUILT" CERTIFICATION


I, HEREBY CERTIFY THAT THE CIRCLED GRADES ARE EXISTING FINISH GRADES CHECKED IN THE FIELD ON 19, AND ARE CORRECT TO THE BEST OF MY KNOWLEDGE AND BELIEF.

REGISTERED SURVEYOR

REG. NO.

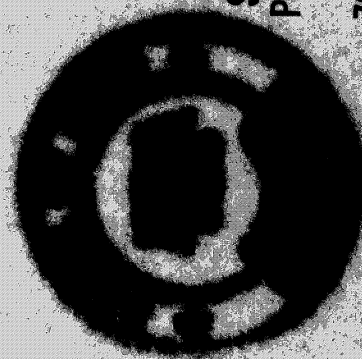

HYDRAULIC PROFILE 2897 NARROWS ROAD - 60'

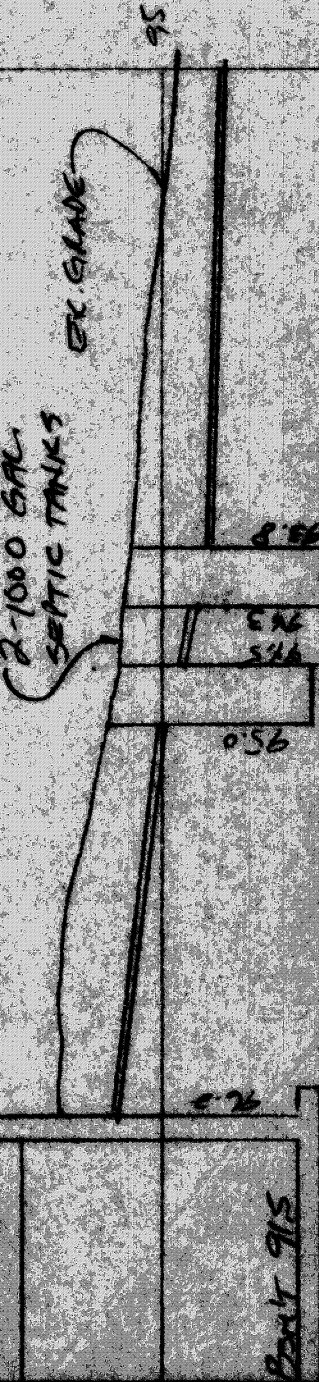

Grading Plan Approved as shown and/or noted
THOMAS P. GILLES, P.E.
Lake County Engineer

By: *THP* Date: 2-26-85

TBM - NAIL IN PP #525440
ELEV. = 100.00

APPROVED

SIDE LINES & SET BACK
PERRY TOWNSHIP ZONING

PERMIT NO. 2907

ZONING INSPECTOR

R. W. B. B. B.