


WHITE CEDAR PLACE 66'

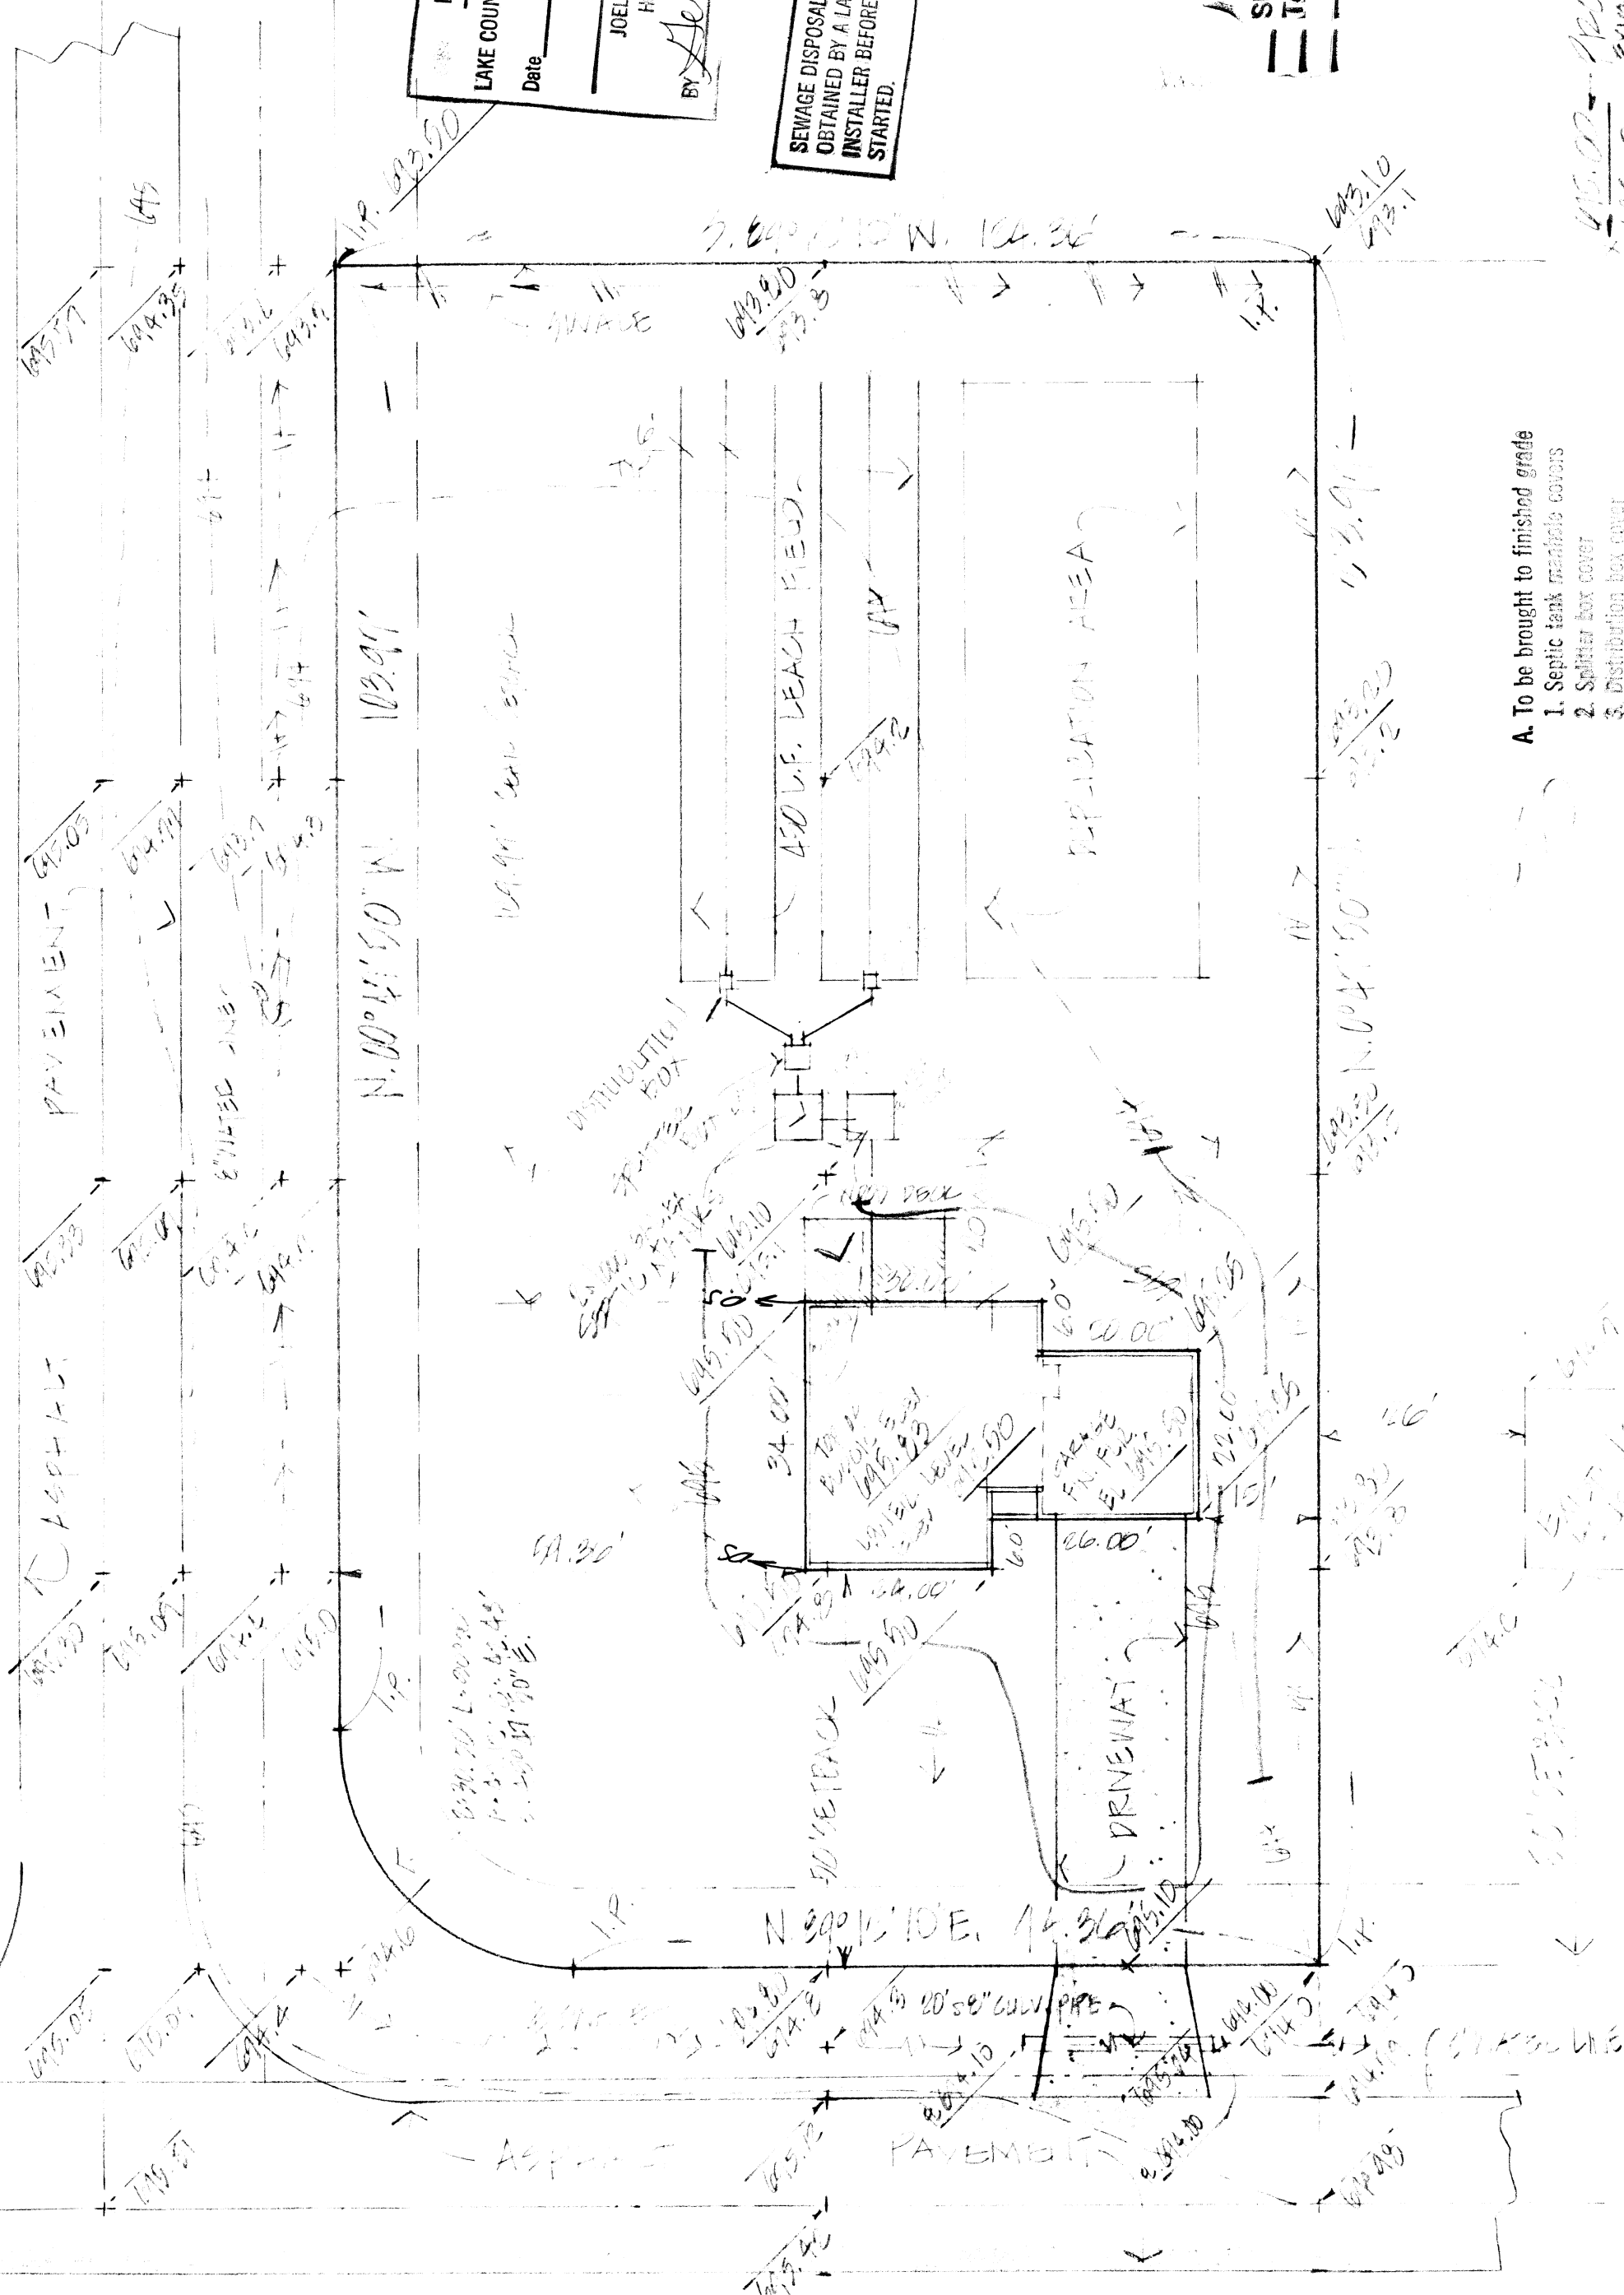

HARROWS ROAD 60'

A. To be brought to finished grade

1. Septic tank manhole covers
2. Splitter box cover
3. Distribution box cover
4. Vent pipes

**Grading Plan Approved
as shown and/or noted
THOMAS P. GILLES, P.E.
Lake County Engineer**

PERMIT NO. 7
ZONING INSPECTOR # 3019

DIRECT DOWN SPORTS TOWARD WHITE CEDAR HALL

WATER PLANT
I HAVE, SEED, FLOWERS
AND BARKS TO TASTE
AND

4/23 PATTEN
LIZ JONES
BIOGRAPHICAL SKETCHES
Vol. V Page 92

DATE 7/20/86
SCALE 1"=50'
DRAWN BY WZ
CHECK'D BY _____
E.B.# _____ PG. _____

COLPETZER · WOODS
CONSULTANTS, INC.

MENTOR, OHIO 44060

SHEET	1	OF	1
CONTRACT NO.		66-526	