


Grading Plan Approved
as shown and/or noted
THOMAS P. GILLES, P.E.
Lake County Engineer

By *TMP* Date *4-6-85*

0 30 60

SURVEY & SITE PLAN for

JIM REUSCHLING
Sublots 5, 6 & 7
MADISON AVENUE ESTATES
Part of Original Twp. Lots 20 & 30
PERRY TWP.
LAKE COUNTY
State of Ohio
March 1985 1"=30'

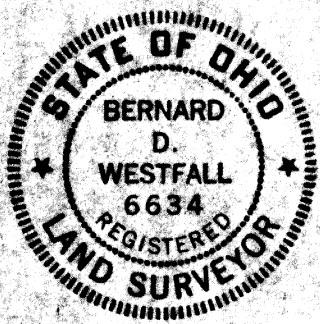

Bernard D. Westfall
Bernard D. Westfall P.S. 6634
A'TERRA SURVEY CO.
Jefferson, Ohio

NOTE: Basis for bearings—Madison Avenue Est. Plat
Reference—Madison Avenue Estates Plat Vol. K—Pg. 110

"As Built Certification"

I, hereby certify that the circled grades are existing finished
grades checked in field on _____, 19____ by
surveying and are correct to the best of my knowledge and
belief.

Bernard D. Westfall P.S. 6634

