


BEING PART OF LOTS 82 AND 92 IN THE TOWNSHIP OF PERRY
LAKE COUNTY, OHIO AND ALSO BEING PARCEL 'B' OF A SPLIT
OF LAND CONVERTED TO THOMAS C. AND JACQUELINE HAAS
BY DEED RECORDED IN VOLUME 755 - PAGE 36 OF THE LAKE
COUNTY DEED RECORDS

~~SECRET~~

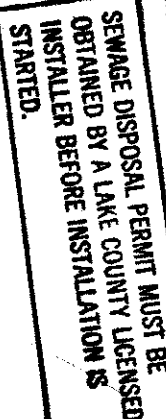

116

A. To be brought to immediate attention

1. Septic tank manhole covers

2. Sifter box cover

3. Distribution box cover

B. No footer drains or downspouts to be discharged into septic tanks

C. All waste water to be discharged into septic tanks

**LOW FLOW WATER
FIXTURES REQUIRED
ON ALL:**

- Shower Head
- Toilet
-

I the undersigned hereby certify this topography, indicated by 1' contours, and elevations shown hereon represent an actual field survey by me on May 1985 and that the were taken at appropriate intervals and that as of that date they existed as indicated hereon.

Grading Plan Approved
as shown and/or noted
THOMAS P. GILLES, P.E.
Lefko County Engineer
654 Date 6/1/01

VILLAGE SURVEYING CO.
P.O. BOX 1096, FAIRPORT HARBOR, OHIO 44077
216-377-1750

(216) 357-1359