


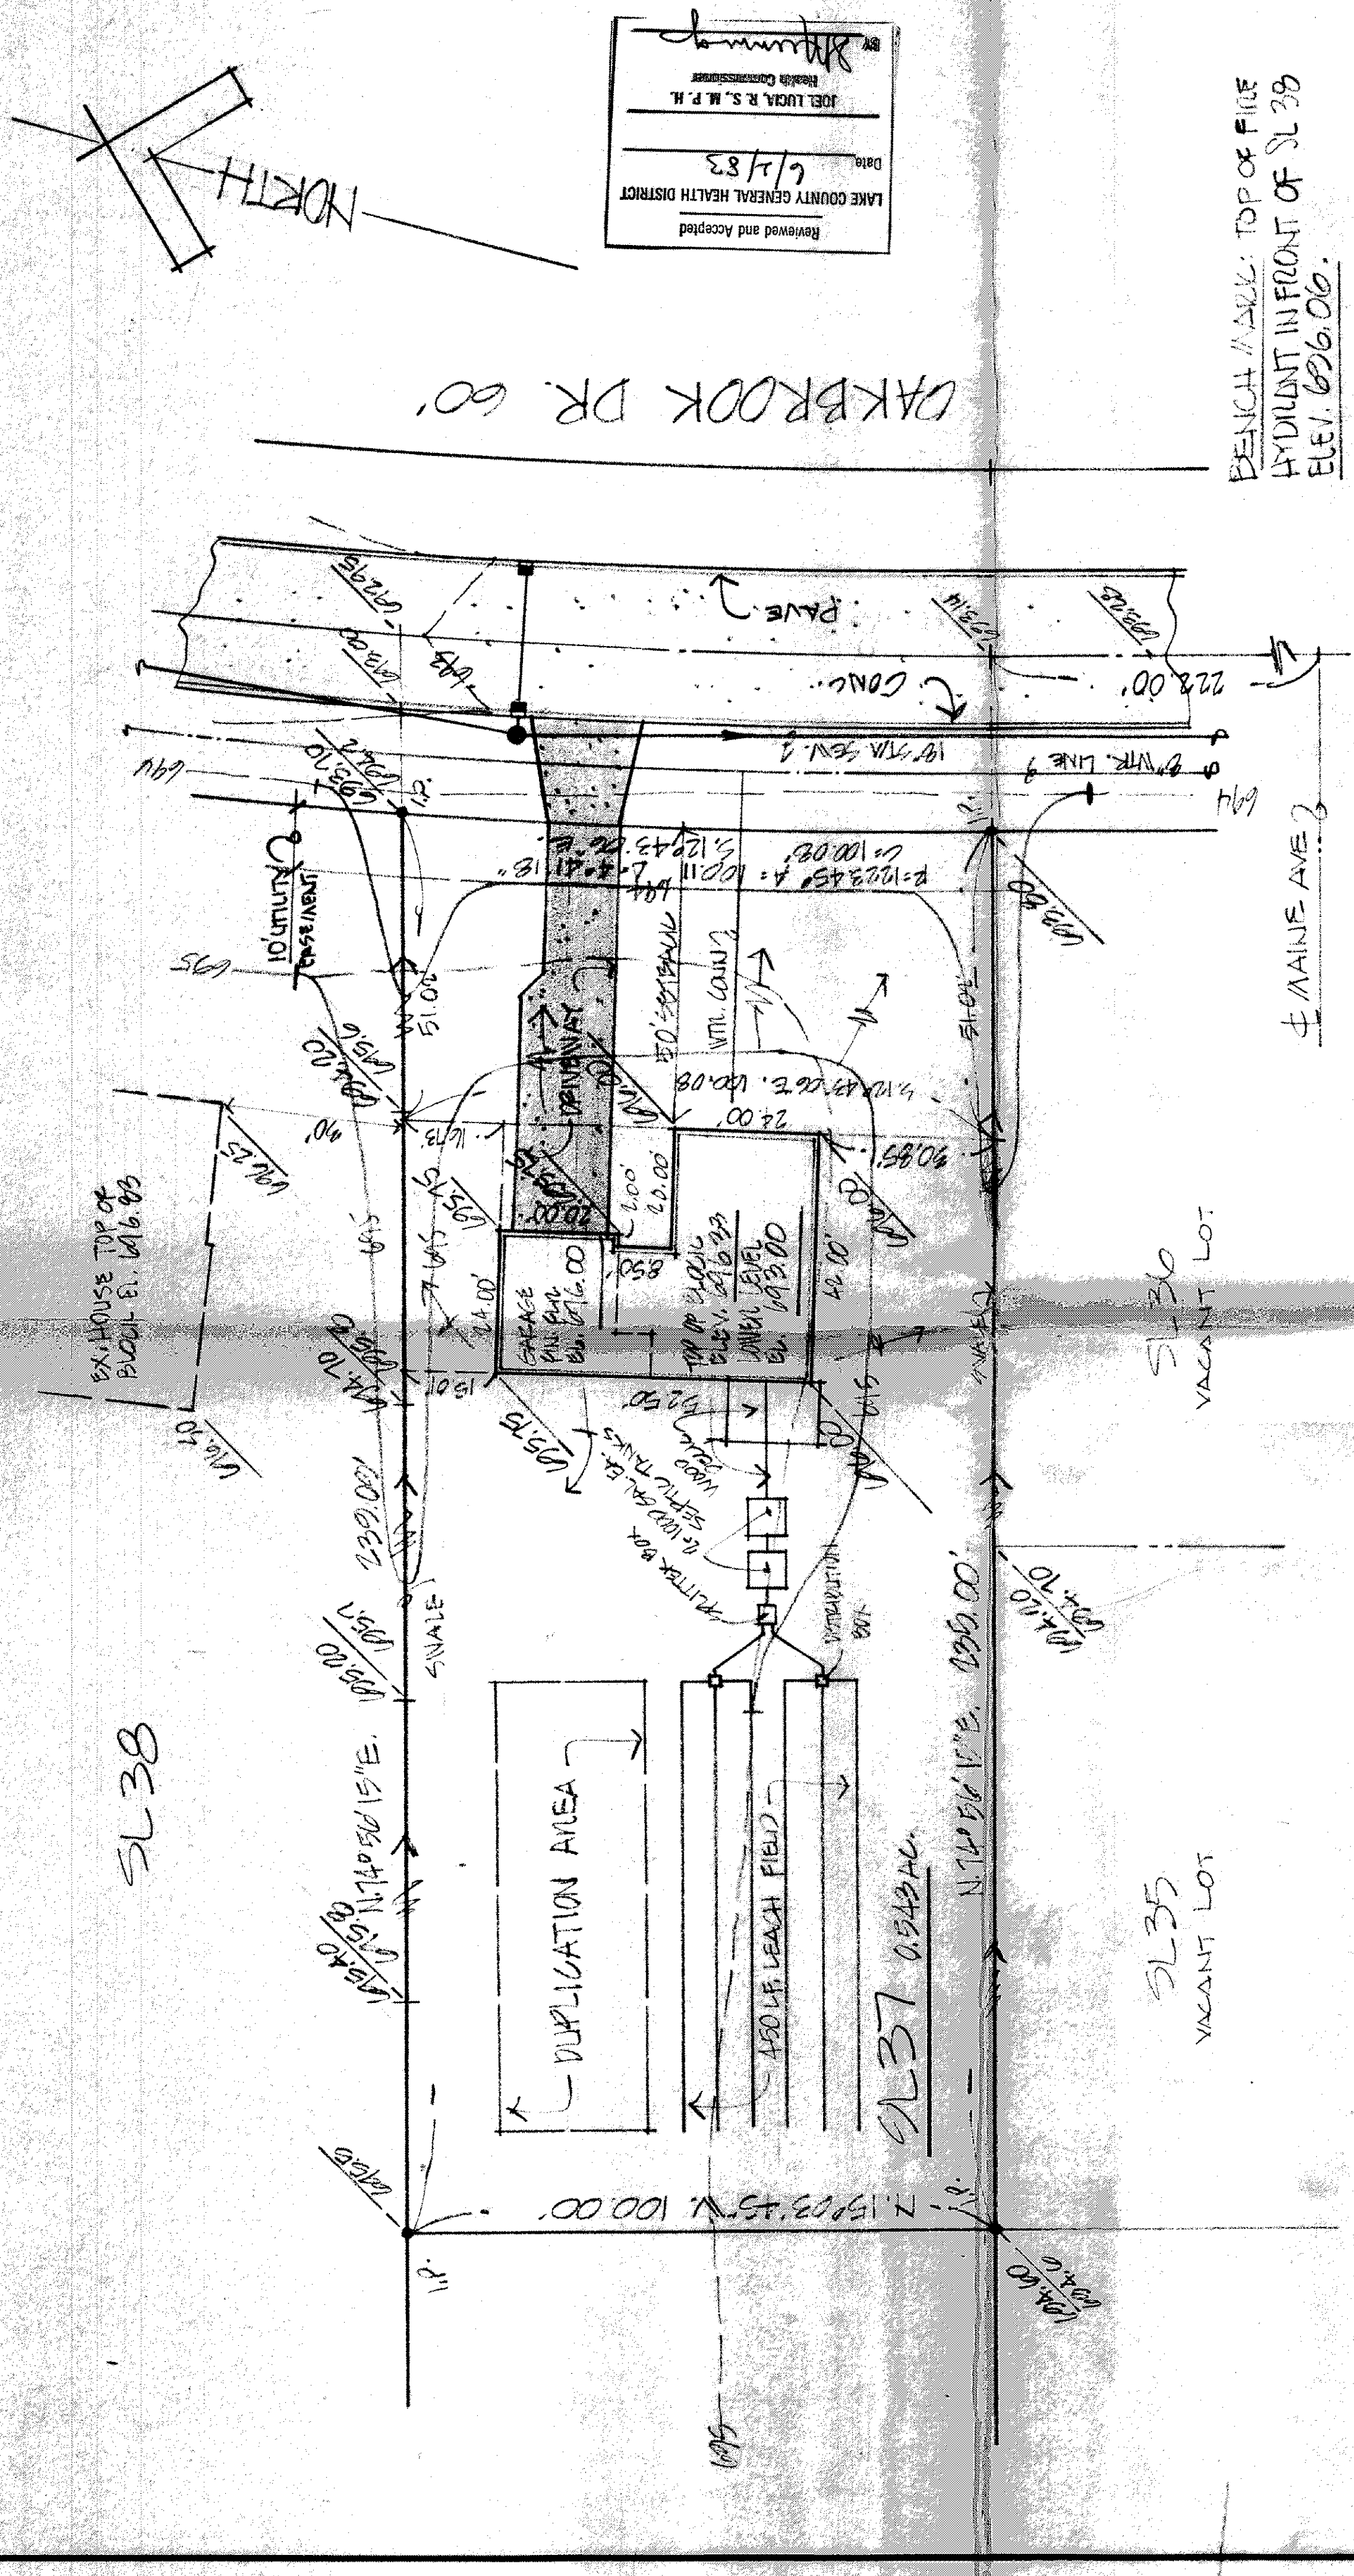

Reviewed and Accepted
 LAKE COUNTY GENERAL HEALTH DISTRICT
 Date 6/2/83
 JOEL LUGA, R. S. M. P. H.
 Health Commissioner

BENCH MARK: TOP OF FIDE
 HYDRAULIC IN FRONT OF SL 38
 ELEV. 696.06.

APPROVED
 SIDE LINES & SET BACK
 PERRY TOWNSHIP ZONING
 PERMIT NO. 2677
 ZONING INSPECTOR
 R. W. Patterson

Grading Plan Approved
 as shown and/or noted
 THOMAS P. GILLES, P.E.
 Lake County Engineer
 By T. W. Date 3 Jun 83

DESIGN CERTIFICATION
 THIS PLAN WAS PREPARED BY ME
 AND IS CORRECT TO THE BEST OF
 MY KNOWLEDGE AND BELIEF.
 REG. SURVEYOR NO. 4785
 Eric J. J. J.

AS BUILT CERTIFICATION
 I HEREBY CERTIFY THAT THE CIRCLED GRADES
 ARE EXISTING FINISH GRADES CHECKED IN THE
 FIELD ON AND THAT
 SURVEY IS CORRECT TO THE BEST OF MY
 KNOWLEDGE AND BELIEF.
 REG. SURVEYOR NO. 4785

UNDERLINED ELEVATIONS
 INDICATE PROPOSED GRADES

SITE PLAN FOR: CASEMENT HOMES
 1251 MADISON AVENUE, FAIRBURN, OHIO.
 BEING A LOT NO. 37 IN OVERLOOK VILLAGE SUBDIVISION IN PERRY TWP., OHIO.
 RECORDED IN VOL. 2, P. 21 OF 22, RECORD OF PLATS.

DATE MAY 17 1983
 SCALE 1" = 20'
 DRAWN BY [Signature]
 CHECKED BY [Signature]
COLPETZER WOODS
 CONSULTANTS, INC.
 MENTOR OHIO 44060
 SHEET 1 OF 1
 CONTRACT NO. 1

