

PREPARED BY:
 Wilson and Associates
 Registered Surveyors
 11005 Wilson Mills Road
 Chardon, Ohio 44024
 Date May 8, 1974
 Scale: 1" = 30'

APPROVED
 SIDE LINES & SET BACK
 PERRY TOWNSHIP ZONING
 PERMIT NO. _____
 ZONING INSPECTOR

R.W. Patterson

SITE PLAN

LANE GROVE ESTATES
 SUBLOT NO 14
 VOLUME 5 PAGE 12

PERRY TOWNSHIP
 LAKE COUNTY OHIO
 for
 CASEMENT HOMES
 1251 MADISON AVE
 PAINESVILLE, OHIO

CERTIFICATION


I certify that this plat was prepared by me,
 and is correct to the best of my knowledge

By: *Lawrence Wilson*
 Lawrence Wilson, Reg. Surveyor No 5807

"AS BUILT" CERTIFICATION

I certify that on _____ 1974,
 the finished grades were checked in the
 field, shown encircled, and are correct to
 the best of my knowledge.

By: _____
 Lawrence Wilson, Reg. Surveyor No 5807

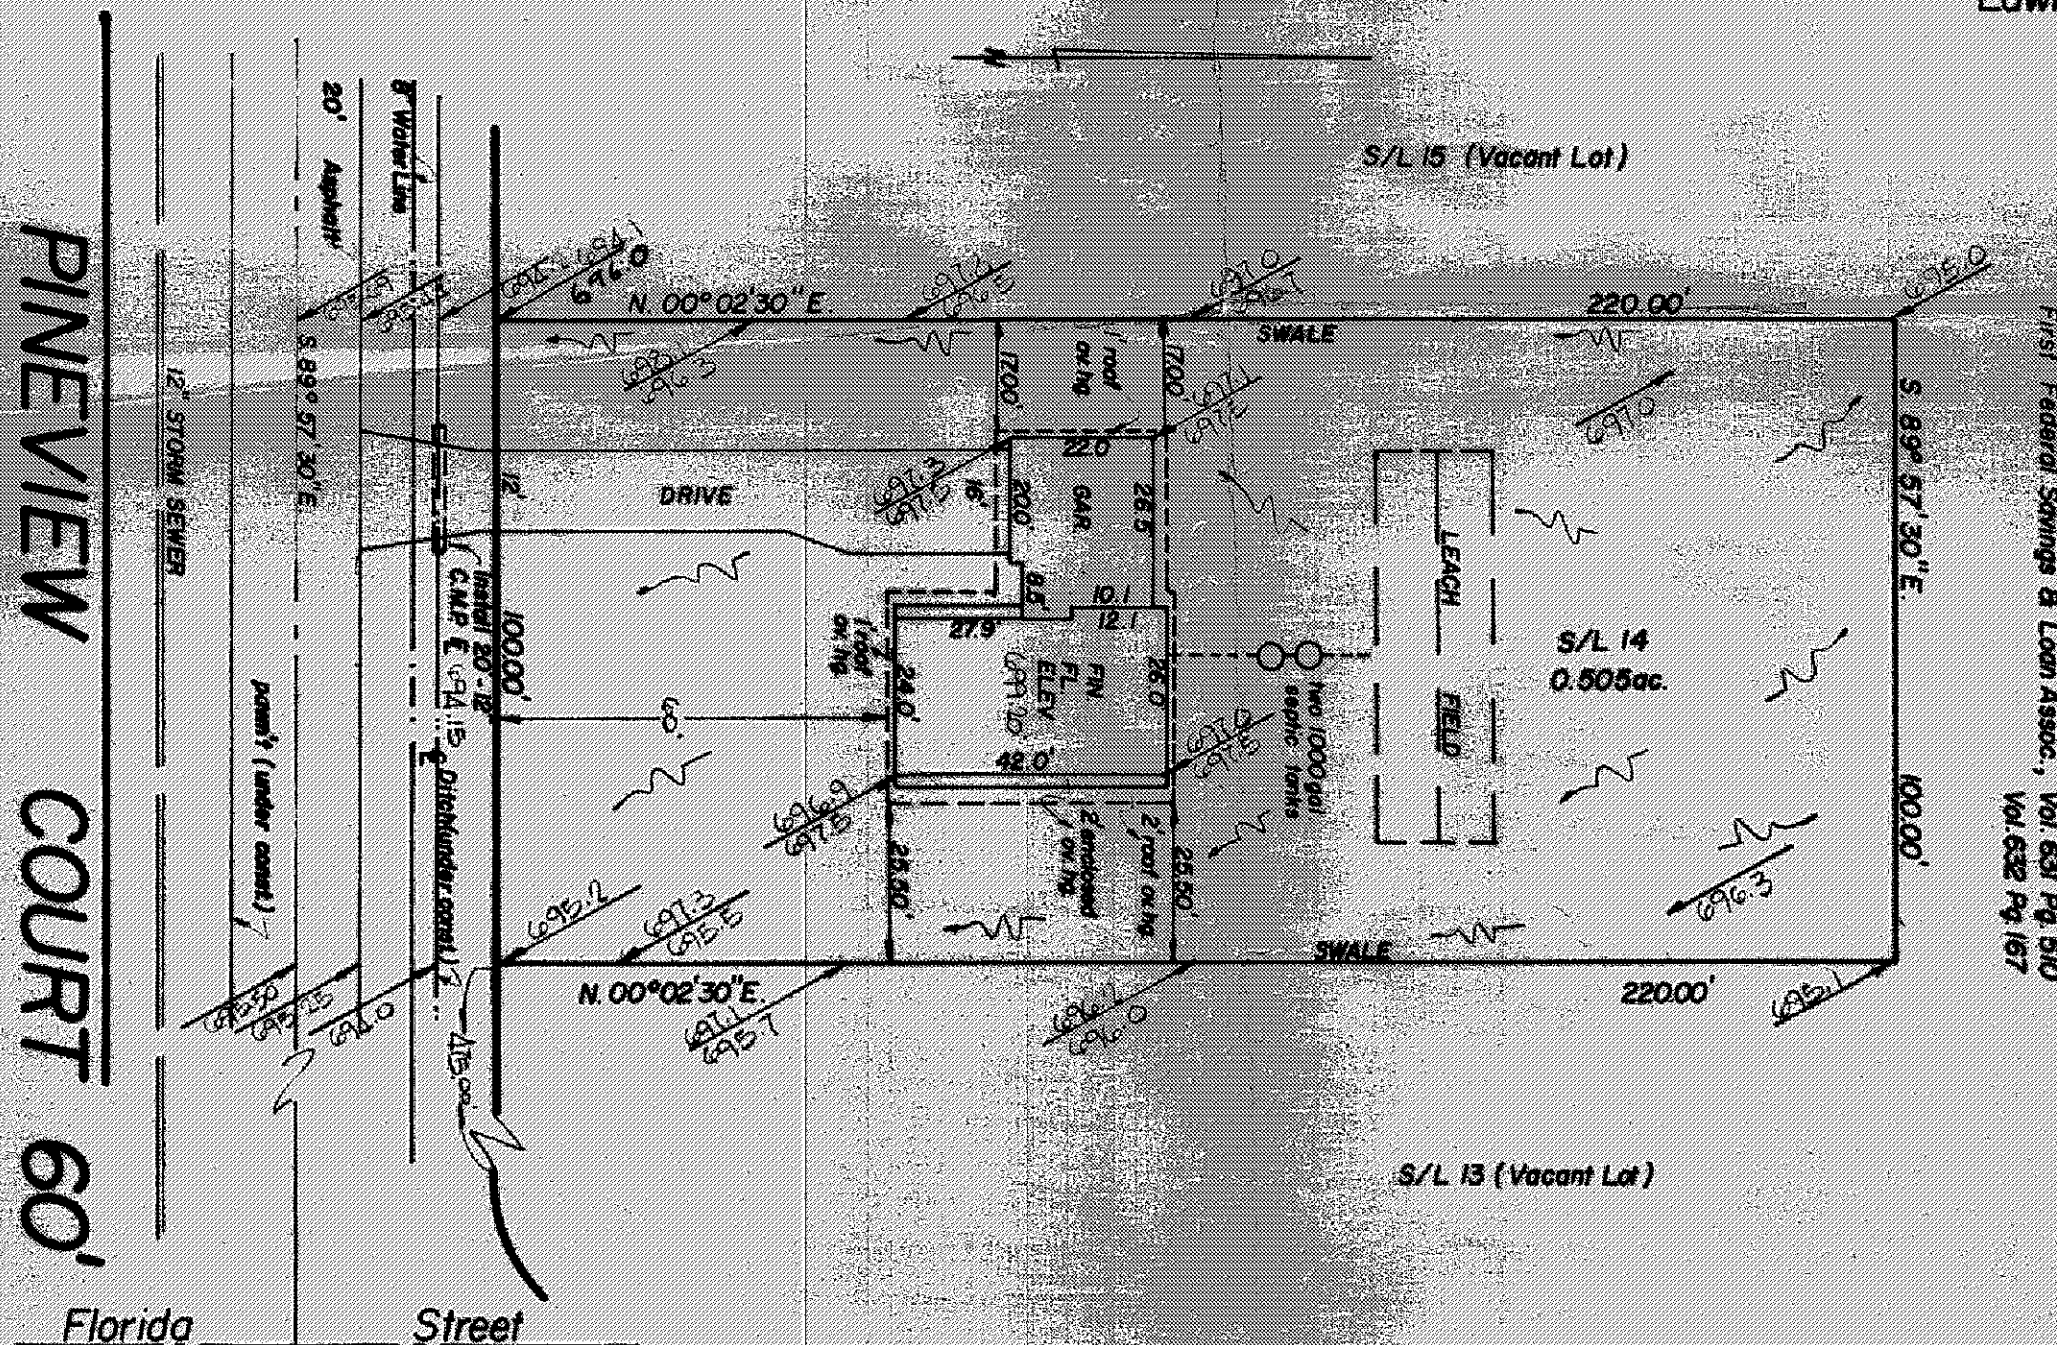

BENCH MARK TOP OF R.R. SPK. AT INTERSECTION
 OF FL. OF FLORIDA AND OREGON ST.
 EL. 693.50'

EXIST. EL. 696.0
 PROP. EL. 695.0

Grading Plan Approved
 as shown and/or noted
 THOMAS P. GILLES, P.E.
 Lake County Engineer

By: *JWK* Date _____

