

PREPARED BY:

Wilson and Associates
Registered Surveyors
11005 Wilson Mills Road
Chardon, Ohio 44024
Date: April 15, 1974
Scale: 1" = 30'

as shown and/or noted
THOMAS P. GILLES, P.E.
Lake County Engineer

SITE PLAN

LANE GROVE ESTATES

SUBLOT NO. 13

VOLUME 5 PAGE 12

PERRY TOWNSHIP

LAKE COUNTY OHIO

for
CASEMENT HOMES
1251 MADISON AVE.
PAINESVILLE, OHIO

By

JWK

Date

4-25-74

CERTIFICATION:

I certify that this plat was prepared by me,
and is correct to the best of my knowledge

By:

Lawrence Wilson


Lawrence Wilson, Reg. Surveyor No. 5807

"AS BUILT" CERTIFICATION:

I certify that on _____ 1974,
the finished grades were checked in the
field, shown encircled, and are correct to
the best of my knowledge

By:

Lawrence Wilson, Reg. Surveyor No. 5807

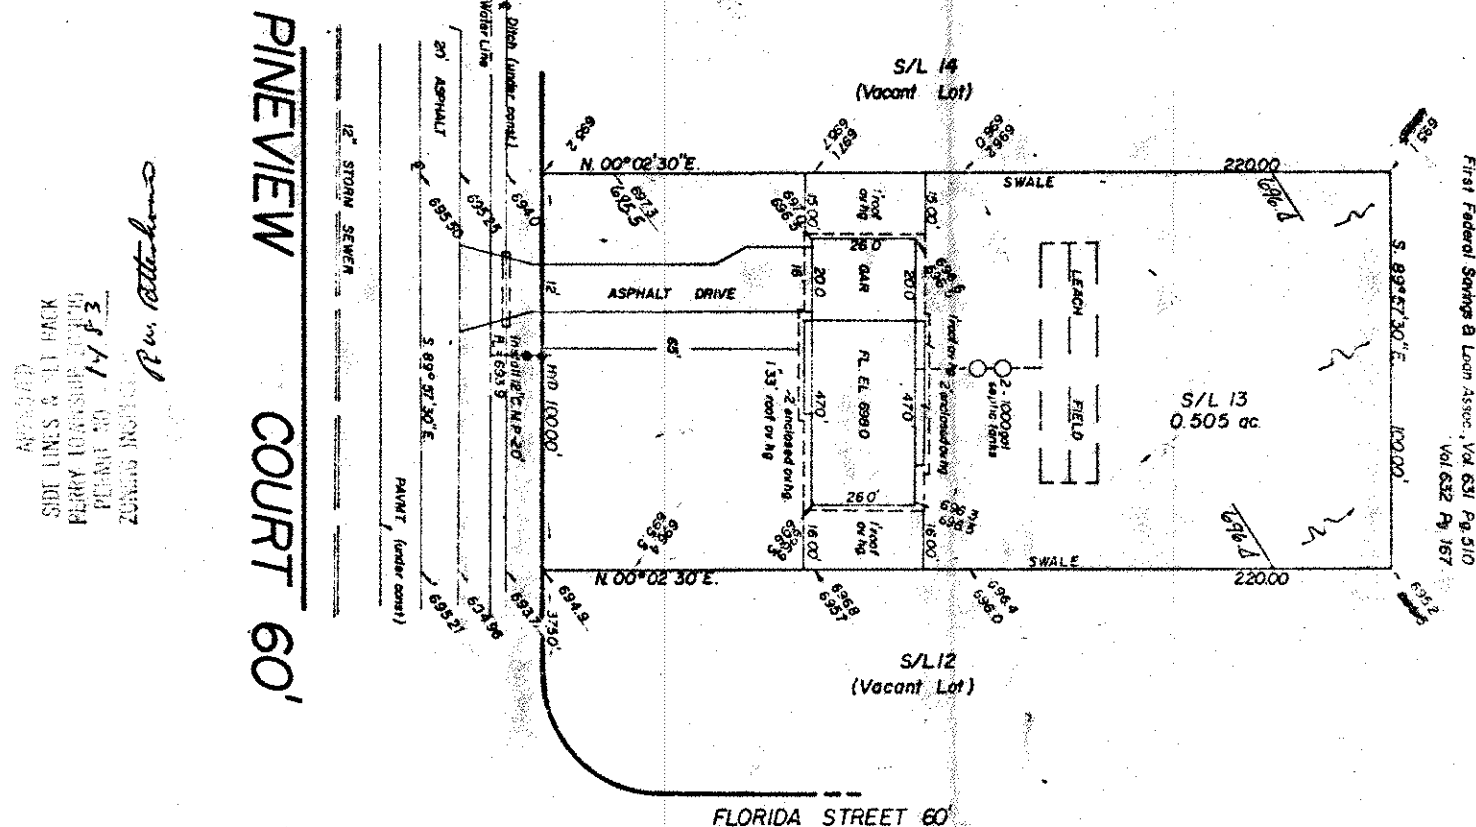

BENCH MARK TOP OF R.R. SPK AT INTERSECTION
OF E. of FLORIDA AND OREGON ST
EL. 693.50

EXIST. EL.
PROP. EL.

First Federal Savings & Loan Assoc., Vol. 631 Pg. 510
Vol. 632 Pg. 167

AS SHOWN
SIDE LINES & SET BACK
PERRY TOWNSHIP RECORD
PLAT NO. 1483
ZONING INFO

P. W. Attchman

