

Wilson and Associates
Registered Surveyors
11005 Wilson Mills Road
Chardon, Ohio 44024
Date: April 15, 1974
Scale: 1" = 30'

Grading Plan Approved
as shown and/or noted
THOMAS P. GILLES, P.E.
Lake County Engineer.

Ex. JWK Date 4-25-24

LANE GROVE ESTATES
SUBLOT NO.12
VOLUME 5 PAGE 12

PERRY TOWNSHIP
LAKE COUNTY OHIO
for
CASEMENT HOMES
1251 MADISON AVE.
PAINESVILLE, OHIO

I certify that this plat was prepared by me,
and is correct to the best of my knowledge.
By: Lawrence Wilson


Lawrence Wilson, Reg. Surveyor No. 5807

"AS BUILT" CERTIFICATION:

I certify that on _____ 1974,
the finished grades were checked in the
field, shown encircled, and are correct to
the best of my knowledge.

By:

Lawrence Wilson, Reg Surveyor No 5807

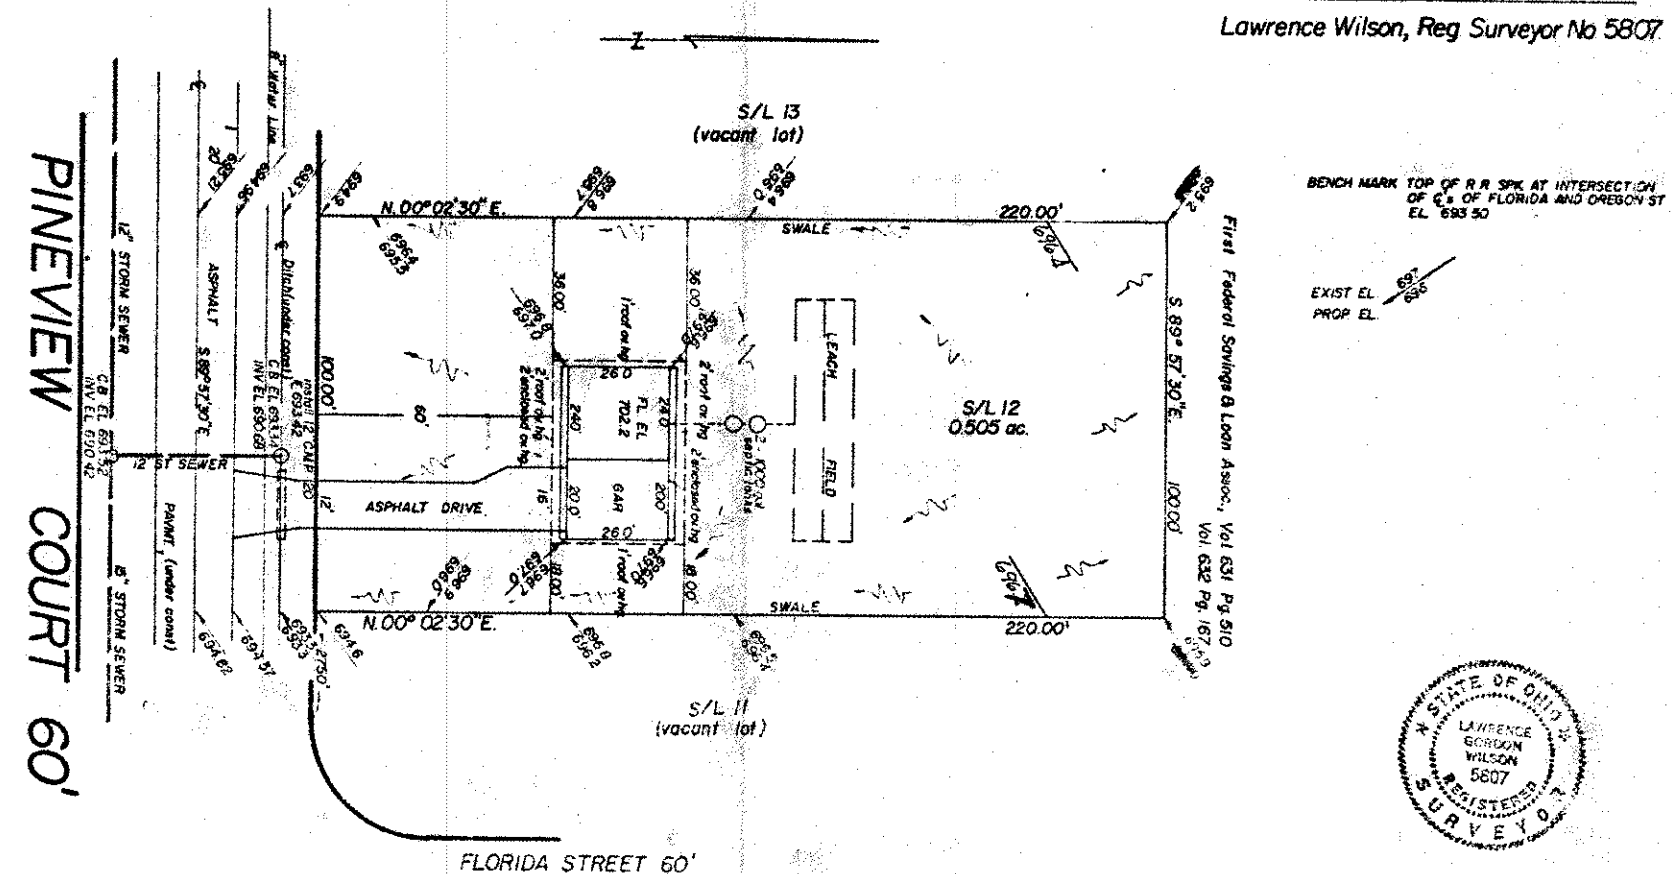

APPROVED
BY THE CITY BACK
FIGHT LOGS CAMP ZONING
PERMIT NO. (482)
ZONING INSPECTION

Pie Attorneys

