
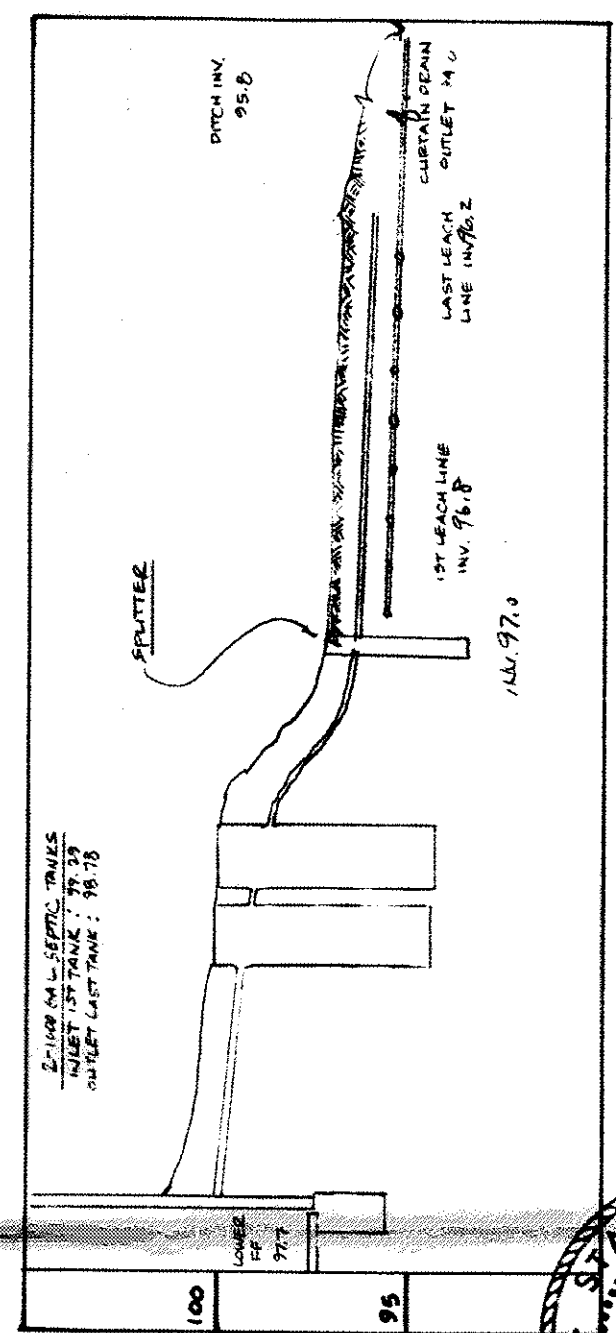


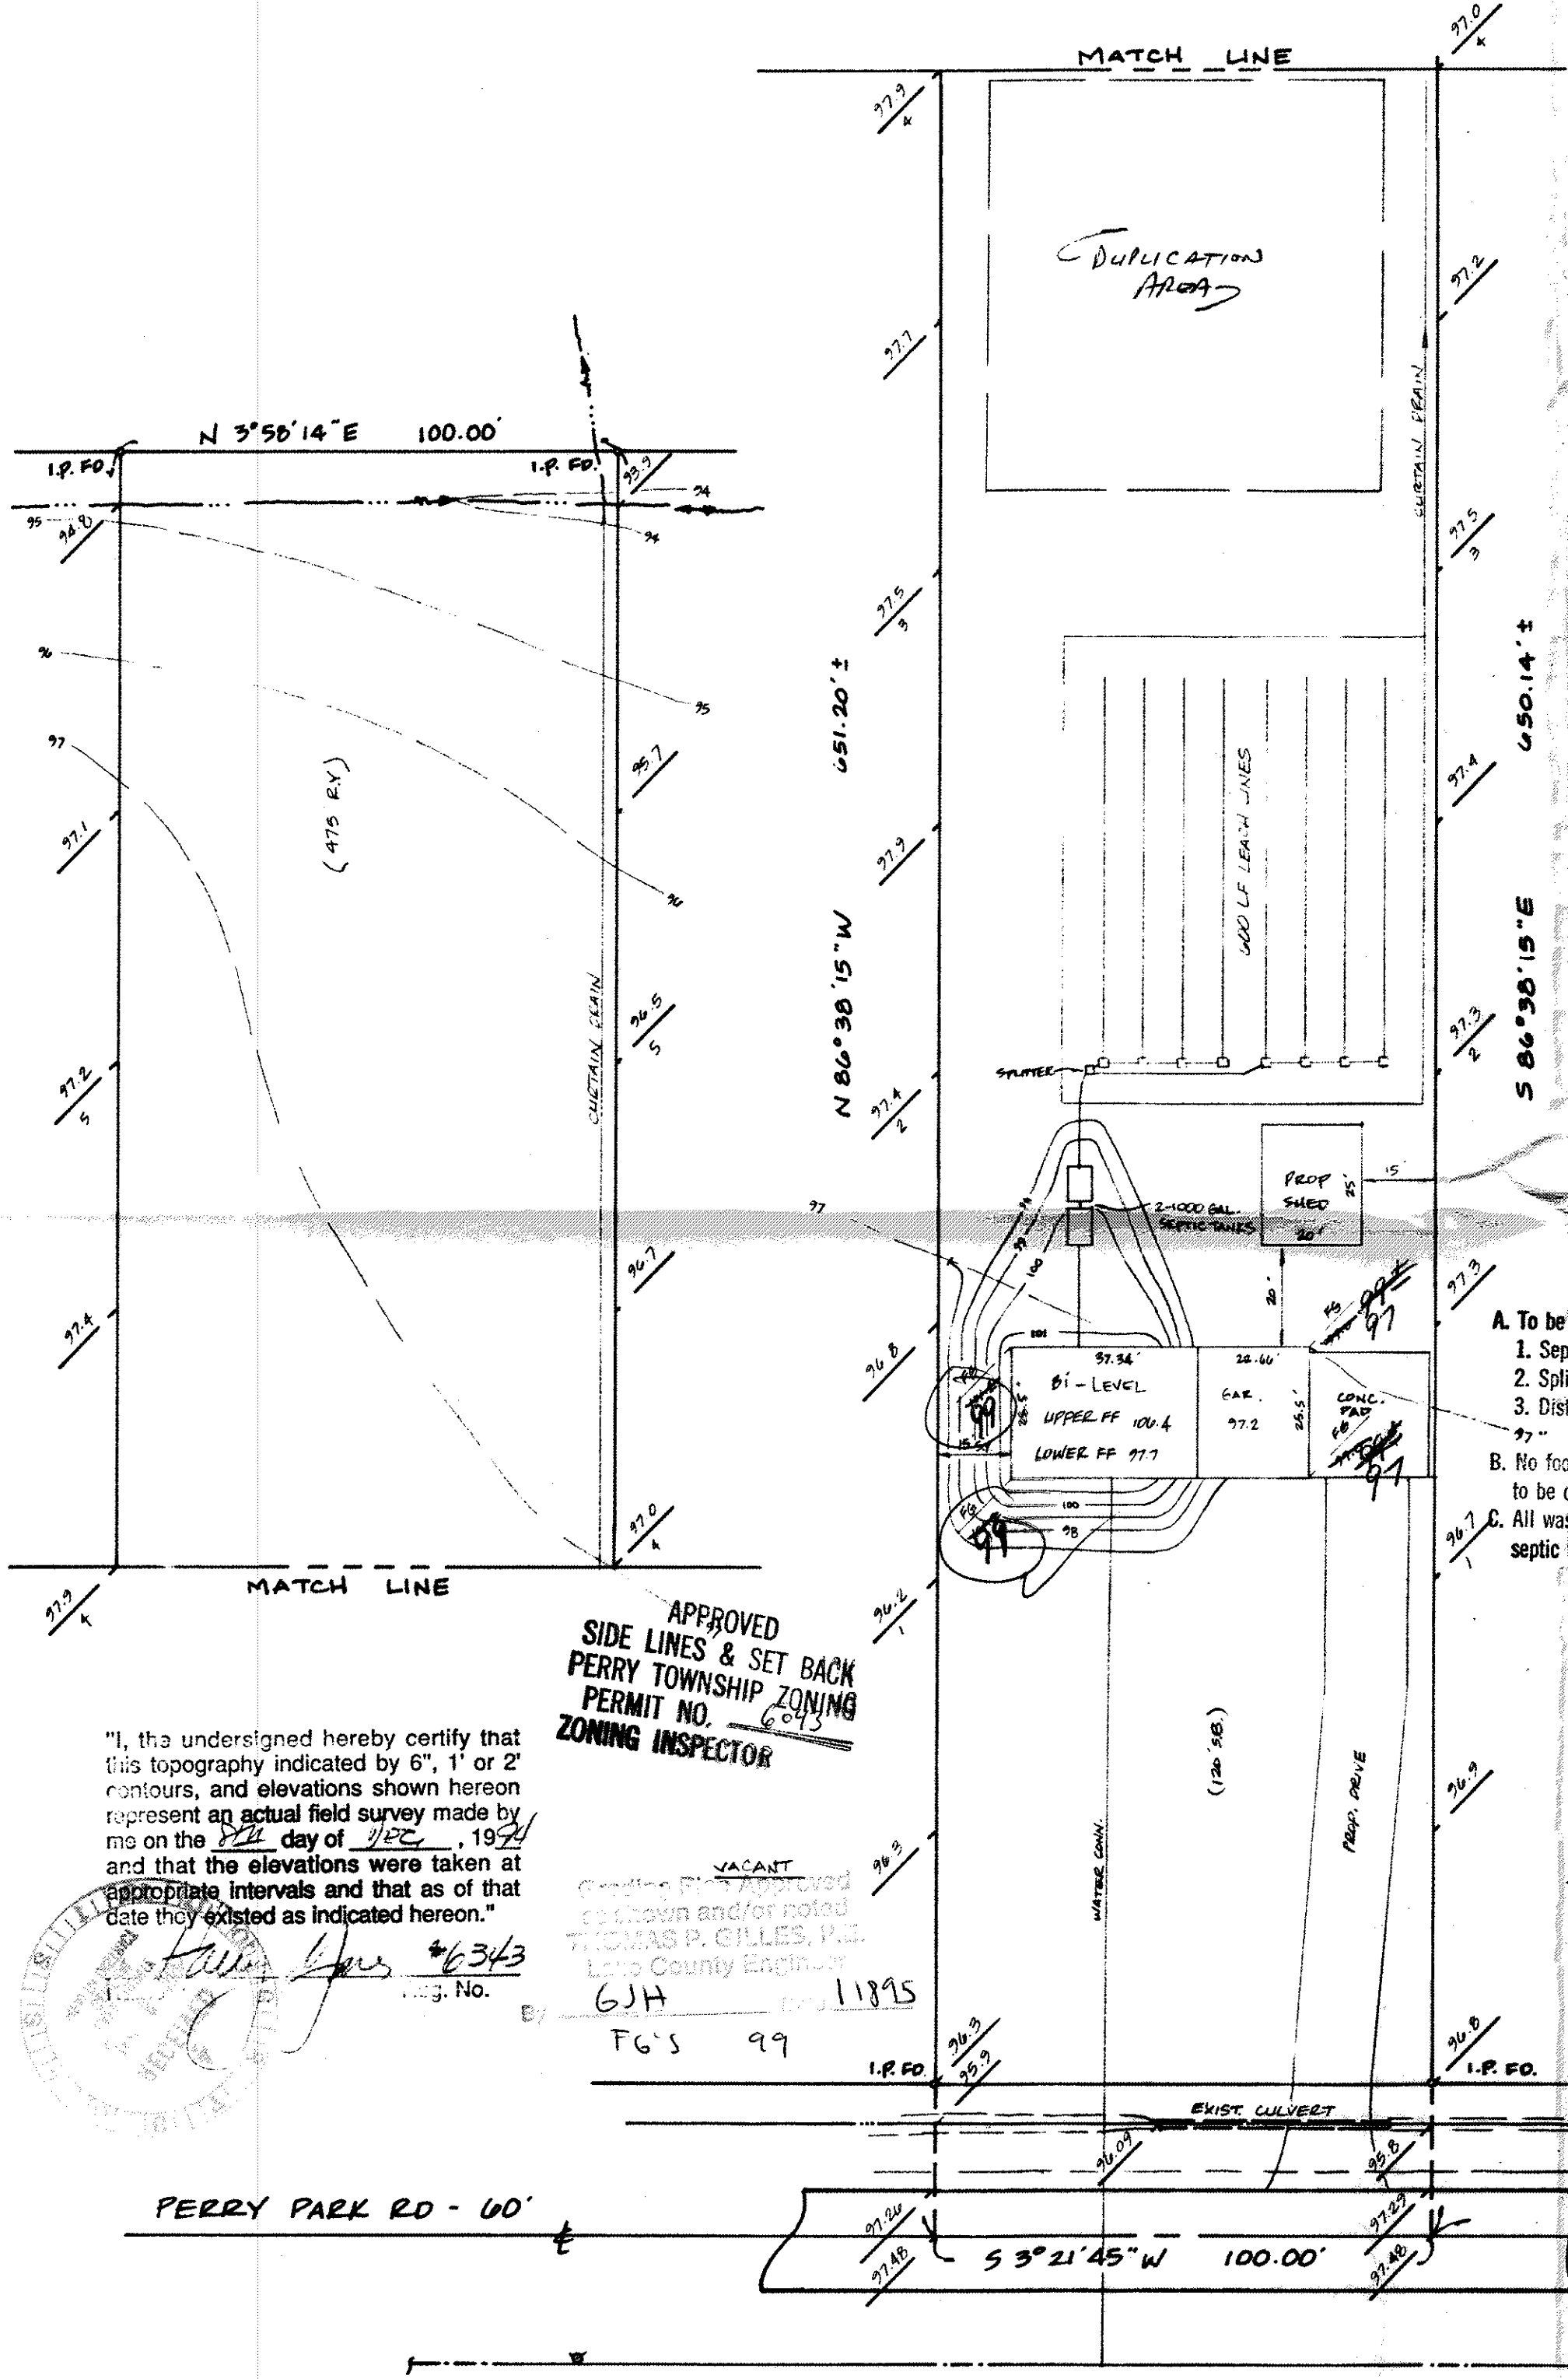

HYDRAULIC PROFILE

HORIZ. 1" = 30', VERT. 1" = 5'

SITE PLAN

PERRY TOWNSHIP, LAKE COUNTY, OHIO

for: SELAN CONSTRUCTION
CLIENT OWNER

ADDRESS	STREET	CITY	ZIP
SUBDIVISION	NAME	LOT 97	TRACT 127
VOL. - PG.		VOLUME 3A-31-22	PAGE PERRY PARK
SUBLOT NO.	STREET	PERM. PARCEL NO.	STREET

LEGEND

SANITARY MANHOLE	---○---	WATER VALVE (GAS)	---+---
STORM MANHOLE	---●---	WATER METER (GAS)	---+---
INLET OR CATCH BASIN	---□---	AS BUILT ELEVATION	100.0
HYDRANT	---◇---	INDICATES DIRECTION OF SURFACE DRAINAGE	↓
EXISTING CONTOURS	---○---		
PROPOSED CONTOURS	---○---		
EXIST. ELEV.	100.0	PROP. ELEV.	100.0

REMARKS

ALL BOUNDARY DATA SHOWN WAS OBTAINED FROM (DEEDS, RECORDED SUBDIVISION PLAT OR OTHER PUBLIC RECORDS)
LOCATIONS AS SHOWN OF ADJACENT WELLS AND SEPTIC TANKS OBTAINED FROM LAKE COUNTY HEALTH DEPARTMENT

DESIGN CERTIFICATION

THIS PLAT WAS PREPARED BY ME, AND IS CORRECT TO THE BEST OF MY KNOWLEDGE AND BELIEF

NAME SURVEYOR REGISTRATION NO. 6343

CHECK LIST

NO. OF BEDROOMS	WATER MAIN SIZE, LOCATION
DIMENSIONS	SAN. SEWER SIZE % GR. LOC.
BEARINGS	SAN. MH. CAST. ELEV. INV. ELEV.
TIE TO NEAREST STREET	SAN. CONN. SIZE, LOC. DEPTH
SUBLOT NO. PARCEL NO.	STORM SEWER SIZE % GR. LOC.
SURROUNDING OWNERS	STORM MH. CAST. ELEV. INV. ELEV.
BLDG. DIMENSIONS FIN. GR.	PAVT. TYPE GRADE CURBS
BLDG. TIES FLTR. GRADES	GAS LINE LOC. SIZE PRESSURE
APRON TYPE WIDTH THICKNESS	SEPTIC TANK LOCATION & DUPLICATION AREA
SIDEWALK TYPE WIDTH THICKNESS	WELL LOCATION
CULVERT TYPE DIA., LENGTH	ISOLATION RADIUS FROM WELL
ROCK OUTCROPPINGS	

REVISIONS

NO.	DATE	BY
1	12-27-94	PER SELAN
2		
3		
4		
5		

PLAN PREPARED BY:	SCALE 1" = 30'	PHONE NO. 357-1811
BABCOCK • JONES & ASSOCIATES, INC.	DATE DEC. 9, 1994	DRAWING NO. 94-286-22
PAINESVILLE, OHIO	APP'D. 15	

"AS BUILT" CERTIFICATION

I, HEREBY CERTIFY THAT THE CIRCLED GRADES ARE EXISTING FINISH GRADES CHECKED IN THE FIELD ON 1994 AND ARE CORRECT TO THE BEST OF MY KNOWLEDGE AND BELIEF.



REGISTERED SURVEYOR REG. NO.

TEMP. BENCHMARK: TOP OF HYDRANT WEST SIDE PERRY PARK RD., 109' SOUTH OF RR 3A-31-22
ELEV. = 100.00

SEWAGE DISPOSAL PERMIT MUST BE OBTAINED BY A LAKE COUNTY LICENSED INSTALLER BEFORE INSTALLATION IS STARTED.

LOT SOIL CLASSIFICATION: MINOA
FINE LOAMY SAND.
HIGHWALL PLUMBING REQ'D.


LOW YIELD WATER FIXTURES REQUIRED ON ALL:
Shower Head
Toilet

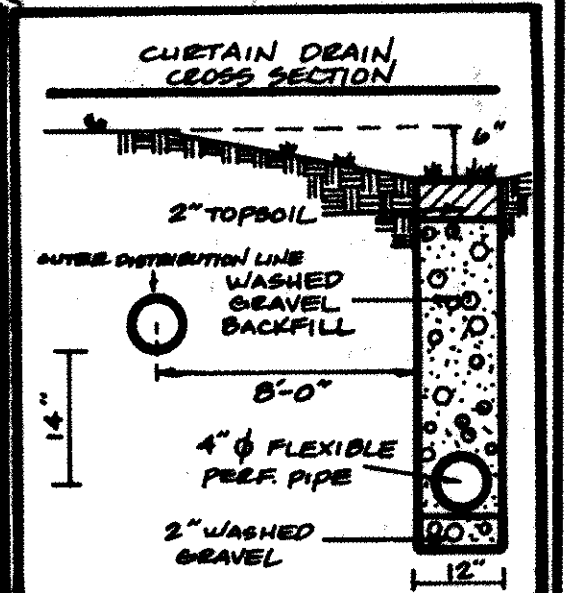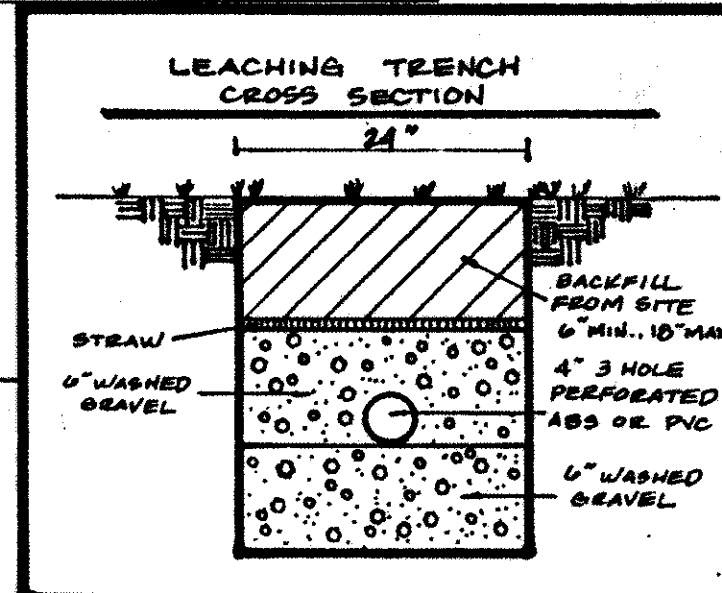

"I, the undersigned hereby certify that this topography indicated by 6", 1" or 2" contours, and elevations shown hereon represent an actual field survey made by me on the 24 day of DEC, 1994 and that the elevations were taken at appropriate intervals and that as of that date they existed as indicated hereon."

APPROVED
SIDE LINES & SET BACK
PERRY TOWNSHIP ZONING
PERMIT NO. 6093
ZONING INSPECTOR

VACANT
Grading Plan Approved
as shown and/or noted
THOMAS P. GILES, P.E.
Lake County Engineer
GJH 11895
FG'S 99

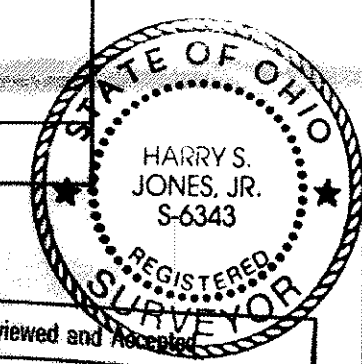

Reviewed and Accepted
LAKE COUNTY GENERAL HEALTH DISTRICT
Date 1-6-95
JOEL LUCIA, R. S., M. P. H.
Health Commissioner
BY J. Lindsay