


GEO NEMETH
207-467

BEARING
S164.44


ROBERT EMAN
582.17

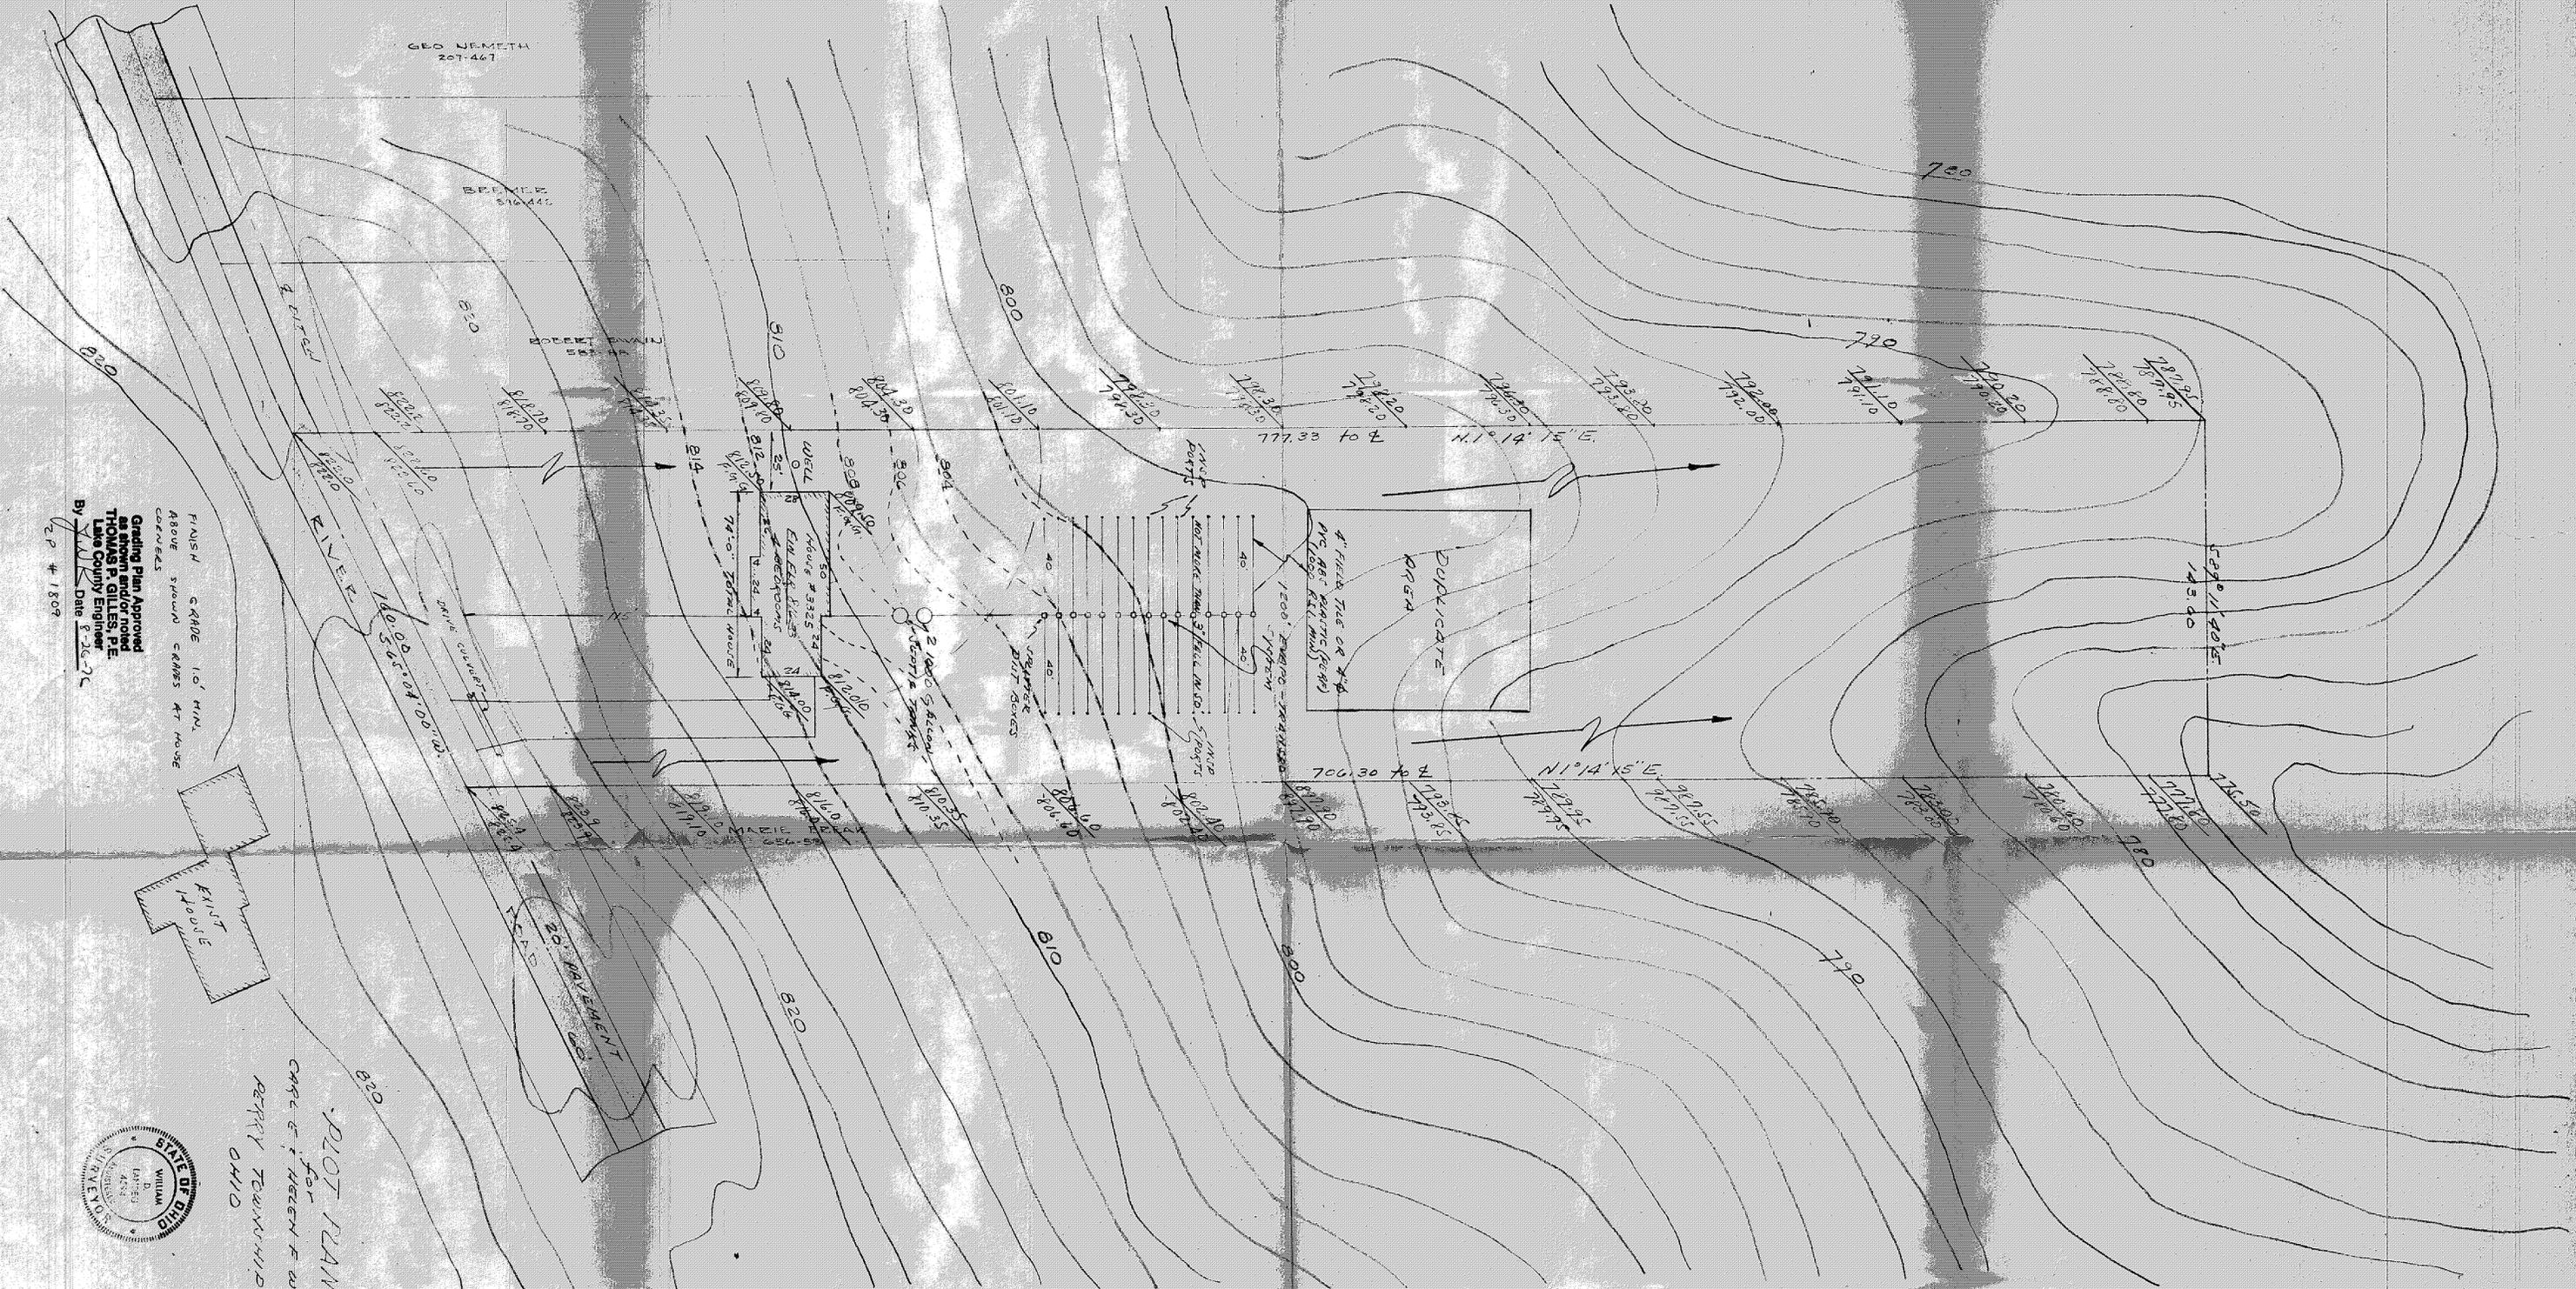

Grading Plan Approved
as shown and/or noted
THOMAS P. GILLES, P.E.
Lima County Engineer
Date 5-26-76
By [Signature] Z.P. # 1809




Plot Plan
for
CARE & HAZEN & WOOD
BERRY TOWNSHIP
OHIO

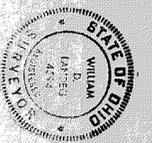


- LEGEND
1. Proposed Ground Grades
 2. Existing Ground
 3. Existing Road
 4. Proposed Ground Contours

NOTE:
FINAL LOCATION & SIZE OF
SEPTIC SYSTEM TO BE
DETERMINED BY LAKE CITY
HEALTH DEPARTMENT
(SEE DRAWING)


- ENROLL NO.
1. 17147, 016.53
 2. BARNETT 179, 80833

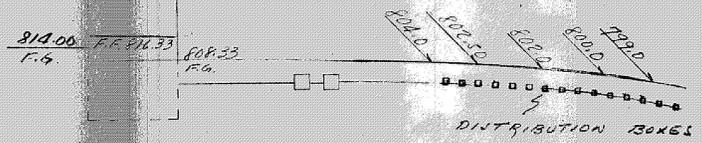

EVAPORATION-TRANSMISSION SYSTEM PROFILE

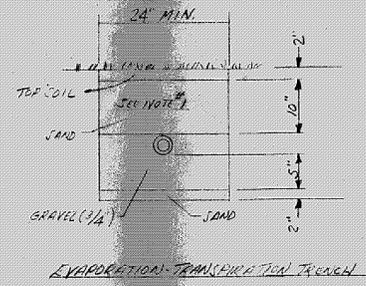

NOTES:
1) CLEAN SAND 4 TO 10 IN IN SIZE,
UNIFORM COEFFICIENT NOT TO
EXCEED 4.

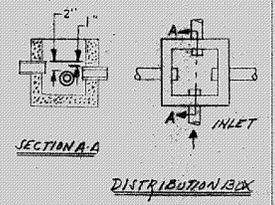

REVISIONS			LAKE INC		
NO.	DATE	BY	ENGINEER & SURVEYOR	SCALE	MATERIAL
1			30575 EUGENE AVE. COLUMBUS, O. <td>DATE 5-26-76 <td></td> </td>	DATE 5-26-76 <td></td>	
2			30575 EUGENE AVE. COLUMBUS, O. <td>DATE 5-26-76 <td></td> </td>	DATE 5-26-76 <td></td>	
3				DATE 5-26-76	
4				DATE 5-26-76	
5				DATE 5-26-76	