


APPROVED
SIDE LINES & SET BACK
PERRY TOWNSHIP ZONING
PERMIT NO. 1495
ZONING INSPECTOR
R.W. Patterson

5-9-74 Date
JWK
Lake County Engineer
THOMAS P. GILES, P.E.
as shown and/or noted
Grading Plan Approved

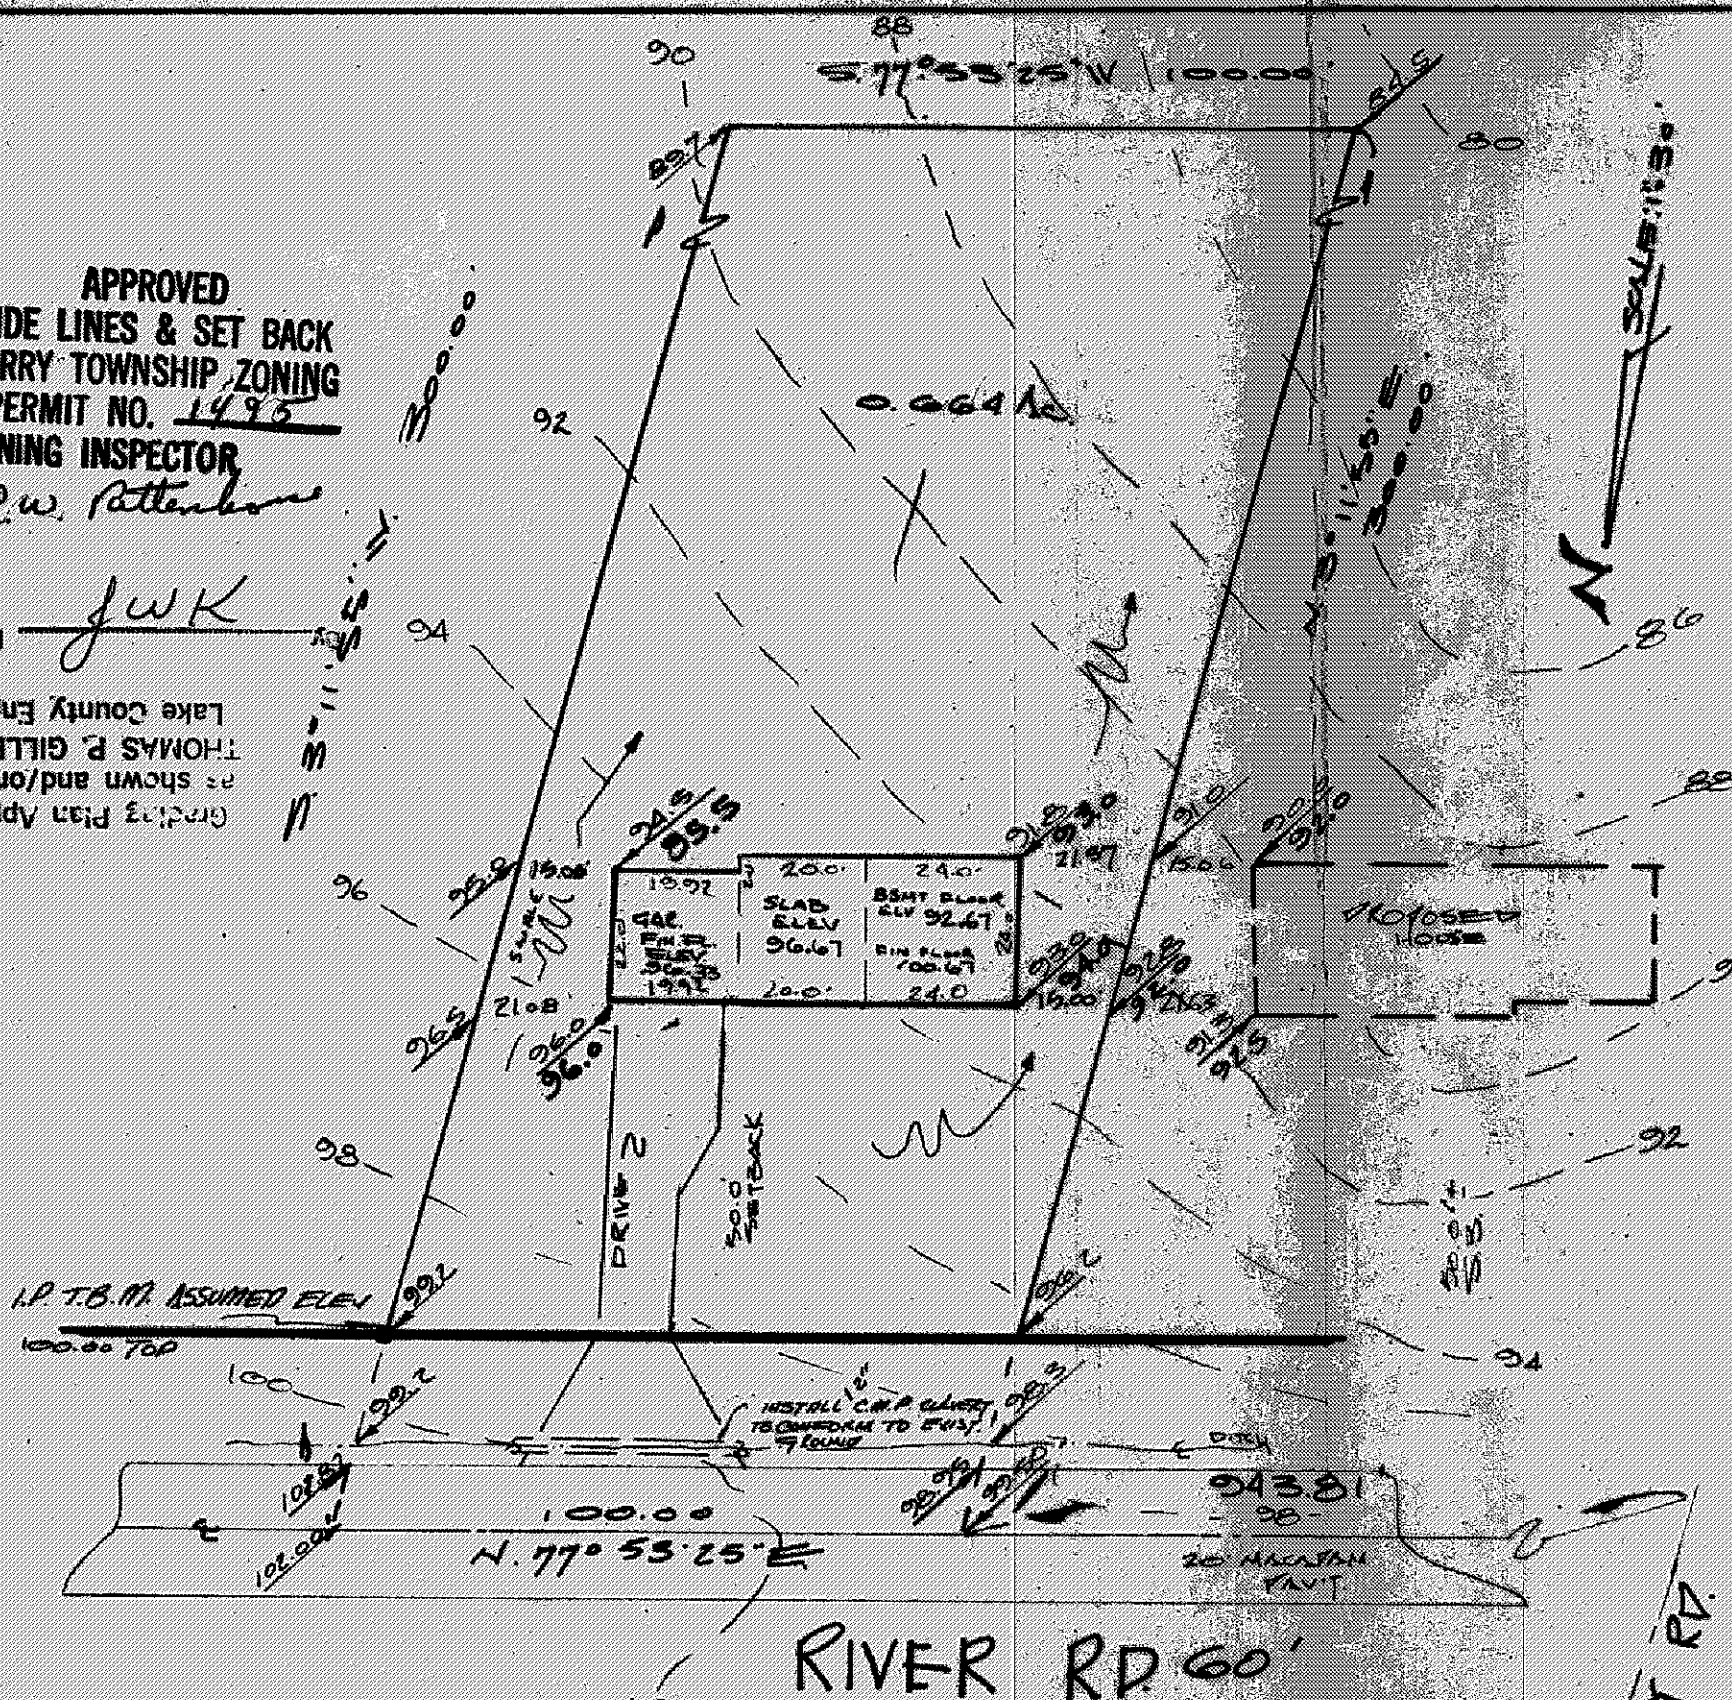

SITE PLAN

PERRY TOWNSHIP LAKE COUNTY, OHIO
for: LLOYD LUTHE
CLIENT OWNER

ADDRESS	STREET	CITY	ZIP
SUBDIVISION	NAME	LOT	TRACT
VOL. & PG.		VOLUME	PAGE
SUBLOT NO.	STREET	PERM. PARCEL #	STREET

LEGEND

SANITARY MANHOLE	--- (1)	WATER VALVE (GAS)	--- (1)
STORM MANHOLE	--- (2)	WATER METER (GAS)	--- (1)
INLET OR CATCH BASIN	--- (3)	AS BUILT ELEVATION	---
HYDRANT	--- (4)	INDICATES	---
EXISTING CONTOURS	---	DIRECTION OF	---
PROPOSED CONTOURS	---	SURFACE DRAINAGE	---
EXIST. ELEV. 100.0	---		
PROP. ELEV. 100.0	---		

REMARKS

ALL BOUNDARY DATA SHOWN WAS OBTAINED FROM (DEEDS, RECORDED SUBDIVISION PLAT OR OTHER PUBLIC RECORDS)

DESIGN CERTIFICATION

THIS PLAN WAS PREPARED BY ME, AND IS CORRECT TO THE BEST OF MY KNOWLEDGE AND BELIEF.
Richard J. Debevec PS 5244
NAME SURVEYOR REGISTRATION NO.

CHECK LIST

DIMENSIONS	WATER MAIN SIZE LOCATION
BEARINGS	SAN. SEWER SIZE % GR. LOC.
TIE TO NEAREST STREET	SAN. MH CAST ELEV. INV. ELEV.
SUBLOT NO. PARCEL NO.	SAN. CONN. SIZE LOC. DEPTH
SURROUNDING OWNERS	STORM SEWER SIZE % GR. LOC.
BLDG. DIMENSIONS FIN. GR.	STORM MH CAST ELEV. INV. ELEV.
BLDG. TIES FLR. GRADES	PAVT. TYPE GRADE CURBS
APRON TYPE WIDTH THICKNESS	GASLINE LOC. SIZE PRESSURE
SIWALK TYPE WIDTH THICKNESS	SEPTIC TANK SIZE LOC.
CULVERT TYPE DIA. LENGTH	WELL LOCATION

REVISIONS			PLAN PREPARED BY:		
NO	DATE	BY	DEBEVEC-SALO & ASSOC, INC.		
1			130 EAST JACKSON ST. PAINESVILLE		
2			DRAWN BY	SCALE	PHONE NO.
3			CHK'D	DATE	DRAWING NO.
4			CREW CHIEF	APPD	
5					

"AS BUILT" CERTIFICATION

I, HEREBY CERTIFY THAT THE CIRCLED GRADES ARE EXISTING FINISH GRADES CHECKED IN FIELD ON 19 BY SURVEYING AND ARE CORRECT TO THE BEST OF MY KNOWLEDGE AND BELIEF

REGISTERED SURVEYOR

REG. NO.

TURNER RD