
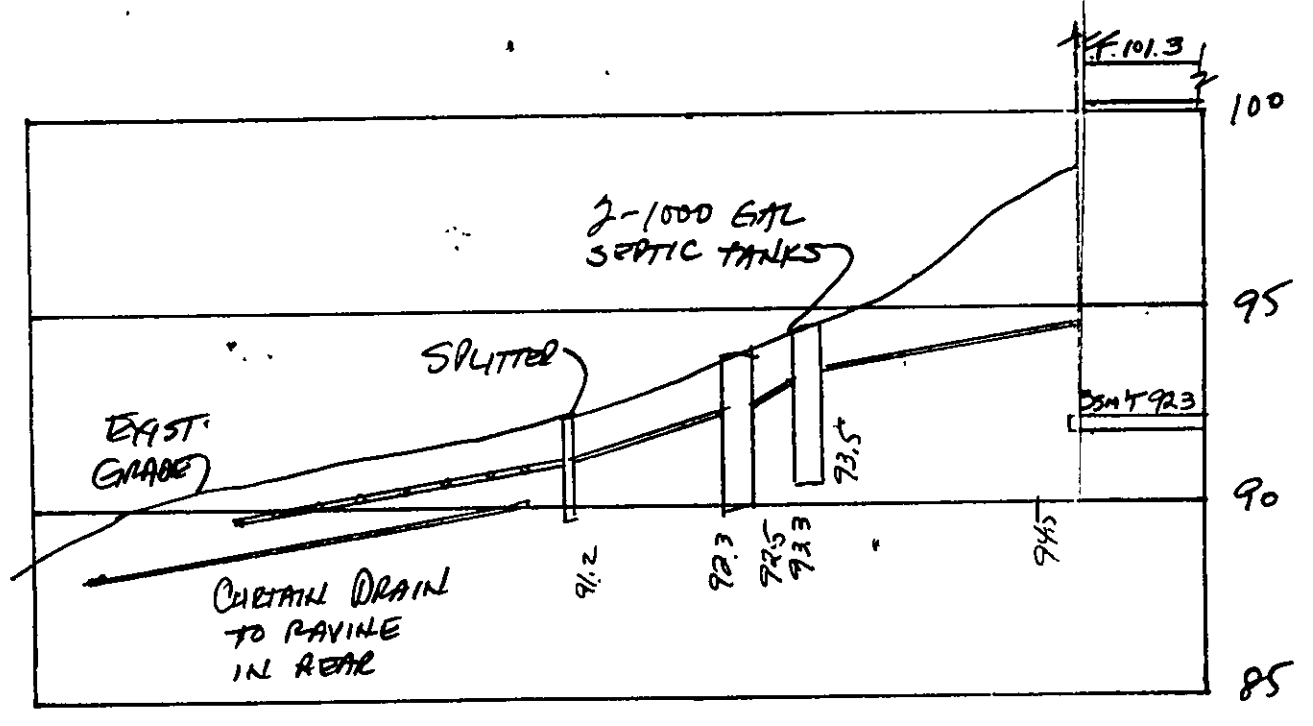
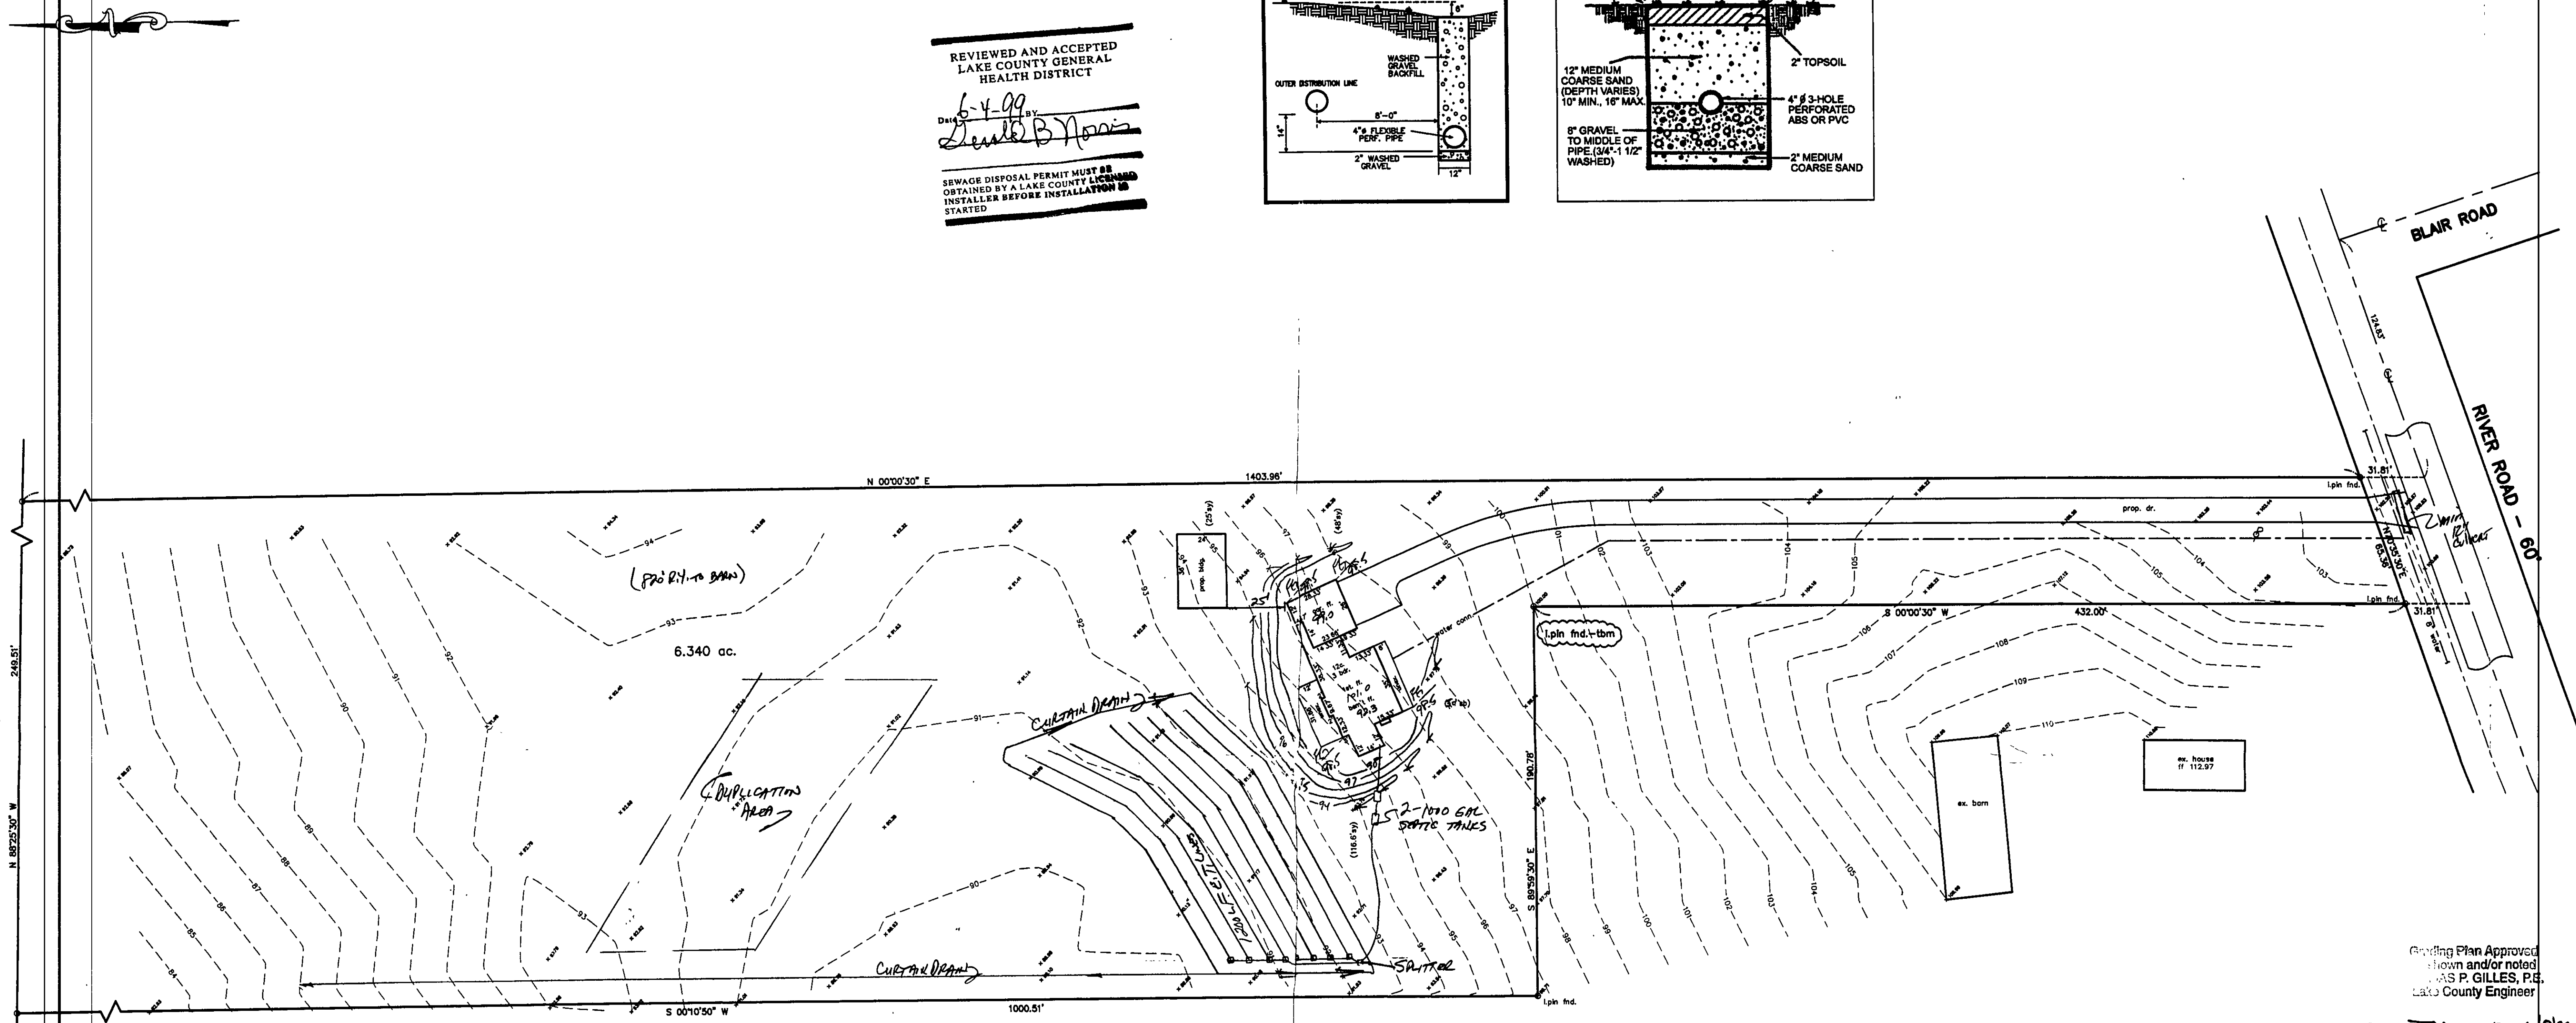
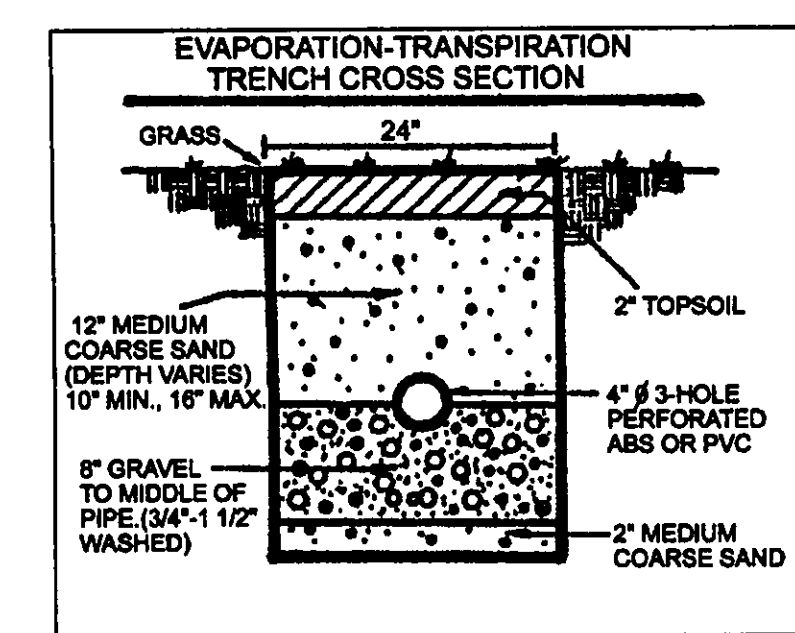


REVIEWED AND ACCEPTED
LAKE COUNTY GENERAL
HEALTH DISTRICT
6-4-99
Derek B. Norris
SEWAGE DISPOSAL PERMIT MUST BE
OBTAINED BY A LAKE COUNTY LICENSED
INSTALLER BEFORE INSTALLATION IS
STARTED

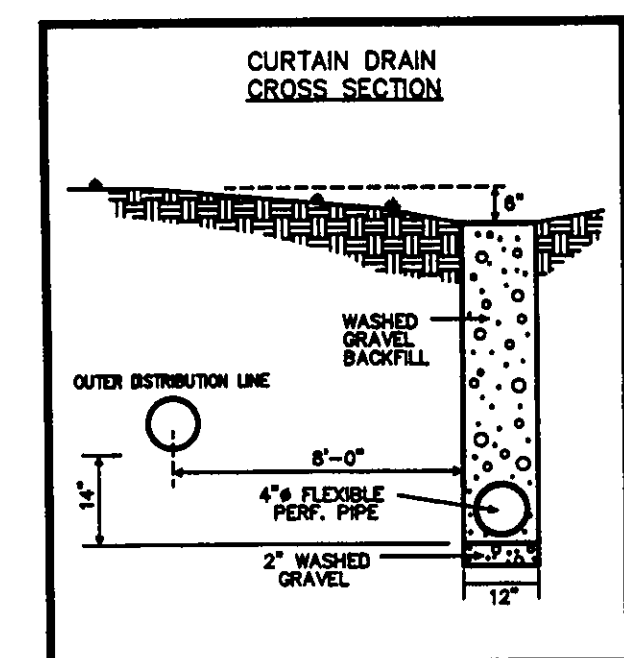


HYDRAULIC PROFILE
HORIZ 1"=40' VERT 1"=5'

TBM-IRON PIN FOUND
ELEV.=100.00

"I, the undersigned hereby certify that this topography indicated by 6", 1", or 2" contours, and elevations shown hereon represent an actual field survey made by me on the 24th day of APRIL, 1999, and that the elevations were taken at appropriate intervals and that as of that date they existed as indicated hereon."

Name: *Harry P. Jones* #6343
Reg. No.

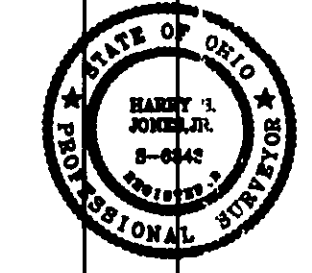

REV NO.	DESCRIPTION	DATE	BY	CHK'D
1	REVIEWED HOUSE & SEPTIC	6-2-99	HT	179

BABCOCK, JONES AND ASSOCIATES, INC
CIVIL ENGINEERS - SURVEYORS - LAND PLANNERS
PAINESVILLE OHIO 44077

DATE 4/25/99
DESIGN BY H.J.
DRAWN BY T.R.
APPROVED BY H.J.

SITE PLAN
FOR
MR. HERZOG
PERRY TOWNSHIP
LAKE COUNTY

SCALE: 1"=40'
JOB NO 99-113
SHEET 1 OF 1