

PEERY TOWNSHIP, LAKE
COUNTY, OHIO

for: Mary A. Alver 557-6962

CLIENT	NAME
<u>376 Park Lane</u>	<u>Indianapolis</u>
<u>ADDRESS</u>	<u>CITY</u>
<u>STREET</u>	<u>ZIP</u>

LEGEND	
SANITARY MANHOLE	—●—
STORM MANHOLE	—●—
INLET OR CATCH BASIN	—■—
HYDRANT	—◇—
EXISTING CONTOURS	—
PROPOSED CONTOURS	—
EXIST. ELEV.	100.0
	PROG. ELEV.
	100.0

LEGEND	
WATER VALVE (GAS)	—●—
WATER METER (GAS)	—■—
AS BUILT ELEVATION	100.0
INDICATES DIRECTION OF SURFACE DRAINAGE	↑

ALL BOUNDARY DATA SHOWN WAS OBTAINED FROM (DEEDS, RECORDED
SUBDIVISION PLAT OR OTHER PUBLIC RECORDS)
LOCATIONS AS SHOWN OF ADJACENT WELLS AND SEPTIC TANKS OBTAINED FROM
LAKE COUNTY HEALTH DEPARTMENT.

THIS PLAY WAS PREPARED BY ME, AND IS CORRECT TO THE BEST OF MY KNOWLEDGE AND BELIEF.

NAME	SURVEYOR	REGISTRATION	NO.
	W. J. Mc	# 6343	

[illegible]

NO. OF BEDROOMS	WATER MAIN SIZE	LOCATION
DIMENSIONS	5/8" SEWER SIZE	5" GR. LOC.
BEARINGS	SAN. INH. CAST	ELEV. INV. ELEV.
TO THE NEAREST STREET	SAN. CORR. SIZE	LOC. DEPTH
SLURFLOT NO. PARCEL NO.	STORM SEWER SIZE	5" GR. LOC.
SLURFLOUNDING OWNERS	STORM INH. CAST	ELEV. INV. ELEV.
BUILD. DIMENSIONS FIN. GR.	PAV'T TYPE	GRAD. ELEV.
BUILD. TIES P.L.T. GRADES	CAST IRON CURBS	
AIRCON TYPE WIDTH THICKNESS	S&C LINE LOC.	SIZE PRESSURE
SIDEWALK TYPE WIDTH THICKNESS	SEWAGE TANK	LOCATION & DUPLICATION
CULVERT TYPE DIA. LENGTH	WELL LOCATION	
ROCK OUTCROPPINGS	ISOLATION RADIUS FROM WELL	

REVISIONS	PLAN PREPARED BY
-----------	------------------

BABCOCK • JONES & ASSOCIATES, INC.

110

PHONE NO.
357-181


91-095-1

100

I, HEREBY CERTIFY THAT THE CIRCLED GRADES ARE EXISTING
FINISH GRADES CHECKED IN THE FIELD ON _____, 19 _____

REGISTERED SURVEYOR	REG. NO.

B.M. TOP I.P. S/W CORNER, ELEV. = 100.00

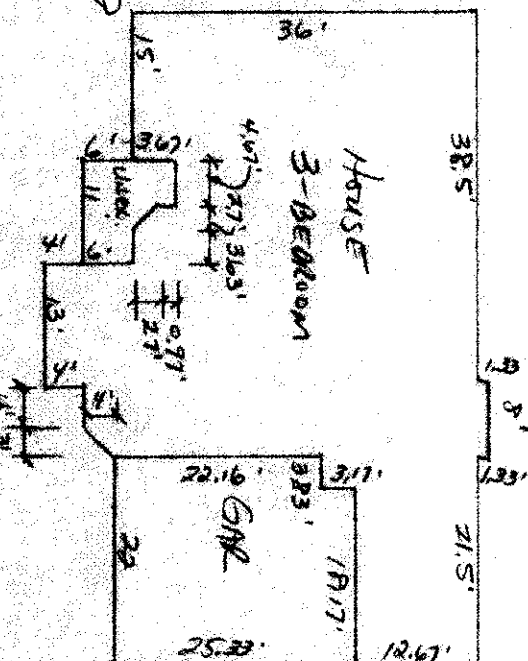

Reviewed and Accepted _____

LAKE COUNTY GENERAL HEALTH DISTRICT

Date 11/1/91

2) certain claim may
not discharge off-ls

JOEL LUDIA R. S. M. P. H.
Health Commissioner




2) keep records 18-24 yrs

BY Nancy Melino

- A. To be brought to finished grade
 1. Septic tank manhole covers
 2. Splitter box cover
 3. Distribution box cover
 4. _____
- B. No footer drains or downspouts to be discharged into septic tanks
- C. All waste water to be discharged into septic tanks

SEWAGE DISPOSAL PERMIT MUST BE OBTAINED BY A LAKE COUNTY LICENSED INSTALLER BEFORE INSTALLATION IS STARTED.

**LOW YIELD WATER
FIXTURES REQUIRED
ON ALL:
Shower Head
Toilet**

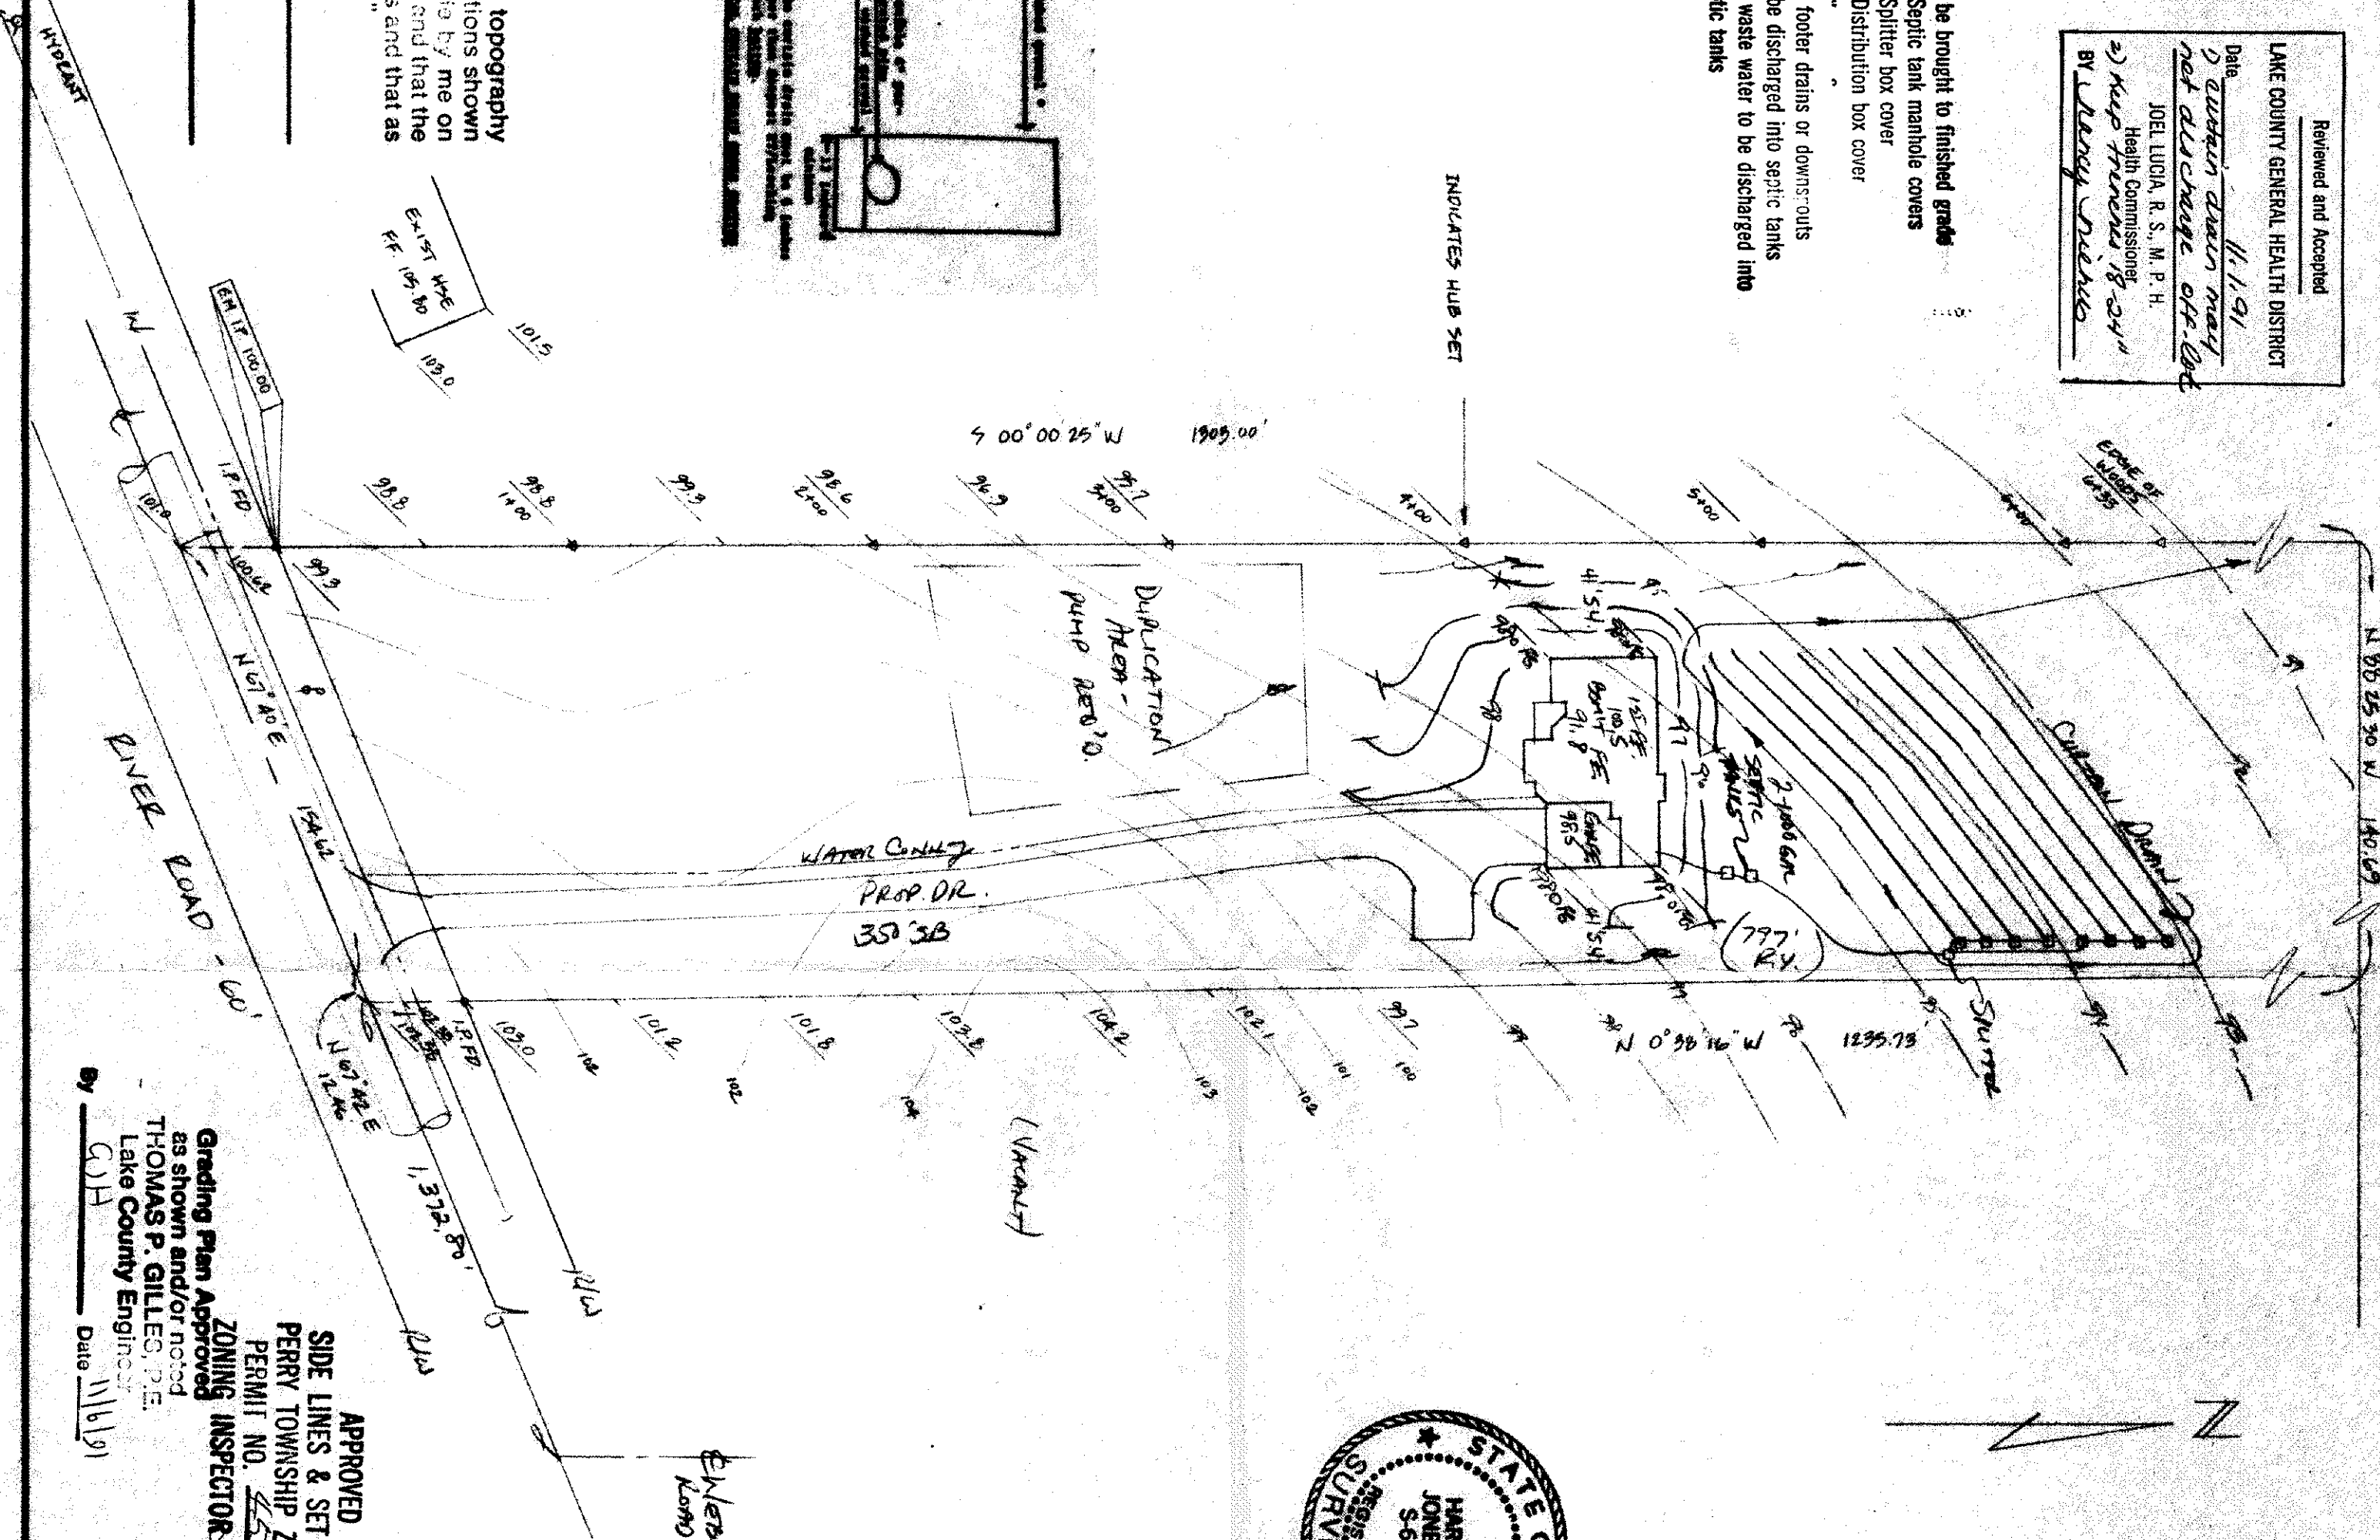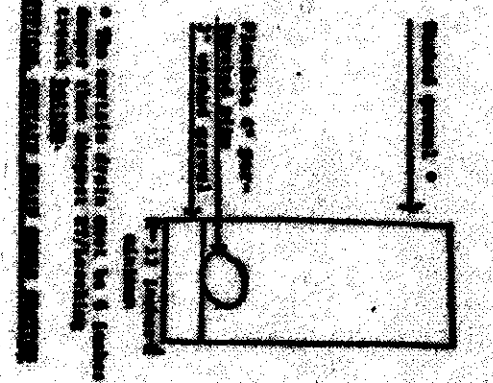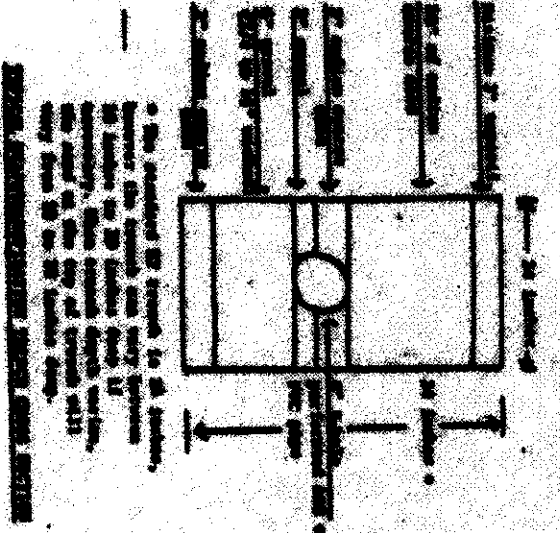

"I, the undersigned hereby certify that this topography indicated by 6", 1" or 2" contours, and elevations shown hereon represent an actual field survey made by me on the 14th day of May, 1991, and that the elevations were taken at appropriate intervals and that as of that date they existed as indicated hereon."

Reg. No.	PL 343
Name	

Grading Plan Approved
as shown and/or noted
THOMAS P. GILLES, P.E.
Lake County Engineer
CCH
Date 11/6/91